4669380610

IREDELL COUNTY HEALTH DEPARTMENT

STATESVILLE 704-878-5305 3605.00 MOORESVILLE 704-664-5281

IMPROVEMENT PERMIT / AUTHORIZATION TO CONSTRUCT / OPERATION PERMIT / EXISTING SYSTEM INSPECTION

PERMIT# 16 0072 PIN# ~~4669380548~~ Jim DATE 3-19-2010

OWNER OR APPLICANT Jim Estes (Weeked Squirell LLC) PHONE: Business 704-641-0325 Home

ADDRESS 749 Shinnville Rd. Mooresville, NC 28115

LOCATION Hwy 115 N TR Shinnville Rd on left (right before Brawley Rd)

SUBDIVISION BLOCK / SECTION LOT LOT AREA .73 Acre SITE CLASS. PS DESIGN FLOW 240 gpd L.T.A.R. .3-.35

Septic Tank: Existing Gallons: STB Date

Pump Tank: Gallons: PT Date

Pump Make: Model Serial No.

Nitrification Field: No Fields 1 Square Feet 360 Linear Feet 120'

No Lines 2 Trench Width 36" Max Trench Bottom Depth 36" Gravel Depth N/A

☐ New System ☐ Repair ☒ Expansion System Type: I (II) III IV V VI

System Description: Gravity-25% Reduction

Repair System Description: Pump- Panel Blk

Maintenance Agreement Required: ☐ Yes ☒ No

☒ House/Mod. Home ☐ Mobile Home ☐ Business ☐ Other

No. Bedrooms 2 No. Persons No. Employees

Water Supply: ☒ Individual (Shared with lot next door) ☐ Public ☐ Community


☐ Gravity ☐ Pressure ☒ Slab ☐ Crawl Space ☐ Basement w/plumbing ☐ Basement wo/plumbing

Add


Comments:/Conditions: Existing line - 80 FT
Add 2-lines, 120 FT total to
Upgrade to 2 Bedroom Dwelling.

Comments:/Conditions:

INITIAL SITE SKETCH Scale 1:50

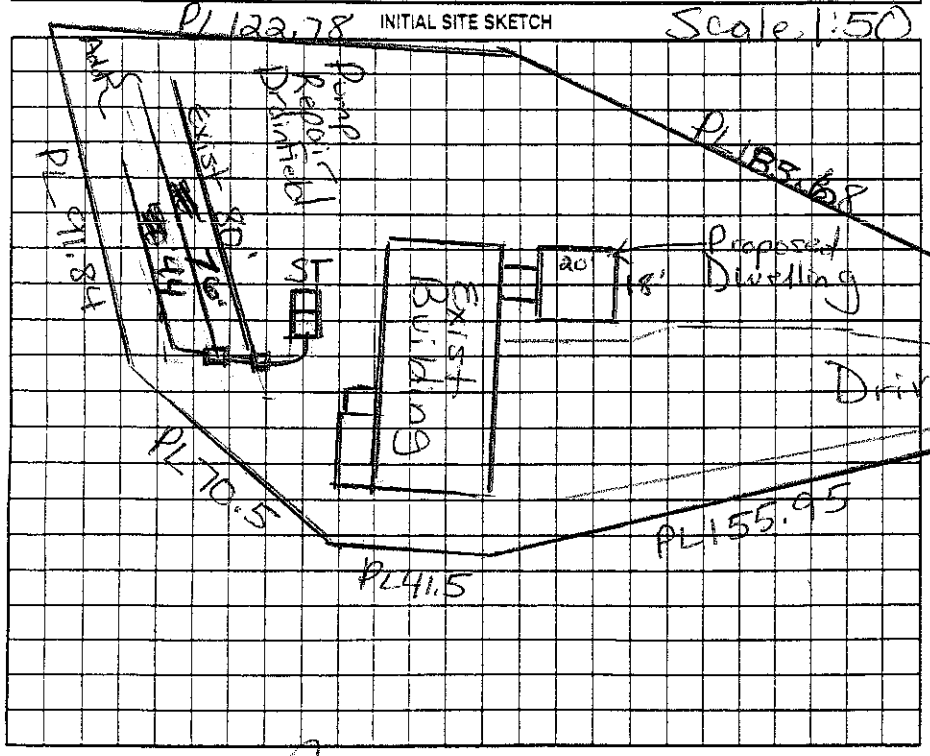

AS BUILT SKETCH

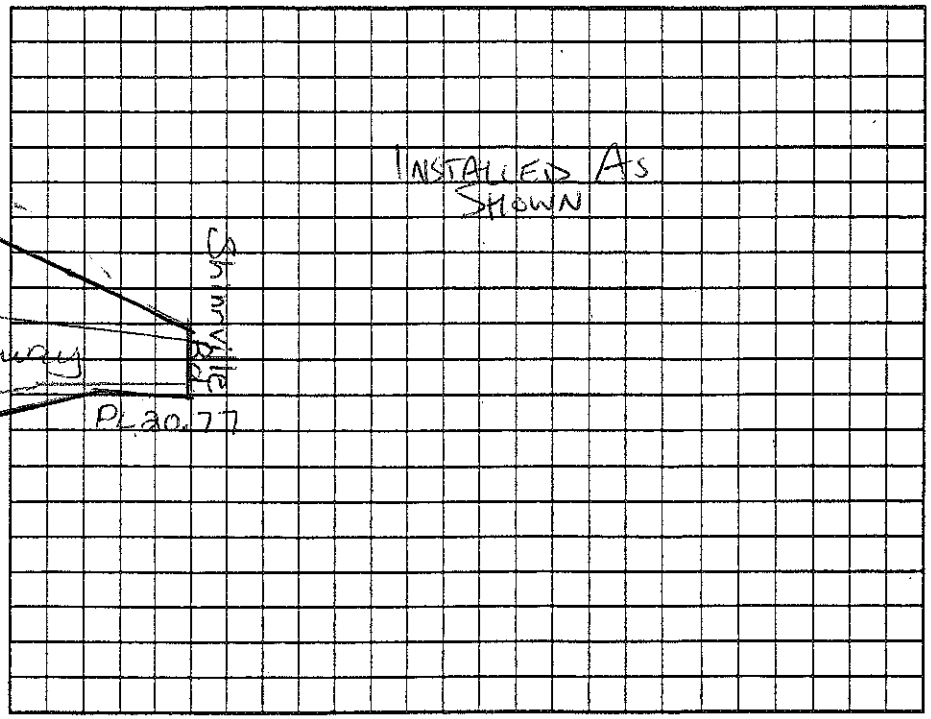

Permit can be suspended or revoked if any false information is supplied toward securing the permit/any unauthorized changes are made to the site/any unauthorized changes are made in the installation of the system. Improvement Permit with plat valid without expiration ☐ Improvement Permit with site plan valid for sixty months ☐ Authorization to Construct is valid for a period equal to that of Improvement Permit – not to exceed sixty months.

Signed: date 5-11-10 Installed by: Rogers Soil & Env.

Improvement Permit by: Maria H. Gibson REHS date 3/19/2010 Operation Permit by: REHS date 6-28-12

Authorization to Construct by: Maria H. Gibson REHS date 3/19/2010 Existing System Inspection by: date

HEALTH DEPT. COPY: WHITE OWNER COPY (FINAL): YELLOW OWNER COPY (INITIAL): PINK

IREDELL COUNTY HEALTH DEPARTMENT

STATESVILLE 704-878-5305 $100.00 Paid MOORESVILLE 704-664-5281

IMPROVEMENT PERMIT / AUTHORIZATION TO CONSTRUCT / OPERATION PERMIT / EXISTING SYSTEM INSPECTION

PERMIT# 113640 / ~~13348~~ PIN# 4669 38 05 33 DATE 3/15/06

OWNER OR APPLICANT Jim Estes PHONE: Business 704 489 9497 Home

ADDRESS Po Box 367 Terrell NC 28682

LOCATION 115 N, TR Shinnville, on Lt. #749

SUBDIVISION BLOCK / SECTION LOT LOT AREA 1.344Ac SITE CLASS. PS DESIGN FLOW 480/100 L.T.A.R. 0.35

Septic Tank: 1000 Gallons; STR 1572 Date 10/10/05 ☒ New System ☐ Repair ☐ Expansion System Type: I II III IV V VI ☒ House/Mod. Home No. Bedrooms 4 Water Supply: ☒ Individual

2nd Septic Tank: 1000 Gallons; one Line @ 80' 25% Red. System Description: 25% Reduction ☐ Mobile Home No. Persons ☐ Public

Pump Make: Model Serial No. Repair System Description: Pump Panel Block ☐ Business No. Employees ☐ Community


Nitrification Field: No Fields 1 Square Feet 1028 Linear Feet 343 Maintenance Agreement Required: ☐ Yes ☐ No ☐ Other

No Lines 4 Trench Width 36" Max Trench Bottom Depth 36" Gravel Depth — ☒ Gravity ☐ Pressure ☐ Slab ☐ Crawl Space ☐ Basement w/plumbing ☐ Basement wo/plumbing


Comments/Conditions:

Comments/Conditions:

INITIAL SITE SKETCH

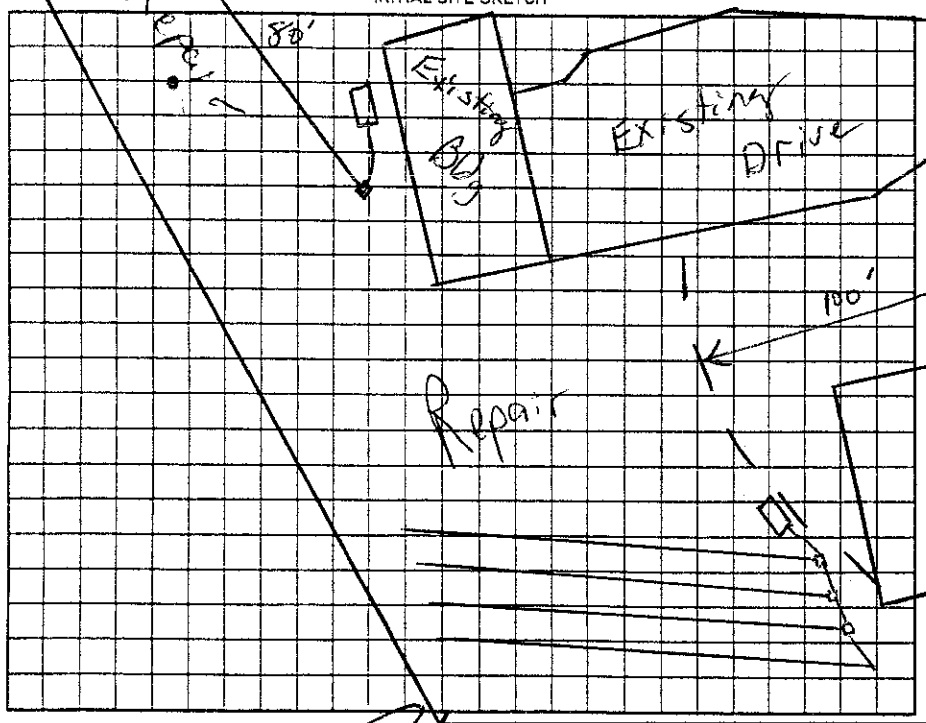

AS BUILT SKETCH

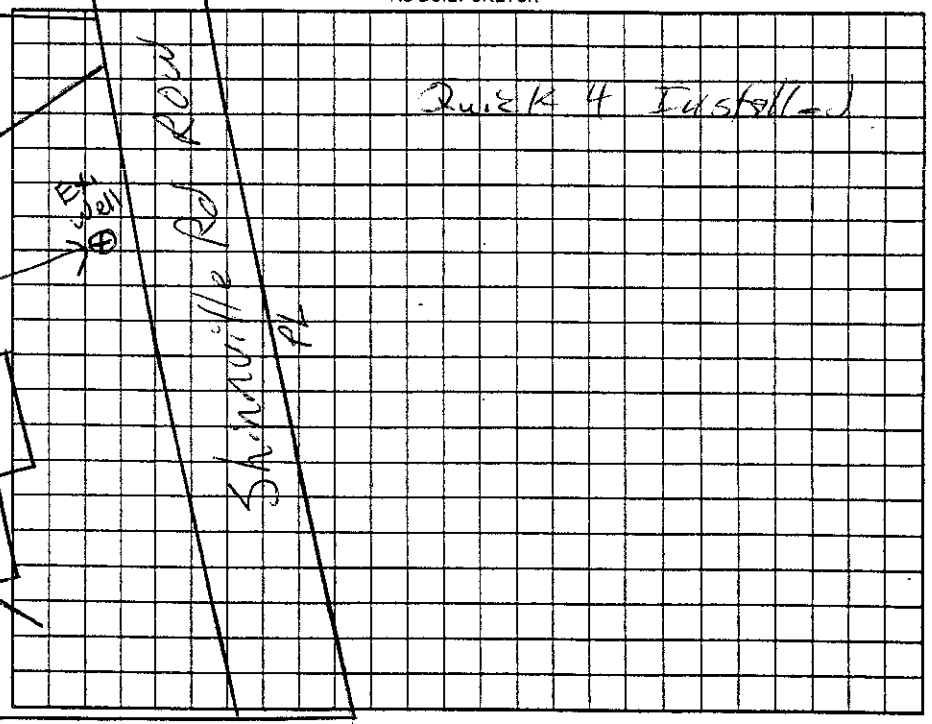

Permit can be suspended or revoked if any false information is supplied toward securing the permit/any unauthorized changes are made to the site/any unauthorized changes are made in the installation of the system. Improvement Permit with plat valid without expiration ☐ Improvement Permit with site plan valid for sixty months ☒ Authorization to Construct is valid for a period equal to that of Improvement Permit – not to exceed sixty months.

Signed: date 5-15-06 Installed by: Tommy Frye

Improvement Permit by: RS date 3/15/06 Operation Permit by: RS date 5/25/06

Authorization to Construct by: RS date 3/15/06 Existing System Inspection by: date

HEALTH DEPT. COPY: WHITE OWNER COPY (FINAL): YELLOW OWNER COPY (INITIAL): PINK