IREDELL COUNTY HEALTH DEPARTMENT

STATESVILLE 704-878-5305 — 150.00 Paid — MOORESVILLE 704-664-5281

IMPROVEMENT PERMIT / AUTHORIZATION TO CONSTRUCT / OPERATION PERMIT / EXISTING SYSTEM INSPECTION

PERMIT# 113639 PIN# ~~4669-38-0558.001~~ 4669381707 DATE 6/18/04

OWNER OR CONTRACTOR Stanley Lizgus Kass PHONE: Business 704 664-5935 Home

ADDRESS 755 B Shinnville Rd Mooresville NC 28115

LOCATION 115N, TR Shinnville Rd, on Lt #755

SUBDIVISION BLOCK / SECTION LOT LOT AREA 2.10 ac SITE CLASS. PS DESIGN FLOW 340 L.T.A.R. 0.35

Septic Tank: Existing Gallons; STB Date

Pump Tank: Gallons; PT Date

Pump Make: Model Serial No.

Nitrification Field: No Fields 1 Square Feet 690 Linear Feet 230

No Lines 3 or 4 Trench Width 36" Max Trench Bottom Depth 36" Gravel Depth 12"

☒ New System ☐ Repair System Type: I, II, III, IV, V, VI

System Description: Gravity Conventional

Repair System Description: 40% Reduction

Maintenance Agreement Required: ☐ Yes ☒ No

☒ House/Mod. Home No. Bedrooms 2

☐ Mobile Home No. Bathrooms 1.5

☐ Business No. Employees

☐ Other


☐ Slab ☒ Crawl Space ☐ Basement w/plumbing ☐ Basement wo/plumbing

Water Supply: ☒ Individual ☐ Public ☐ Community


Comments:/Conditions: 305'

Comments:/Conditions:

INITIAL SITE SKETCH

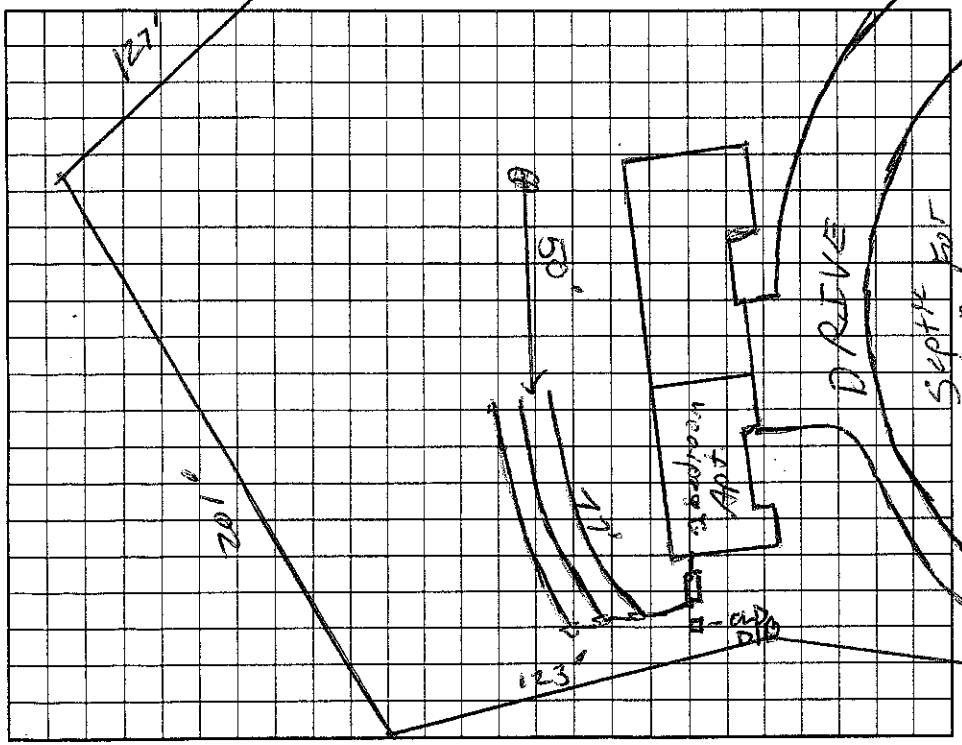

AS BUILT SKETCH

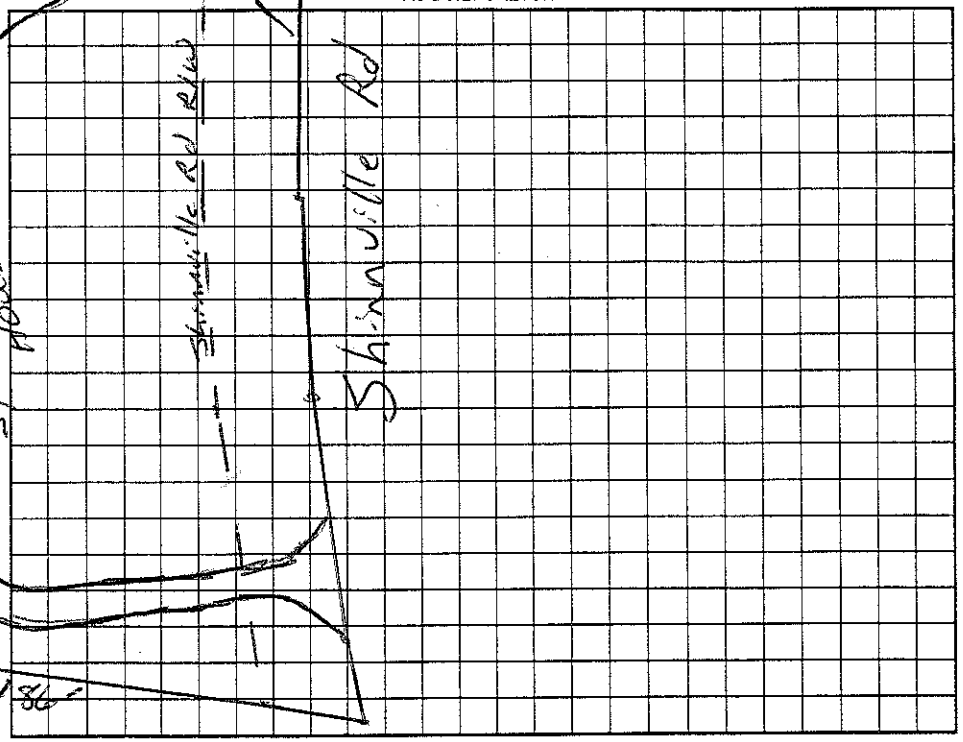

Permit can be suspended or revoked if any false information is supplied toward securing the permit/any unauthorized changes are made to the site/any unauthorized changes are made in the installation of the system. Improvement Permit with plat valid without expiration. Improvement Permit with site plan valid for sixty months. Authorization to Construct is valid for a period equal to that of Improvement Permit – not to exceed sixty months.

Signed: Denise D Lizgus Kass date 10/22/04 Installed by: Orbison & Sons

Improvement Permit by: RS date 6/18/04 Operation Permit by: Wesley Parks RS. date 7/28/04

Authorization to Construct by: RS date 6/18/04 Existing System Inspection by: date

HEALTH DEPT. COPY: WHITE OWNER COPY (FINAL): YELLOW OWNER COPY (INITIAL): PINK