IREDELL COUNTY HEALTH DEPARTMENT

STATESVILLE 704-878-5305 MOORESVILLE 704-664-5281

(10.00)

IMPROVEMENT PERMIT / AUTHORIZATION TO CONSTRUCT / OPERATION PERMIT / EXISTING SYSTEM INSPECTION

PERMIT# 79854 PIN# 4669-40-2319 DATE 4/10/99

OWNER OR CONTRACTOR GINGER GIBBY PHONE: Business Home

ADDRESS 203 POND VIEW LN MOORESVILLE NC 28115

LOCATION 21 N - TR STATESVILLE. TR POND VIEW - ON LT BEHIND

SUBDIVISION BLOCK / SECTION LOT LOT AREA .84AC SITE CLASS. PS DESIGN FLOW 360 L.T.A.R. .3

Septic Tank: 1000 Gallons; STB 774 Date 12/16/98

Pump Tank: Gallons; PT Date

Pump Make: Model Serial No.

Nitrification Field: No Fields 1 Square Feet 1200 Linear Feet 400

No Lines 4@100' Trench Width 36" Max Trench Bottom Depth 36" Gravel Depth 12"

~~New System~~ ☐ Repair System Type: I, II, III, IV, V, VI

System Description: GRAVITY CONVENTIONAL

Repair System Description: CHAMBERS

Maintenance Agreement Required: ☐ Yes ☑ No

~~House/Mod. Home~~ No. Bedrooms 3

☐ Mobile Home No. Bathrooms 2

☐ Business No. Employees

☐ Other

☐ Slab ☑ Crawl Space ☐ Basement w/plumbing ☐ Basement wo/plumbing

Water Supply: ~~Individual~~ ☐ Public ☐ Community


Comments:/Conditions:

FLIPPED SYSTEM AND REPAIR. / INSTALLED ON CONTOURS AS SHOWN


Comments:/Conditions:

NO CHANGES MADE

INITIAL SITE SKETCH 1"=60'

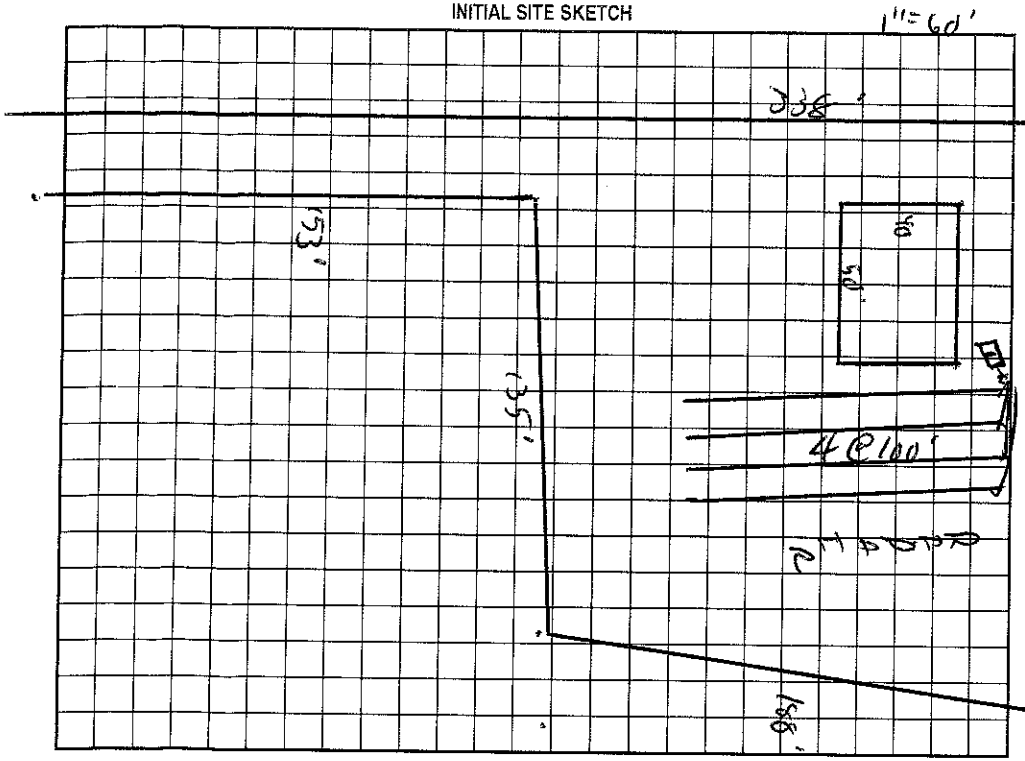

AS BUILT SKETCH

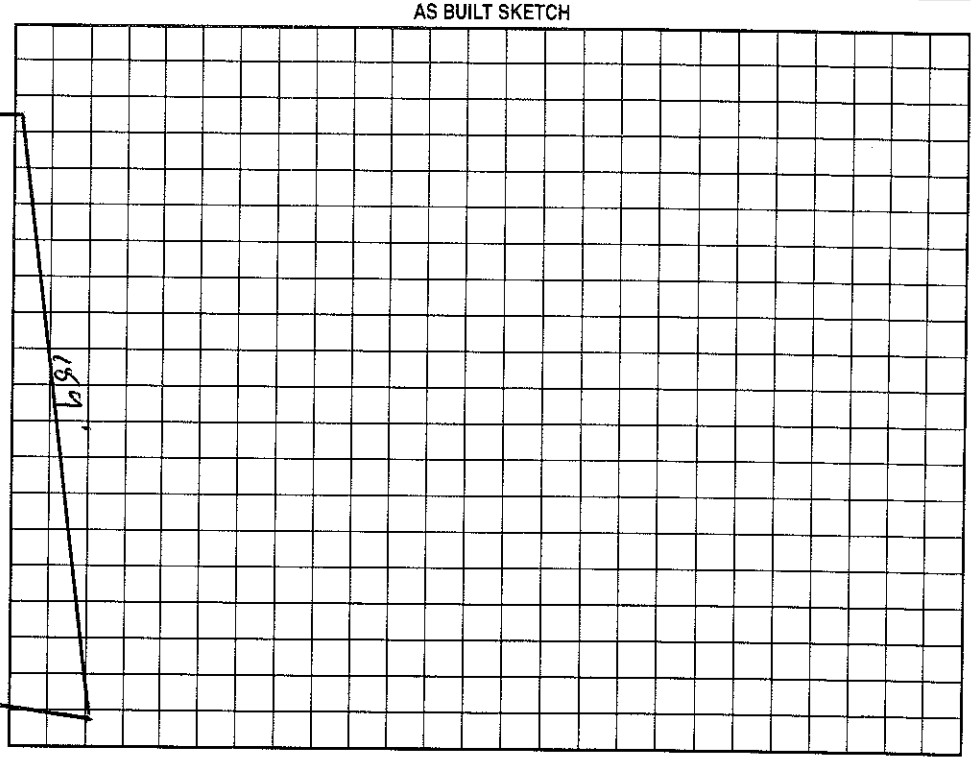

Permit can be suspended or revoked if any false information is supplied toward securing the permit/any unauthorized changes are made to the site/any unauthorized changes are made in the installation of the system. Improvement Permit with plat valid without expiration. Improvement Permit with site plan valid for sixty months. Authorization to Construct is valid for a period equal to that of Improvement Permit – not to exceed sixty months.

Signed: Ginger Gibby date 4-14-99 Installed by: TIM AMMONS

Improvement Permit by: C. [signature] date 4/12/99 Operation Permit by: C. [signature] KS date 7/7/99

Authorization to Construct by: C. [signature] date 4/12/99 Existing System Inspection by: date

HEALTH DEPT. COPY: WHITE OWNER COPY (FINAL): YELLOW OWNER COPY (INITIAL): PINK