IREDELL COUNTY HEALTH DEPARTMENT

Authorization to Construct

STATESVILLE 704-878-5305 MOORESVILLE 704-664-5281

4669 42 5652

IMPROVEMENT PERMIT / ~~CERTIFICATE OF COMPLETION~~ / OPERATION PERMIT / EXISTING SYSTEM INSPECTION

PROPERTY DESCRIPTION NO. 070783 DATE 12/8/97 TAX MAP NO. 4669-42-5662 Watershed: ☐ Yes ☒ No

OWNER OR CONTRACTOR RICK REN PHONE: Business 896-8122 Home

ADDRESS 150 BERACAH RD. MOORESVILLE, NC. 28115

LOCATION SHINNVILLE RD. TR COPPERHEAD DR. AT END

SUBDIVISION N/A BLOCK / SECTION N/A LOT N/A LOT AREA 29.35AC SITE CLASS. PS DESIGN FLOW ~~360~~ 360 Aws L.T.A.R. .25

Septic Tank: 1000 Gallons; STB 312 Date 8/8/97

Pump Tank: Gallons; PT Date

Pump Make: Model 1440 ~~Ace~~ Serial No. (480) ~~Ace~~

Nitrification Field: No Fields 1 Square Feet ~~1920~~ Linear Feet ~~640~~

No Lines 4 Trench Width 36" Max Trench Bottom Depth 36" Gravel Depth 12"

☒ New System ☐ Repair System Type: I, (II), III, IV, V, VI

System Description: Gravity Conventional

Repair System Description: None

Maintenance Agreement Required: ☐ Yes ☒ No


☒ House/Mod. Home ☐ Mobile Home ☐ Business ☐ Other

No. Bedrooms 4 No. Bathrooms 2.5 No. Employees

☐ Slab ☒ Crawl Space ☐ Basement w/plumbing ☐ Basement wo/plumbing


Water Supply: ☒ Individual ☐ Community ☐ Public

Comments:

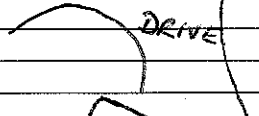


Comments:

INITIAL SITE SKETCH

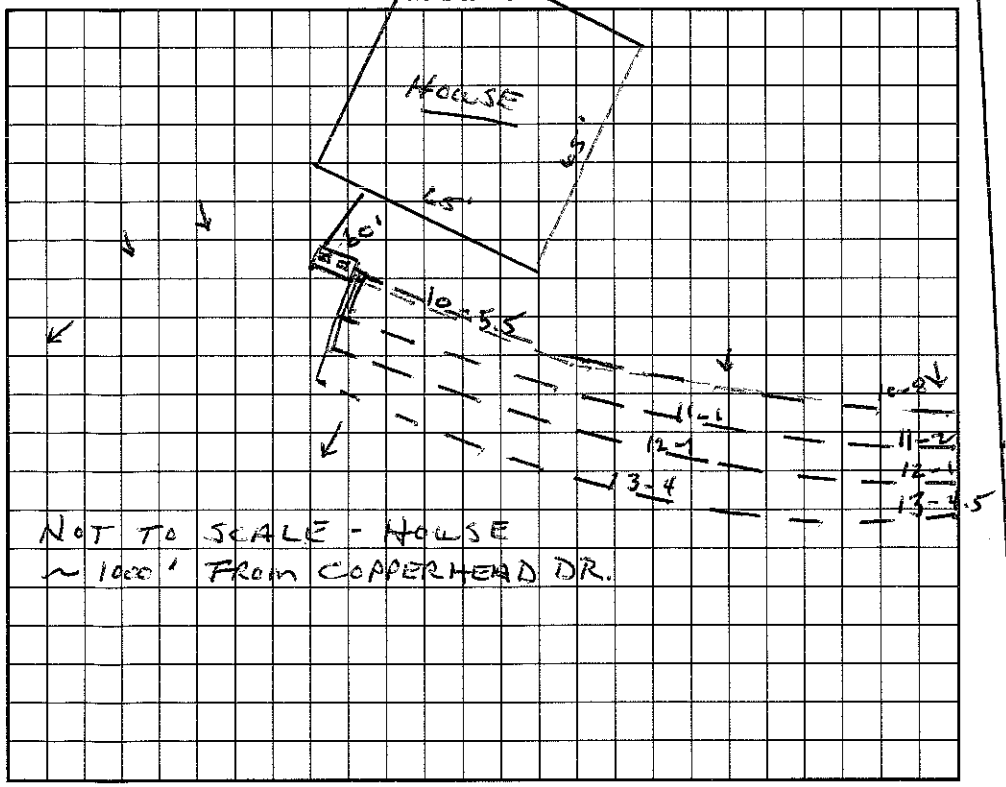

AS BUILT SKETCH

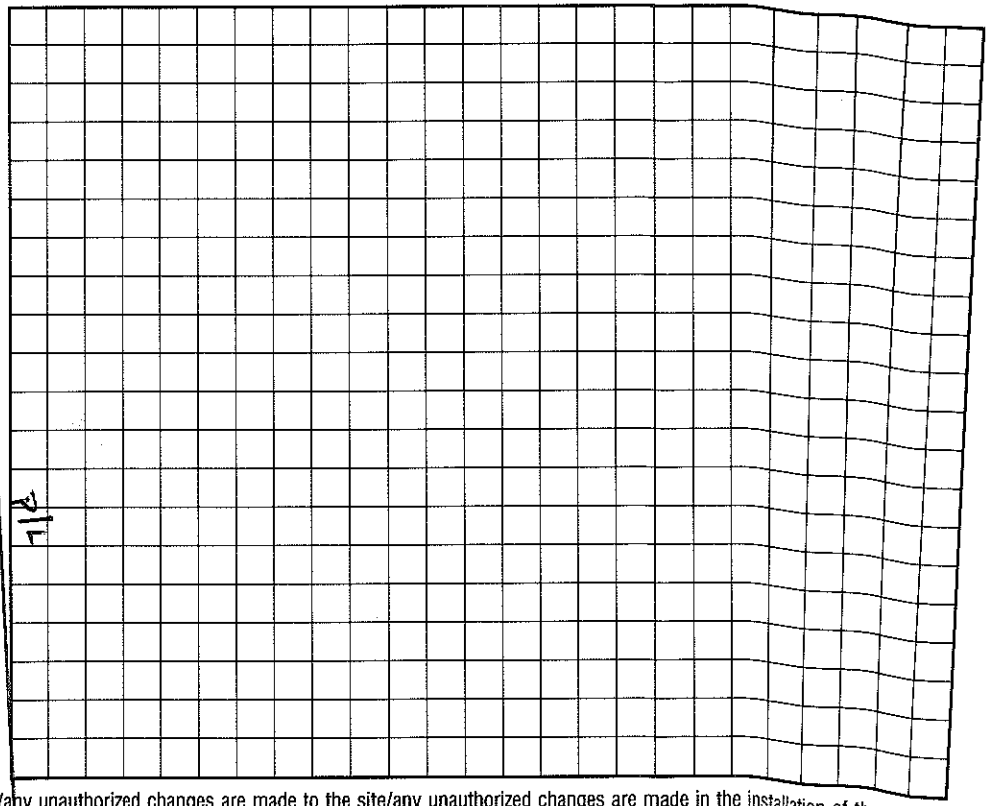

I understand that this permit can be suspended or revoked if any false information is supplied toward securing the permit/any unauthorized changes are made to the site/any unauthorized changes are made in the installation of the system. Improvement Permit is valid for 60 months from date of issuance.

Signed: * Rick Ren

Improvement Permit by: Wesley Sparks R.S. date 12/8/97

~~Existing System Inspection by:~~ Wesley Sparks R.S. date 12/8/97

Installed by: F.J. Erwin

Certificate of Completion by: Wesley Sparks R.S. date 10/1/99

Operation Permit by: Wesley Sparks R.S. date 10/1/99

HEALTH DEPT. COPY: WHITE INSPECTION COPY (FINAL): GREEN OWNER COPY (FINAL): YELLOW INSPECTION COPY (INITIAL): PINK OWNER COPY (INITIAL): GOLD