4669583147

IREDELL COUNTY HEALTH DEPARTMENT

STATESVILLE 704-878-5305 MOORESVILLE 704-664-5281

IMPROVEMENT PERMIT / CERTIFICATE OF COMPLETION / OPERATION PERMIT / EXISTING SYSTEM INSPECTION

PROPERTY DESCRIPTION NO. 20407 DATE 3/27/95 TAX MAP NO. 4H - B - Pt of 53 Watershed: ☐ Yes ☒ No

OWNER OR CONTRACTOR J Larry Robinson PHONE: Business ______ Home 664-4604

ADDRESS PO Box 731 Mooresville, NC 28115

LOCATION Winthrow Creek Rd. - Shinnville Rd TR at store ~ 3/10 mile on (L) before bridge

SUBDIVISION N/A BLOCK / SECTION ______ LOT ______ LOT AREA ~ 3 AC SITE CLASS. P DESIGN FLOW 480 L.T.A.R. .35

Septic Tank: 1000 Gallons; STB 794 Date 11/6/95

Pump Tank: ______ Gallons; PT ______ Date ______

Pump Make: ______ Model ______ Serial No. ______

Nitrification Field: No Fields 1 Square Feet 1371 Linear Feet 457

No Lines X 4 ... Trench Width 36" Max Trench Bottom Depth 36" Gravel Depth 12"

☒ New System ☐ Repair System Type: I, (II), III, IV, V, VI

System Description: CONV

Repair System Description: SAME

Maintenance Agreement Required: ☐ Yes ☒ No

☐ House/Mod. Home No. Bedrooms 4

☐ Mobile Home No. Bathrooms 3

☐ Business No. Employees ______

☐ Other ______

☐ Slab ☐ Crawl Space ☒ Basement w/plumbing ☐ Basement wo/plumbing

Water Supply: ☒ Individual ☐ Community ☐ Public


Comments:

Comments:

INITIAL SITE SKETCH

AS BUILT SKETCH

WINTHROW CRK RD.

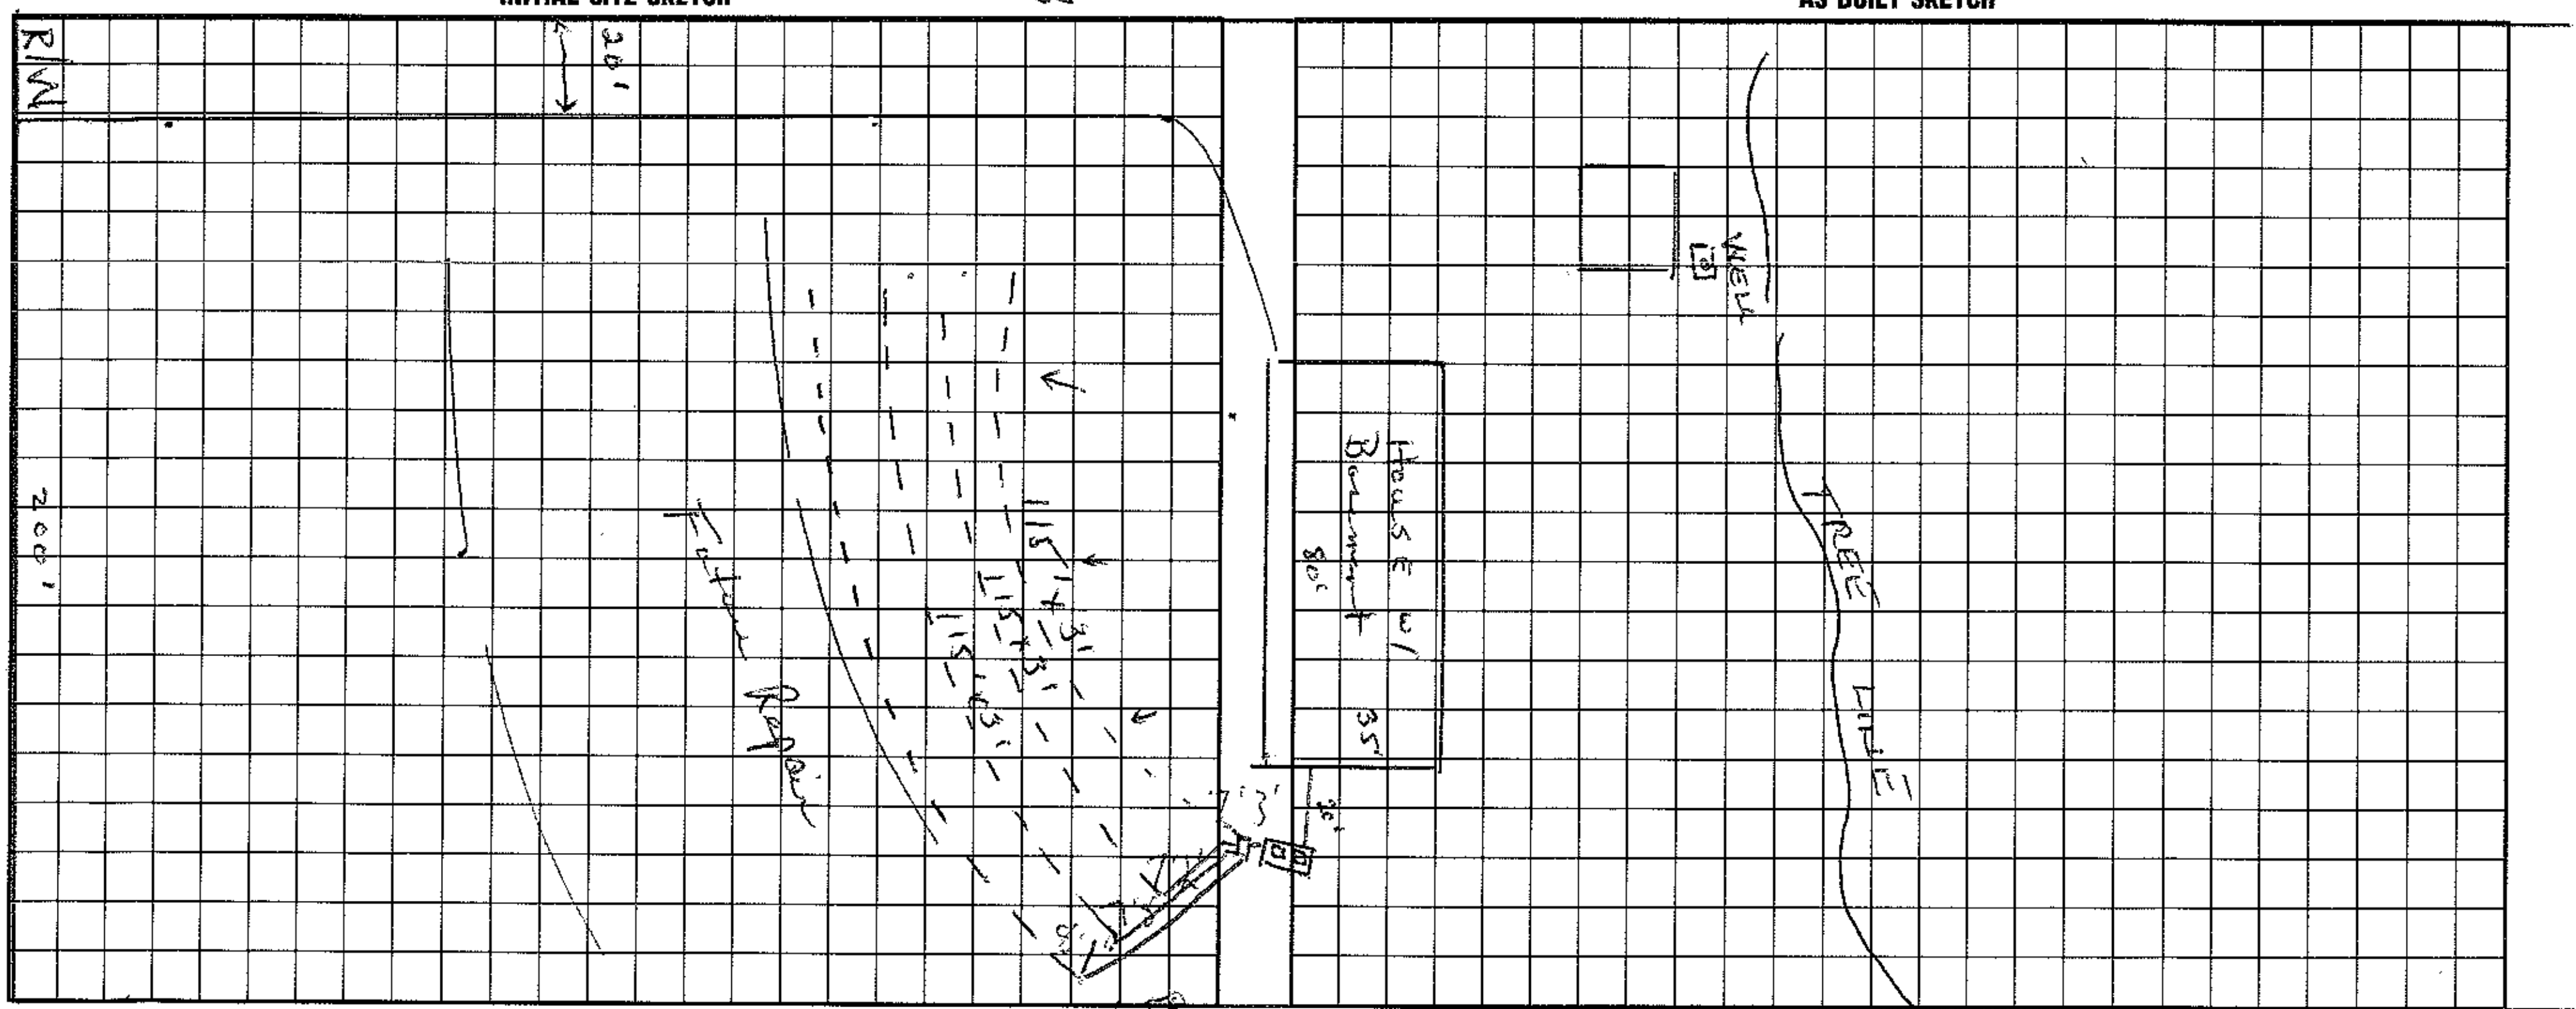

I understand that this permit can be suspended or revoked if any false information is supplied toward securing the permit/any unauthorized changes are made to the site/any unauthorized changes are made in the installation of the system. Improvement Permit is valid for 60 months from date of issuance.

Signed: Carol K Robinson

Improvement Permit by: Wesley Sparks R.S. date 3/27/95

Existing System Inspection by: ______ date ______

Installed by: F J Irwin

Certificate of Completion by: Wesley Sparks R.S. date 12/11/95

Operation Permit by: Wesley Sparks R.S. date 12/11/95

HEALTH DEPT. COPY: WHITE INSPECTION COPY (FINAL): GREEN OWNER COPY (FINAL): YELLOW INSPECTION COPY (INITIAL): PINK OWNER COPY (INITIAL): GOLD