IREDELL COUNTY HEALTH DEPARTMENT

STATESVILLE 704-878-5305 MOORESVILLE 704-664-5281

IMPROVEMENT PERMIT / AUTHORIZATION TO CONSTRUCT / OPERATION PERMIT / EXISTING SYSTEM INSPECTION

PERMIT# 066739 PIN# ~~[illegible]~~ 4669587169 DATE 1/22/98

OWNER OR CONTRACTOR THOMAS T. ARCHER PHONE: Business _____ Home 392-8050

ADDRESS 18631 STATESVILLE RD CORNELIUS NC 28031

LOCATION SHINVILLE RD - TR WINTHROW CREEK - B-4 CREEK ON LT ≈ 1000 ft OFF RD

SUBDIVISION — BLOCK / SECTION — LOT — LOT AREA ~1 AC SITE CLASS. PS DESIGN FLOW 360 GPD L.T.A.R. .3 GPD/FT²

Septic Tank: 1000 Gallons; STB 794 Date 6/4/97

Pump Tank: _____ Gallons; PT _____ Date _____

Pump Make: _____ Model _____ Serial No. _____

Nitrification Field: No Fields 1 Square Feet 1200 Linear Feet 400

No Lines 4@100' Trench Width 36" Max Trench Bottom Depth 18" Gravel Depth 12"

☑ New System ☐ Repair System Type: I (II) III, IV, V, VI

System Description: GRAVITY CONVENTIONAL

Repair System Description: SAME

Maintenance Agreement Required: ☐ Yes ☑ No

☑ House/Mod. Home No. Bedrooms 3

☐ Mobile Home No. Bathrooms 3

☐ Business No. Employees _____

☐ Other _____

☐ Slab ☐ Crawl Space ☑ Basement w/plumbing ☐ Basement wo/plumbing


Water Supply: ☑ Individual ☐ Public ☐ Community

Comments:/Conditions: SYSTEM MAY BE SHIFTED DOWN HILL TO ~~[illegible]~~ ACHIEVE GRAVITY FROM BASEMENT. * SYSTEM IS TO BE KEPT SHALLOW OR WILL NOT PASS INSPECTION. ~~[illegible]~~


Comments:/Conditions: REVISED

NOT TO SCALE

INITIAL SITE SKETCH

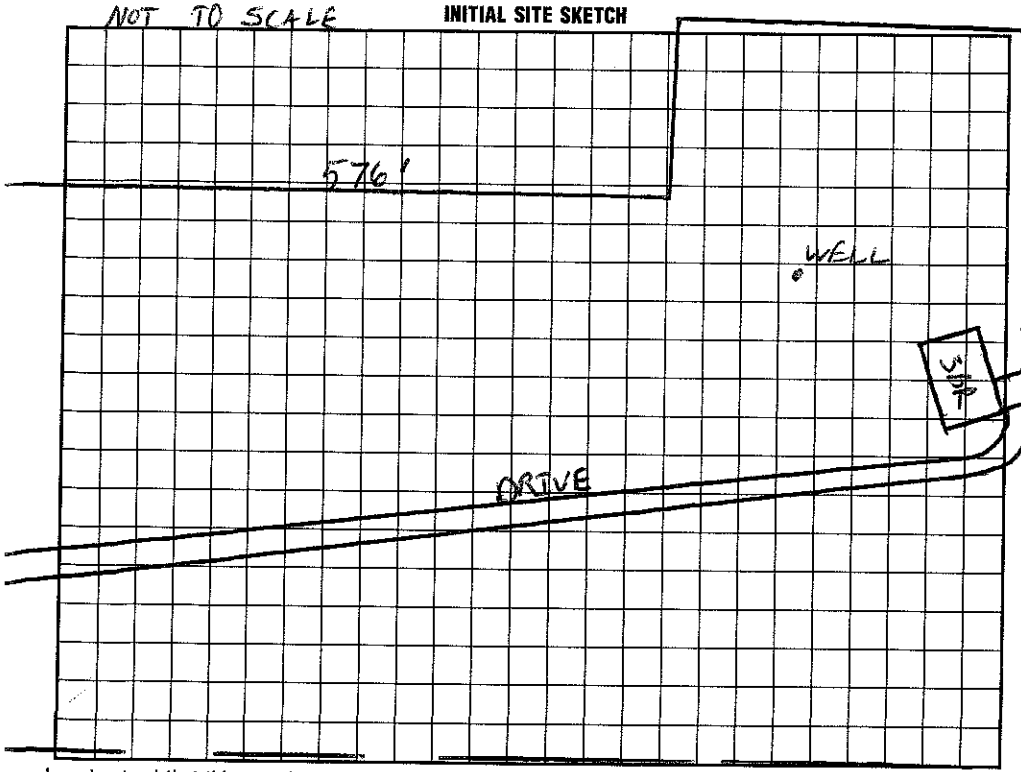

AS BUILT SKETCH

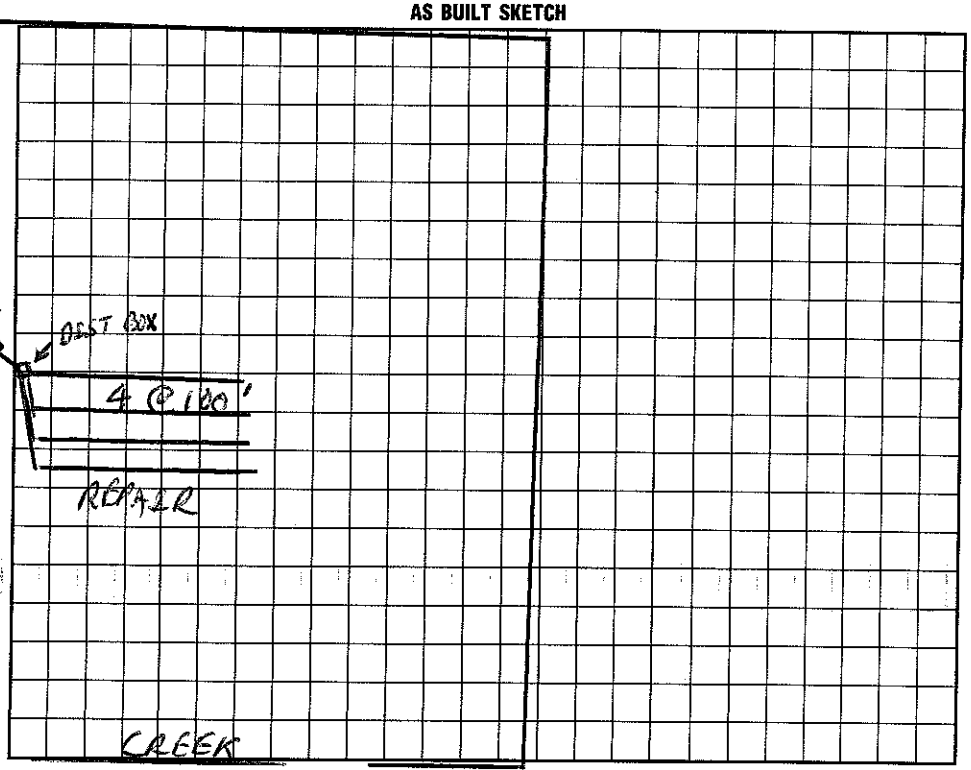

I understand that this permit can be suspended or revoked if any false information is supplied toward securing the permit/any unauthorized changes are made to the site/any unauthorized changes are made in the installation of the system. Improvement Permit with plat valid without expiration. Improvement Permit with site plan valid for sixty months. Authorization to Construct is valid for a period equal to that of Improvement Permit – not to exceed sixty months.

Signed: Ted Archer date _____ Installed by: DENVER PLUMPING

Improvement Permit by: C. Ray Zeno date 1/22/98 Operation Permit by: _____ date _____

Authorization to Construct by: C. Ray Zeno date 1/22/98 Existing System Inspection by: C. Ray Zeno date 2/26/98

HEALTH DEPT. COPY: WHITE INSPECTION COPY (FINAL): GREEN OWNER COPY (FINAL): YELLOW INSPECTION COPY (INITIAL): PINK OWNER COPY (INITIAL): GOLD