IREDELL COUNTY HEALTH DEPARTMENT

STATESVILLE 704-878-5305 | MOORESVILLE 704-664-5281

IMPROVEMENT PERMIT / AUTHORIZATION TO CONSTRUCT / OPERATION PERMIT / EXISTING SYSTEM INSPECTION

PERMIT# 118199 PIN# 4669-67-0247 DATE 2/12/04

OWNER OR CONTRACTOR Wayne Dobey PHONE: Business _____ Home 704 664 1957

ADDRESS 167 W. Plaza Dr. Mooresville NC 28117

LOCATION Shinnville Rd, TR Winthrow Creek, on Lt on Corner of Sweet briar

SUBDIVISION _____ BLOCK / SECTION _____ LOT _____ LOT AREA 0.85 AC SITE CLASS P5 DESIGN FLOW 360 L.T.A.R. 0.35 I/0.3R

Septic Tank: 1000 Gallons; STB 825 Date 4/30/04

Pump Tank: _____ Gallons; PT _____ Date _____

Pump Make: _____ Model _____ Serial No. _____

Nitrification Field: No Fields 1 Square Feet 1029 Linear Feet 343

No Lines 4@86' Trench Width 36" Max Trench Bottom Depth 24" Gravel Depth 12"

☒ New System ☐ Repair System Type: I (II) III, IV, V, VI

System Description: Gravity Conventional

Repair System Description: Pump Panel Block

Maintenance Agreement Required: ☐ Yes ☒ No

☒ House/Mod. Home ☐ Mobile Home ☐ Business ☐ Other

No. Bedrooms 3 No. Bathrooms 2½ No. Employees ____


☐ Slab ☒ Crawl Space ☐ Basement w/plumbing ☒ Basement wo/plumbing

Water Supply: ☒ Individual ☐ Public ☐ Community

Comments:/Conditions:

NOT To Scale

INITIAL SITE SKETCH

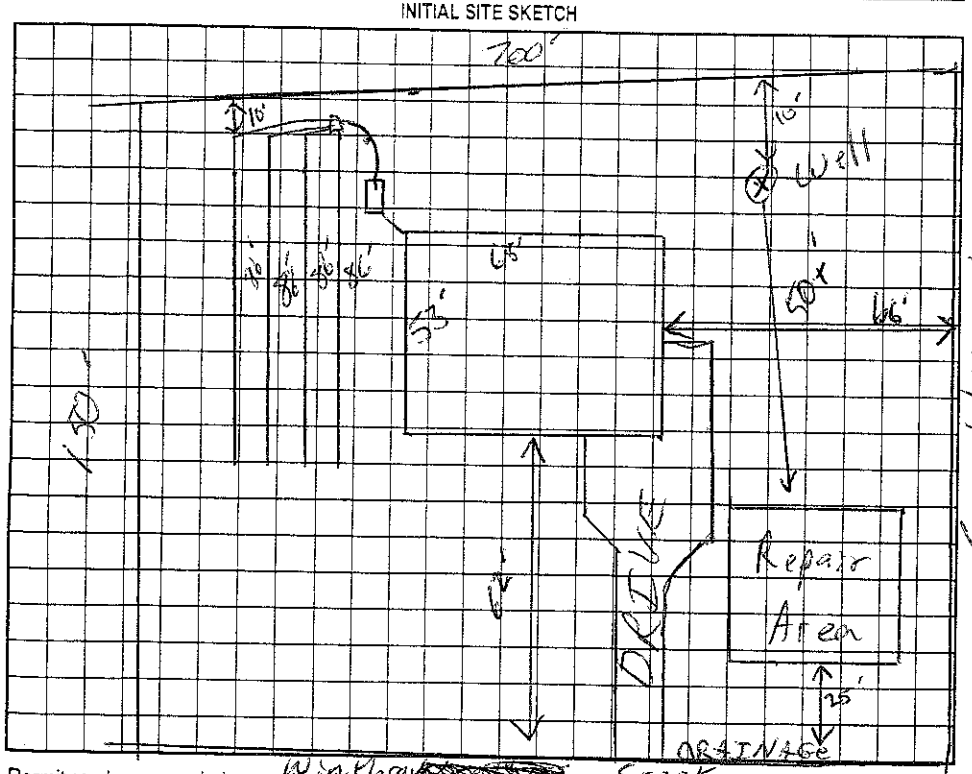

Comments:/Conditions: Partial

AS BUILT SKETCH

Quick 4 Installed

Permit can be suspended or revoked if any false information is supplied toward securing the permit/any unauthorized changes are made to the site/any unauthorized changes are made in the installation of the system. Improvement Permit with plat valid without expiration. Improvement Permit with site plan valid for sixty months. Authorization to Construct is valid for a period equal to that of Improvement Permit – not to exceed sixty months.

Signed: Wayne C Dobey date 2-9-04

Improvement Permit by: RS date 2/12/04

Authorization to Construct by: RS date 4/12/04

Installed by: Rowan Septic

Operation Permit by: RS date 6/12/06

Existing System Inspection by: _____ date _____

HEALTH DEPT. COPY: WHITE OWNER COPY (FINAL): YELLOW OWNER COPY (INITIAL): PINK