4669670439

IREDELL COUNTER HEALTH DEPARTMENT

Ant to Construct (10:00) 664-8413 - Humphrey

...ILLE 704-878-5305 MOORESVILLE 704-664-5281

IMPROVEMENT PERMIT / ~~CERTIFICATE OF COMPLETION~~ / OPERATION PERMIT / EXISTING SYSTEM INSPECTION

PROPERTY DESCRIPTION NO. 22636 DATE 3/25/96 TAX MAP NO. 4H-B-52 Watershed: ☐ Yes ☑ No

OWNER OR CONTRACTOR Jim Dabey PHONE: Business _____ Home 663-4273

ADDRESS 135 Sweetbriar Ln Mooresville NC 28115

LOCATION Shinnville Rd - TR Winthrow Creek Rd - go over bridge - TL past Creek

SUBDIVISION — BLOCK / SECTION — LOT — LOT AREA 4.1ac SITE CLASS PS DESIGN FLOW 300 gpd L.T.A.R. .3 gpd/ft²

Septic Tank: 1000 Gallons; STB 994 Date 5/15/96
Pump Tank: _____ Gallons; PT _____ Date _____
Pump Make: _____ Model _____ Serial No. _____
Nitrification Field: No Fields 1 Square Feet 900 Linear Feet 300
No Lines 3 Trench Width 36" Max Trench Bottom Depth 36" Gravel Depth N/A

☑ New System ☐ Repair System Type: I II III IV V VI
System Description: Gravity Chamberad
Repair System Description: Same
Maintenance Agreement Required: ☐ Yes ☑ No
☐ Slab ☐ Crawl Space ☑ Basement w/plumbing ☐ Basement wo/plumbing


☑ House/Mod. Home No. Bedrooms 3
☐ Mobile Home No. Bathrooms 2
☐ Business No. Employees ____
☐ Other _____

Water Supply:
☑ Individual
☐ Community
☐ Public


Comments: Lines can go within 5 ft of Drainage areas if properly filled.

Comments:

INITIAL SITE SKETCH 331'

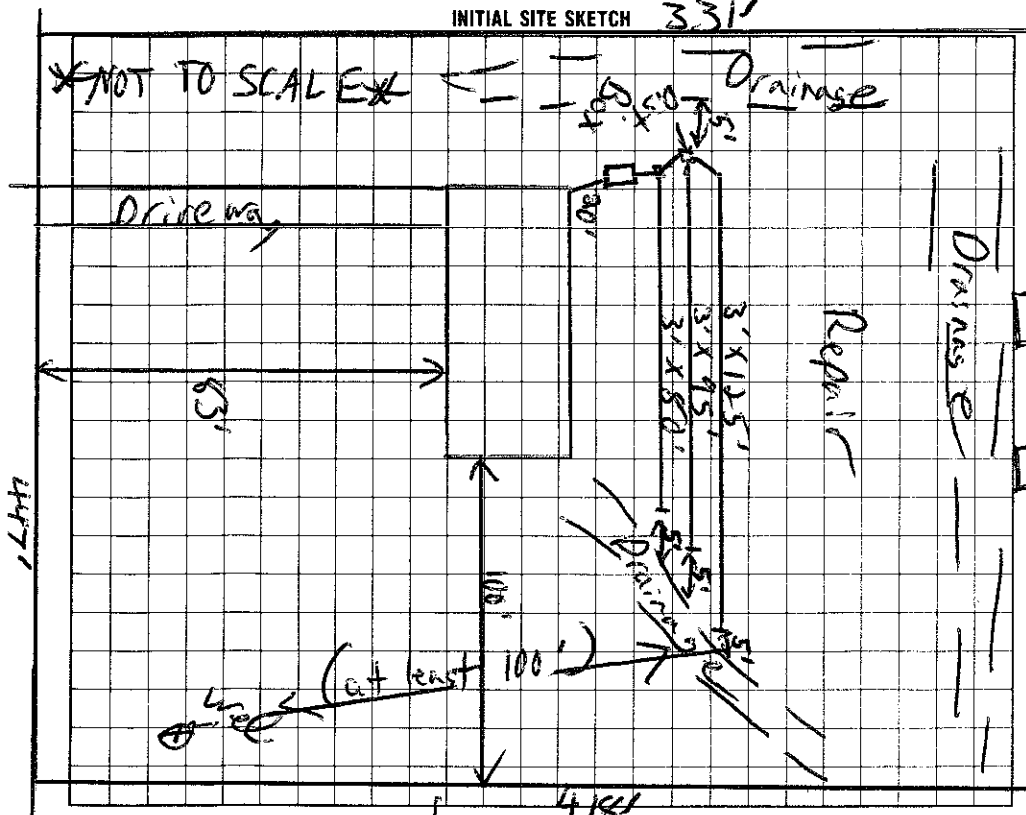

AS BUILT SKETCH

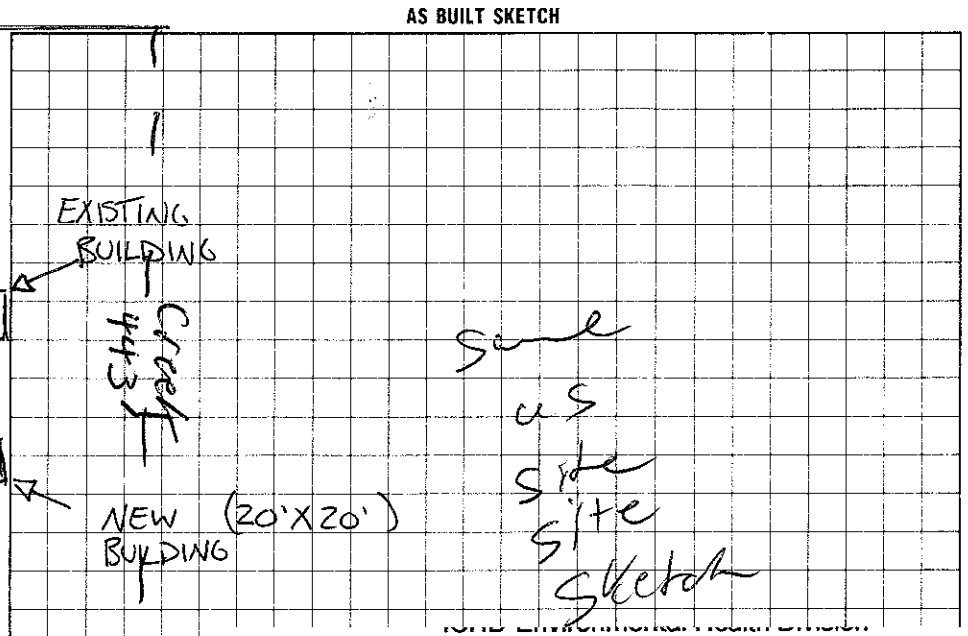

The proposed / existing BUILDING addition does not appear to impact the existing septic system.

**NOTE: _____ R.S.

Date: 8-4-09

ICHD-Environmental Health Division

I understand that this permit can be suspended or revoked if any false information is supplied toward securing the permit/any unauthorized changes are made to the site/any unauthorized changes are made in the installation of the system.

Signed: Rhonda Humphrey Installed by: Tim Ammons

Improvement Permit by: C. Brad Freeman EHSI date 3/28/96

Existing System Inspection by: C. Brad Freeman EHSI date 3/28/96

Certificate of Completion by: _____ date _____

Operation Permit by: C. Brad Freeman EHSI date 8/2/96

HEALTH DEPT. COPY: WHITE INSPECTION COPY (FINAL): GREEN OWNER COPY (FINAL): YELLOW INSPECTION COPY (INITIAL): PINK OWNER COPY (INITIAL): GOLD

Authorization to construct is valid for 60 months from issue date.