IREDELL COUNTY HEALTH DEPARTMENT

STATESVILLE 704-878-5305 MOORESVILLE 704-664-5281

IMPROVEMENT PERMIT / CERTIFICATE OF COMPLETION / OPERATION PERMIT / EXISTING SYSTEM INSPECTION

PROPERTY DESCRIPTION NO. 15449 DATE 7/29/93 4669-67-1697 TAX MAP NO. 4H B 39

OWNER OR CONTRACTOR ELIZABETH LAWRENCE PHONE: Business Home 663-4273

ADDRESS WINTHROW CREEK RD MOORESVILLE, NC

LOCATION WINTHROW CREEK RD, SHINNVILLE RD. TR AT STORE X CREEK TL ON GRAVEL TO 3RD LOT, 1ST HOUSE ON L

SUBDIVISION No BLOCK / SECTION LOT LOT AREA SITE CLASS. L.T.A.R.

Water Supply: ☑ Individual ☐ Community ☐ Public

Septic Tank: 1000 Gallons; STB 358 Date 5/3/93

Pump Tank: 1000 Gallons; PT 103 Date 5/3/93

Nitrification Field: No Fields 1 Square Feet 1200 Linear Feet 400

No Lines 4 Trench Width 3' Trench Depth 36" Gravel Depth 12"

☑ New System ☐ Repair System Type: I, II, ☑ IV, V, VI

System Description: CONV - SINGLE PUMP

Repair System Description: CONV

Maintenance Agreement Required: ☑ Yes ☐ No 5YR

☑ House/Mod. Home No. Bedrooms 3 Garbage Disposal: ☐ Yes ☑ No

☐ Mobile Home No. Bathrooms 3.5 Auto. Dishwasher: ☑ Yes ☐ No

☐ Business No. Employees Auto. Washing Machine: ☑ Yes ☐ No


☐ Other Other

☑ Slab ☐ Crawl Space ☑ Basement w/plumbing ☐ Basement wo/plumbing

Comments TO CREEK

INITIAL SITE SKETCH

AS-BUILT SKETCH

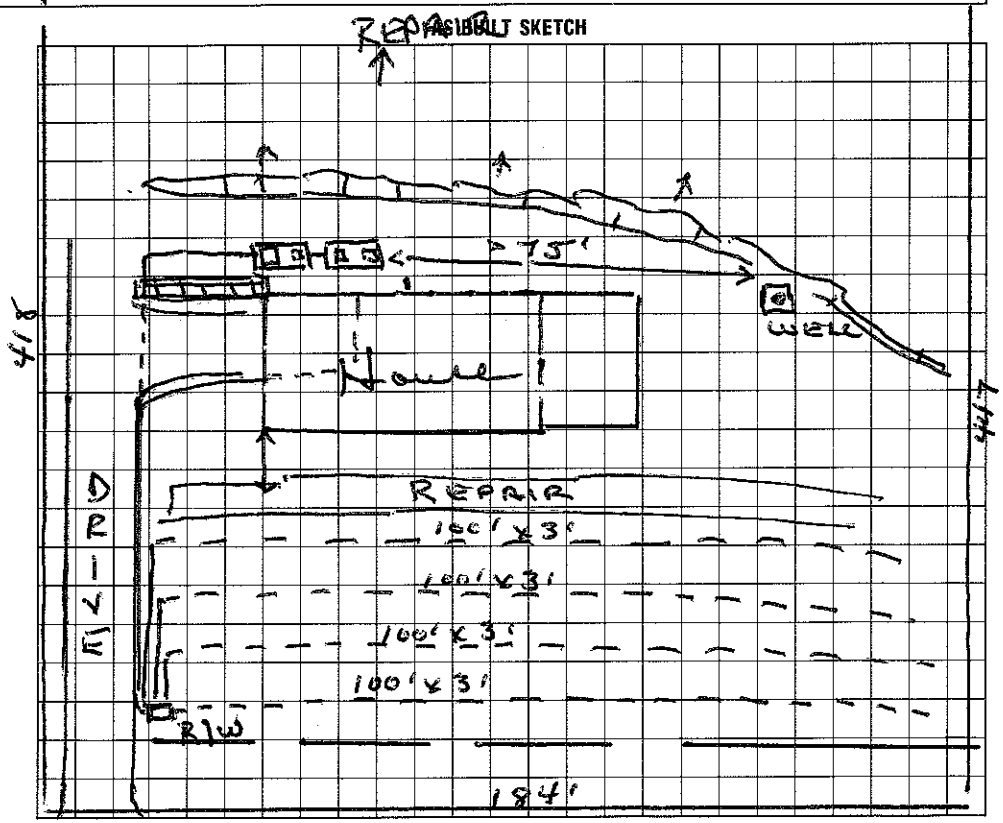

I understand that this permit can be suspended or revoked if any false information is supplied toward securing the permit/any unauthorized changes are made to the site/any unauthorized changes are made in the installation of the system. Improvement Permit is valid for 60 months from date of issuance.

GRAVEL ROAD

Signed:

Installed by: Kenny Williams

Improvement Permit by: date

Certificate of Completion by: date

Existing System Inspection by: date

Operation Permit by: Wesley Sparks R.S. date 7/29/93

HEALTH DEPT. COPY: WHITE INSPECTION COPY (FINAL): GREEN OWNER COPY (FINAL): YELLOW INSPECTION COPY (INITIAL): PINK OWNER COPY (INITIAL): GOLD

