IREDELL COUNTY HEALTH DEPARTMENT

Authorization to Construct

STATESVILLE 704-878-5305 MOORESVILLE 704-664-5281

4669673397

IMPROVEMENT PERMIT / ~~CERTIFICATE OF COMPLETION~~ / OPERATION PERMIT / EXISTING SYSTEM INSPECTION

PROPERTY DESCRIPTION NO. 22885 DATE 2/8/96 TAX MAP NO. 4H 87 Watershed: ☐ Yes ☒ No

OWNER OR CONTRACTOR Angela Lewis PHONE: Business _____ Home 892-0551

ADDRESS PO Box 1029 Davidson, NC 28036

LOCATION Shinnville Rd (R) Wenthrow Creek TL on Sweetbriar Ln. lot on (R)

SUBDIVISION N/A BLOCK / SECTION _____ LOT N/A LOT AREA ~1.64C SITE CLASS. PS DESIGN FLOW 360 L.T.A.R. .3

Septic Tank: 1000 Gallons; STB _____ Date _____

Pump Tank: _____ Gallons; PT _____ Date _____

Pump Make: _____ Model _____ Serial No. _____

Nitrification Field: No Fields 1 Square Feet 1200 Linear Feet * 200

No Lines 3 Trench Width 24" Max Trench Bottom Depth 32" Gravel Depth 6" SAND

☒ New System ☐ Repair System Type: I. II (III) IV. V. VI

System Description: Conv. Panel

Repair System Description: Pres. Panel

Maintenance Agreement Required: ☐ Yes ☒ No

☒ House/Mod. Home ☐ Mobile Home ☐ Business ☐ Other

No. Bedrooms 3 No. Bathrooms 2 No. Employees _____


☐ Slab ☐ Crawl Space ☒ Basement w/plumbing ☐ Basement wo/plumbing

Water Supply: ☒ Individual ☐ Community ☐ Public


Comments:
* 50% reduction for use of panel blocks

Comments:

INITIAL SITE SKETCH 1" = 50'

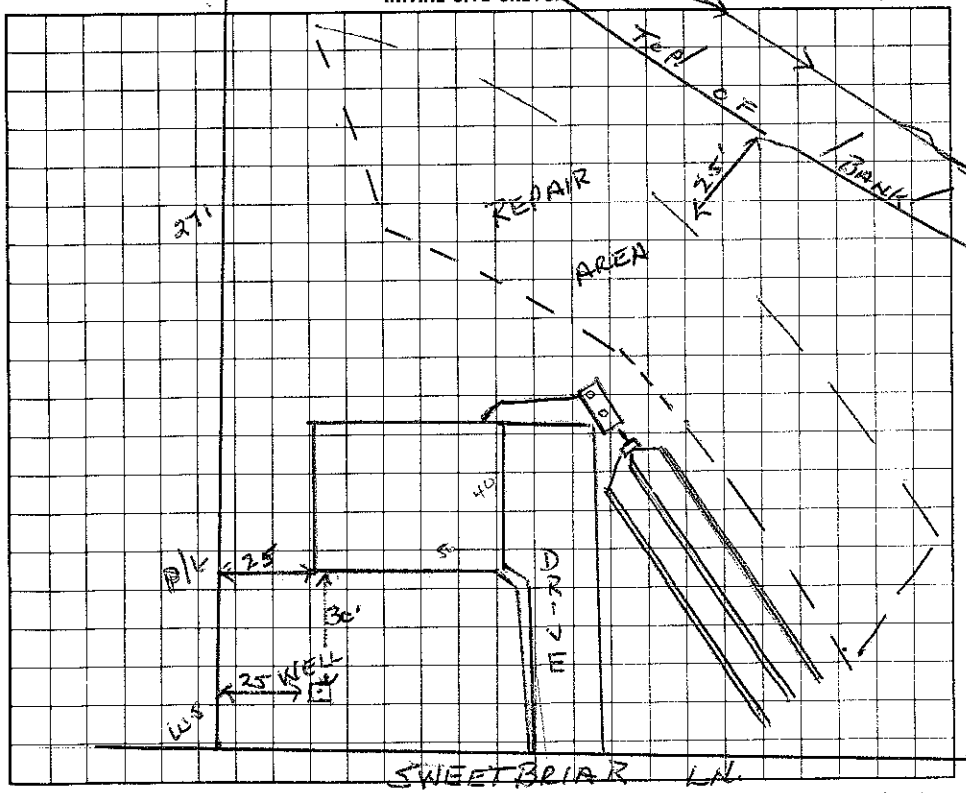

AS BUILT SKETCH

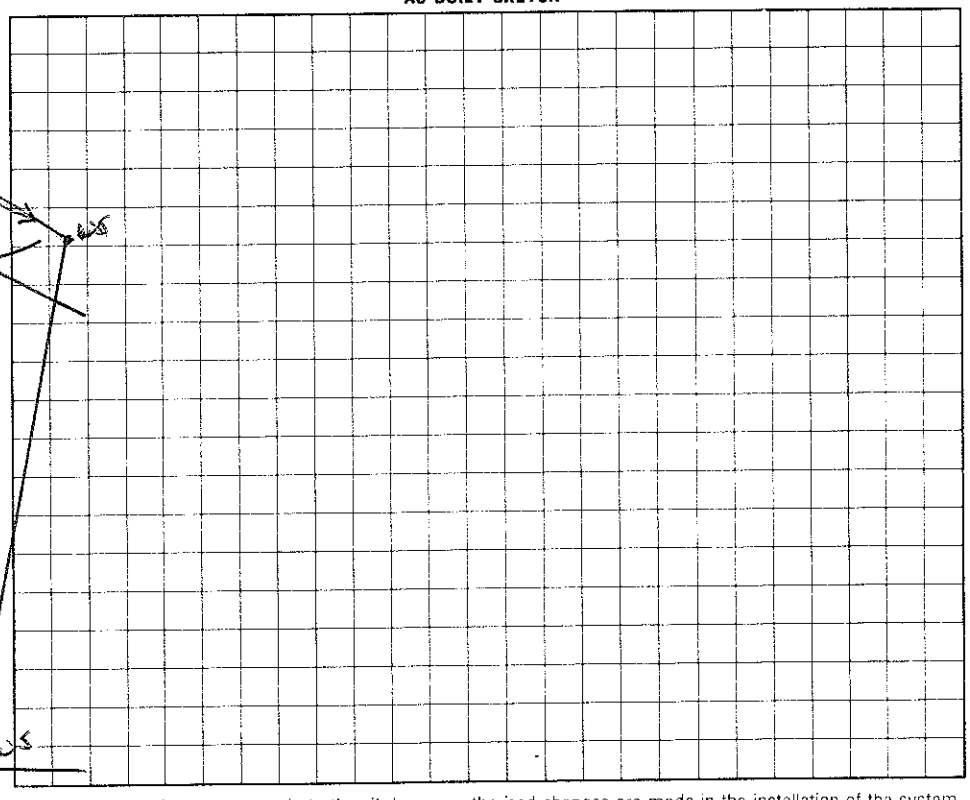

I understand that this permit can be suspended or revoked if any false information is supplied toward securing the permit/any unauthorized changes are made to the site/any unauthorized changes are made in the installation of the system

Signed: * C Rawlings

Improvement Permit by: Wesley Sparks R.S. date 2/8/96

Authorization to Construct by: Wesley Sparks R.S. date 2/8/96

Installed by: Tom Simmons

Certificate of Completion by: Wesley Sparks R.S. date 3/6/00

Operation Permit by: Wesley Sparks R.S. date 3/6/00

HEALTH DEPT. COPY: WHITE INSPECTION COPY (FINAL): GREEN OWNER COPY (FINAL): YELLOW INSPECTION COPY (INITIAL): PINK OWNER COPY (INITIAL): GOLD