ICHD - ENVIRONMENTAL HEALTH DIVISION

Statesville Office (704) 878-5305 Mooresville Office (704) 660-3625 SW

PERMIT # OSWP 2023-36954

SEPTIC: IMPROVEMENT PERMIT / AUTHORIZATION TO CONSTRUCT / OPERATION PERMIT / EXISTING SYSTEM

PIN # 4669 -- 67 -- 7621 ✓

APPLICANT/OWNER: Mark Roberts

APPLICANT ADDRESS: 134 Sweetbriar Ln, Mooresville 28115

SITE ADDRESS: 134 Sweetbriar Ln, Mooresville 28115 ✓

PHONE: 601-577-8284

ALT. PHONE —

SITE DIRECTIONS: Winthrow Creek - ® Sweetbriar - Lot on ®

SAP CONTROLLED: ☐ YES ☐ NO

SUBDIVISION: —

SECTION: — LOT # — LOT AREA: 2.38

DESIGN FLOW: — L.T.A.R.: —

Septic Tank	1000	(gal)	STB	Infil.	Date	—	☐ New System	☑ Repair	☐ Expansion
Pump Tank		(gal)	PT		Date		System Description:		
Pump Make			Model		Serial #		Repair System Description:	Tank	
# Nitrification Fields	EX		# Lines	EX	Linear Ft	EX	Maintenance Agreement Required:	☐ YES	☑ NO
Trench Width	EX		Trench Bottom Depth(Low side)		EX	Gravel Depth	EX	☑ GRAVITY	☐ PRESSURE


System Type: I (II) III IV V VI

☑ Residence No. Bedrooms EX
☐ Business No. Persons EX
☐ Other No. Employees
☐ Slab ☐ Crawl Space
☑ Basement w/plumbing ☐ Basement w/o plumbing

Water Supply: ☑ Private ☐ Public ☐ Community

Comments / Conditions: System functioning properly at time of inspection. Pump crush and fill old tank. Replace distribution devices as needed.

INITIAL SITE SKETCH

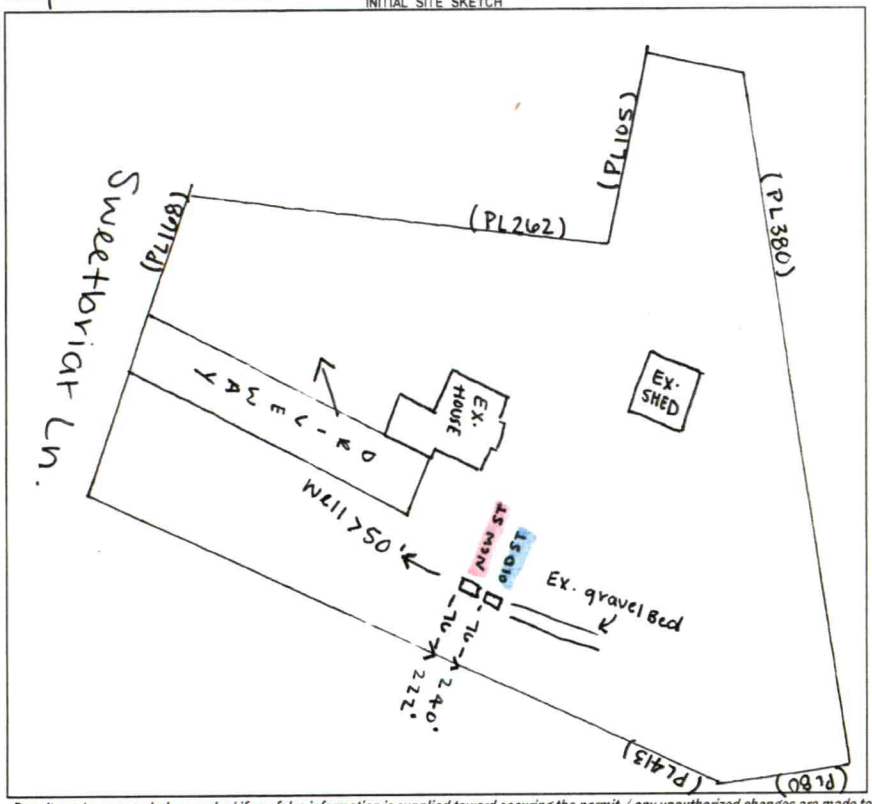

AS BUILT SKETCH

FOR SEPTIC FINAL INSPECTION CALL: 704-664-3703 between 8am-9am the day the inspection is needed. Be sure to speak with an inspector to confirm your time.

1" : 100'

New Septic tank
Old Septic tank

Permit can be suspended or revoked if any false information is supplied toward securing the permit / any unauthorized changes are made to the site / any unauthorized changes are made in the installation of the system. **CONTACT A LOCATOR SERVICE PRIOR TO ANY EXCAVATION**

☐ **IMPROVEMENT PERMIT** *with plat valid without expiration.* ☑ **IMPROVEMENT PERMIT** *with site plan valid for 60 mos.* ☑ **AUTHORIZATION TO CONSTRUCT** *valid for period equal to IMPROVEMENT PERMIT--not to exceed 60 mo.*

Owner / Applicant Signature: Online Date: —

IMPROVEMENT PERMIT by: Sydney Holland Date: 9/27/23

AUTHORIZATION TO CONSTRUCT by: Sydney Holland Date: 9/27/23

Installed by: Carolina Septic Pro

OPERATION PERMIT by: Sydney Holland Date: 10/27/23

Existing System Inspected by: Date:

FOR SEPTIC FINAL INSPECTION: CALL 704-664-3703 between 8am-9am the day the inspection is needed.

ICHD - ENVIRONMENTAL HEALTH DIVISION

Statesville Office (704) 878-5305 SW Mooresville Office (704) 660-3625

PERMIT # OSWP 2023-36954

SEPTIC: IMPROVEMENT PERMIT / AUTHORIZATION TO CONSTRUCT / OPERATION PERMIT / EXISTING SYSTEM

PIN # 4669 -- 67 -- 7621

APPLICANT/OWNER: Mark Roberts

APPLICANT ADDRESS: 134 Sweetbriar Ln, Mooresville 28115

SITE ADDRESS: 134 Sweetbriar Ln, Mooresville 28115

PHONE: 601-577-8284

ALT. PHONE —

SITE DIRECTIONS: Winthrow Creek - R Sweetbriar - Lot on R

SAP CONTROLLED: ☐ YES ☐ NO

SUBDIVISION: —

SECTION: — LOT # — LOT AREA: 2.38

DESIGN FLOW: — L.T.A.R.: —

Septic Tank 1000 (gal) STB — Date —

Pump Tank — (gal) PT — Date —

Pump Make — Model — Serial # —

Nitrification Fields EX # Lines EX Linear Ft EX

Trench Width EX Trench Bottom Depth(Low side) EX Gravel Depth EX

☐ New System ☑ Repair ☐ Expansion System Type: I (II) III IV V VI

System Description: —

Repair System Description: Tank

Maintenance Agreement Required: ☐ YES ☑ NO

☑ GRAVITY ☐ PRESSURE

☑ Residence No. Bedrooms EX

☐ Business No. Persons EX

☐ Other No. Employees —

☐ Slab ☐ Crawl Space


☑ Basement w/plumbing ☐ Basement w/o plumbing

Water Supply

☑ Private ☐ Public ☐ Community

Comments / Conditions: System functioning properly at time of inspection. Pump crush and fill old tank. Replace distribution devices as needed.

INITIAL SITE SKETCH

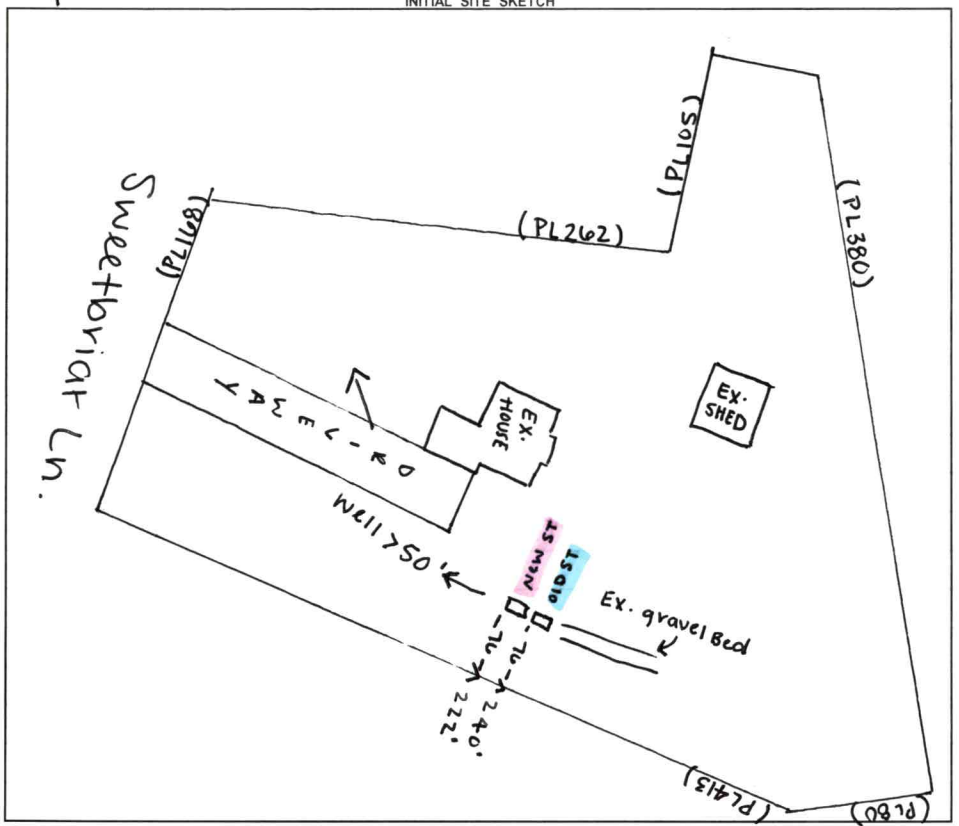

AS BUILT SKETCH

FOR SEPTIC FINAL INSPECTION CALL: 704-664-3703 between 8am-9am the day the inspection is needed. Be sure to speak with an inspector to confirm your time.

1" = 100'

New Septic tank

Old Septic tank

Permit can be suspended or revoked if any false information is supplied toward securing the permit / any unauthorized changes are made to the site / any unauthorized changes are made in the installation of the system. **CONTACT A LOCATOR SERVICE PRIOR TO ANY EXCAVATION**

☐ **IMPROVEMENT PERMIT** *with plat valid without expiration.* ☑ **IMPROVEMENT PERMIT** *with site plan valid for 60 mos.* ☑ **AUTHORIZATION TO CONSTRUCT** *valid for period equal to IMPROVEMENT PERMIT--not to exceed 60 mo.*

Owner / Applicant Signature: Online Date: — Installed by: —

IMPROVEMENT PERMIT by: Sydney Howard Date: 9/27/23 OPERATION PERMIT by: — Date: —

AUTHORIZATION TO CONSTRUCT by: Sydney Howard Date: 9/27/23 Existing System Inspected by: — Date: —

FOR SEPTIC FINAL INSPECTION: CALL 704-664-3703 between 8am-9am the day the inspection is needed.