ICHD - ENVIRONMENTAL HEALTH DIVISION

Statesville Office (704) 878-5305 | Mooresville Office (704) 660-3625 PERMIT # AP2022-4519

SEPTIC: IMPROVEMENT PERMIT / AUTHORIZATION TO CONSTRUCT / OPERATION PERMIT / EXISTING SYSTEM

PIN # 4669-47-7473

APPLICANT/OWNER: Scott Kurtz APPLICANT ADDRESS: 148 Sweetbriar Ln Mooresville 28115

SITE ADDRESS: 148 Sweetbriar Ln Mooresville 28115 PHONE: 704-682-0354 ALT. PHONE –

SITE DIRECTIONS: ① on Amity Hill, ② Ostwalt Amity, ③ Quecthers Creek, ④ Shinnville, ⑤ Winthrow Creek SAP CONTROLLED: ☐ YES ☑ NO


SUBDIVISION: SECTION: LOT # LOT AREA: DESIGN FLOW: Ext L.T.A.R.: Ext

Septic Tank	1000 (gal)	STB	760	Date	10/2/22	☐ New System	☑ Repair	☐ Expansion	System Type: I II III IV V VI	☑ Residence	No. Bedrooms 3
Pump Tank	(gal)	PT		Date		System Description:				☐ Business	No. Persons 6
Pump Make		Model		Serial #		Repair System Description:	Tank Replacement			☐ Other	No. Employees
# Nitrification Fields	Ext	# Lines	Ext	Linear Ft	Ext	Maintenance Agreement Required:	☐ YES	☑ NO		☐ Slab	☑ Crawl Space
Trench Width	Ext	Trench Bottom Depth(Low side)	Ext	Gravel Depth	Ext		☑ GRAVITY	☐ PRESSURE		☐ Basement w/plumbing	☐ Basement w/o plumbing

Water Supply: ☑ Private ☐ Public ☐ Community

Comments / Conditions: Pump, crush, fill old tank. New tank may need to be placed in same hole in order to get fall.

INITIAL SITE SKETCH

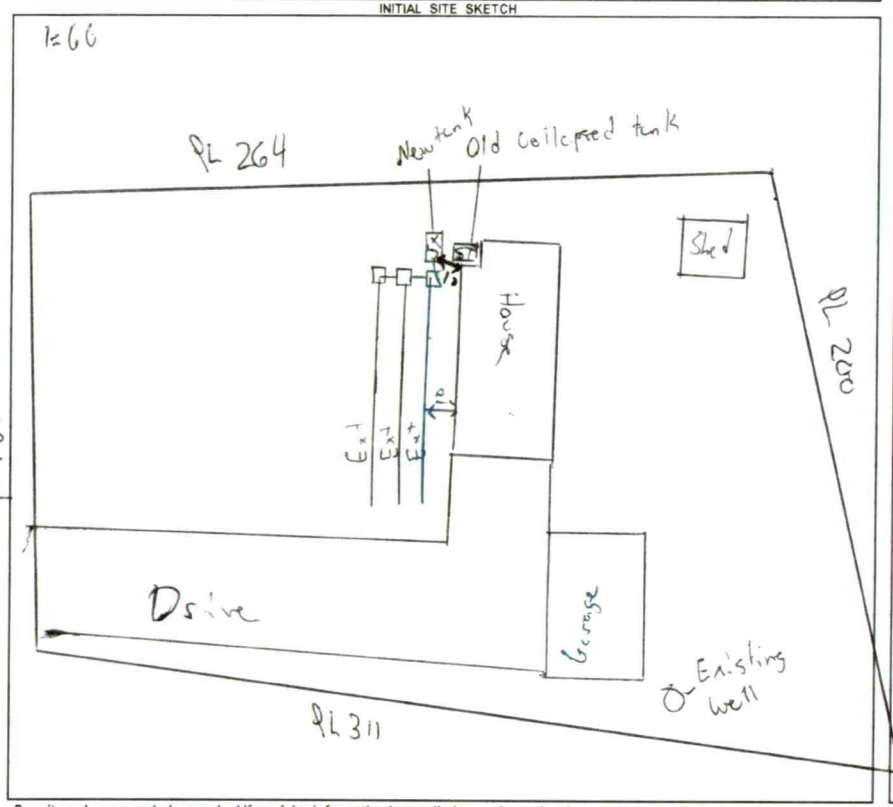

AS BUILT SKETCH

FOR SEPTIC FINAL INSPECTION CALL: 704-664-3703 between 8am-9am the day the inspection is needed. Be sure to speak with an inspector to confirm your time.

Installed as Drawn

Permit can be suspended or revoked if any false information is supplied toward securing the permit / any unauthorized changes are made to the site / any unauthorized changes are made in the installation of the system. **CONTACT A LOCATOR SERVICE PRIOR TO ANY EXCAVATION**

☐ **IMPROVEMENT PERMIT** ***with plat*** *valid without expiration.* ☑ **IMPROVEMENT PERMIT** ***with site plan*** *valid for 60 mos.* ☑ **AUTHORIZATION TO CONSTRUCT** *valid for period equal to IMPROVEMENT PERMIT--not to exceed 60 mo.*

Owner / Applicant Signature: Online Signature Date: Installed by: Russell Williams

IMPROVEMENT PERMIT by: Date: 9/28/22 OPERATION PERMIT by: Date: 11/7/22

AUTHORIZATION TO CONSTRUCT by: Date: 9/28/22 Existing System Inspected by: Date:

FOR SEPTIC FINAL INSPECTION: CALL 704-664-3703 between 8am-9am the day the inspection is needed.

ICHD - ENVIRONMENTAL HEALTH DIVISION

Statesville Office (704) 878-5305 | Mooresville Office (704) 660-3625 PERMIT # AP2022-4519

SEPTIC: IMPROVEMENT PERMIT / AUTHORIZATION TO CONSTRUCT / OPERATION PERMIT / EXISTING SYSTEM

PIN #4664 -- 67 -- 7973

APPLICANT/OWNER: Scott Kurtz

APPLICANT ADDRESS: 148 Sweetbriar Ln Mooresville 28115

SITE ADDRESS: 148 Sweetbriar Ln Mooresville 28115

PHONE: 704-682-0384 ALT. PHONE –

SITE DIRECTIONS: (B) on Amity Hill, (L) Ostwalt Amity, (R) Deercliffers Creek, (L) Shinnville, (R) Winthrow Creek

SAP CONTROLLED: ☐ YES ☑ NO


SUBDIVISION: SECTION: LOT # LOT AREA: DESIGN FLOW: Ext L.T.A.R.: Ext

Septic Tank	1000 (gal)	STB	Date	☐ New System	☑ Repair	☐ Expansion	System Type: I II (III) IV V VI	☑ Residence	No. Bedrooms 3
Pump Tank	(gal)	PT	Date	System Description:				☐ Business	No. Persons 6
Pump Make	Model		Serial #	Repair System Description:	Tank Replacement			☐ Other	No. Employees
# Nitrification Fields	Ext # Lines Ext		Linear Ft Ext	Maintenance Agreement Required:	☐ YES	☑ NO		☐ Slab	☑ Crawl Space
Trench Width	Ext Trench Bottom Depth(Low side) Ext		Gravel Depth Ext	☑ GRAVITY	☐ PRESSURE			☐ Basement w/plumbing	☐ Basement w/o plumbing

Water Supply: ☑ Private ☐ Public ☐ Community

Comments / Conditions: Pump, crush & fill old tank. New tank may need to be placed in same hole in order to get fall.

INITIAL SITE SKETCH

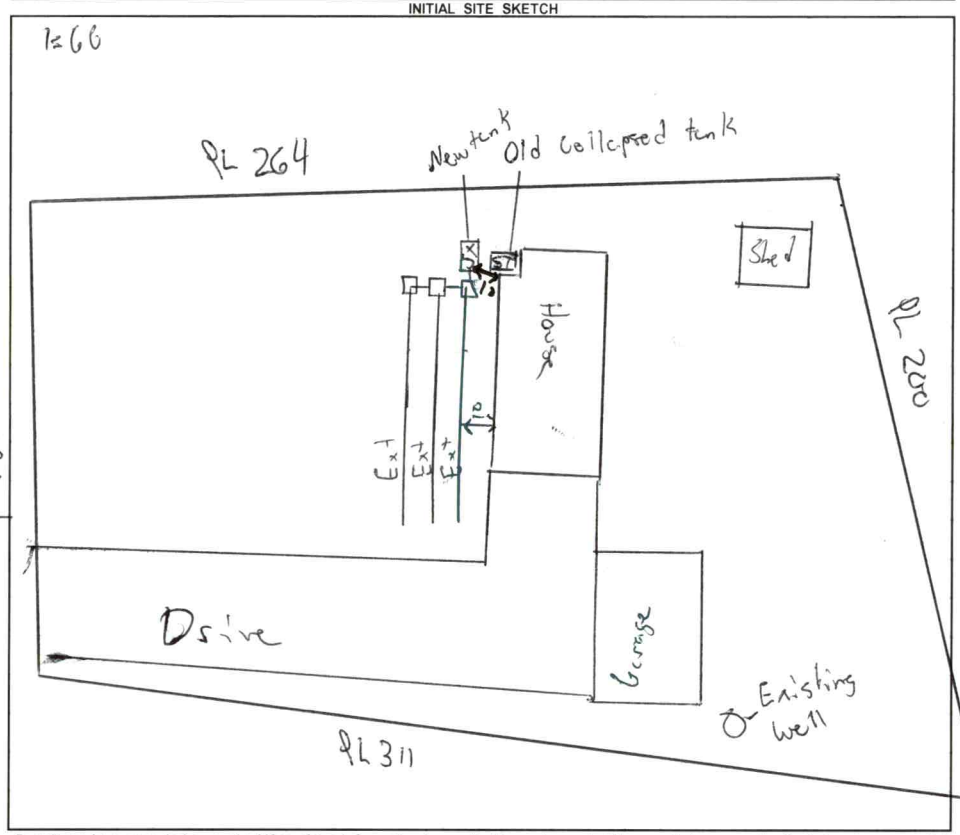

AS BUILT SKETCH

FOR SEPTIC FINAL INSPECTION CALL: 704-664-3703 between 8am-9am
the day the inspection is needed. Be sure to speak with an inspector to confirm your time.

Permit can be suspended or revoked if any false information is supplied toward securing the permit / any unauthorized changes are made to the site / any unauthorized changes are made in the installation of the system. **CONTACT A LOCATOR SERVICE PRIOR TO ANY EXCAVATION**

☐ **IMPROVEMENT PERMIT** ***with plat*** *valid without expiration.* ☑ **IMPROVEMENT PERMIT** ***with site plan*** *valid for 60 mos.* ☑ **AUTHORIZATION TO CONSTRUCT** *valid for period equal to IMPROVEMENT PERMIT--not to exceed 60 mo.*

Owner / Applicant Signature: Online Signature Date: Installed by:

IMPROVEMENT PERMIT by: [signature] Date: 9/28/22 OPERATION PERMIT by: Date:

AUTHORIZATION TO CONSTRUCT by: [signature] Date: 9/28/22 Existing System Inspected by: Date:

FOR SEPTIC FINAL INSPECTION: CALL 704-664-3703 between 8am-9am the day the inspection is needed.

Item	Date	Initials
Drain Lines Checked		
Tanks Checked		
Pressure Manifold or Valve Box Checked		
Pressure Head Set		
Electrical Checked		
Floats Set		
Alarm Checked		
Maintenance Contract Needed? Y / N		
Comments:		


Repairs Only	
	State Code
Failing System Code	
Type of Distribution	G or P
Type of Failure/Malfunction	
Primary Cause of Failure/Malfunction	
Age of System? _____	
Initial or Repair? _____	

146 Sweetbriar Ln

IREDELL COUNTY DEPARTMENT of ENVIRONMENTAL HEALTH

SITE PLAN WORKSHEET

SEE THE "SAMPLE SITE PLAN" BELOW. *INCOMPLETE SITE PLANS WILL BE RETURNED TO YOU FOR COMPLETION AND MAY RESULT IN A DELAY IN THE ISSUANCE OF YOUR SEPTIC SYSTEM OR WELL PERMIT!!!*

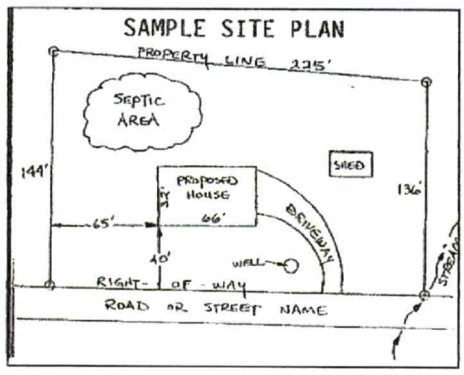

Place an (X) beside each item as you complete the site plan:


- (X) Property Line measurements are clearly identified
- (X) All proposed structures are indicated
- ( ) Front and side setbacks from property line
- (X) Preferred driveway location
- (X) Preferred well location
- (X) Preferred septic system location
- (X) North arrow, or other sufficient indicator of direction

Circle N/A on the following if appropriate:

Location of septic systems and wells within 100' of your property	N/A
Location of easements and rights of ways on your property	N/A
Location of any designated wetlands on the property	N/A

USE THIS SPACE TO DRAW YOUR SITE PLAN

Show: proposed house or business footprint, wells, water lines, patios, pools and decks, and any other item that will occupy space on the site

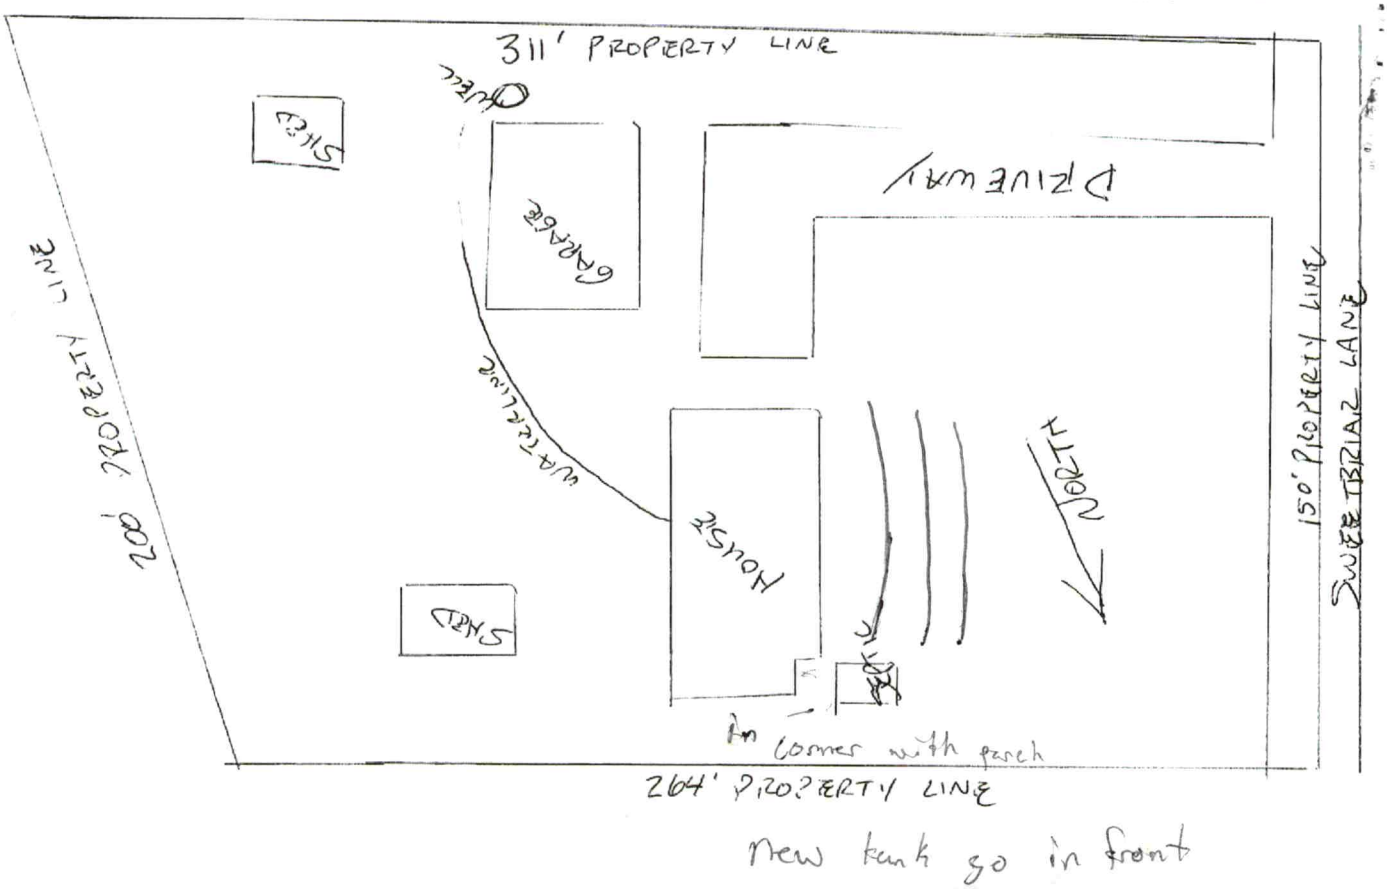

Signature: _____ _____

Property owner or owner's legal representative signature (SIGNATURE REQUIRED) DATE



Tax Map Information

• PIN	4669677973.000
• Address	148 SWEETBRIAR LN
• Account #	Acct 77398609
• Tax Owner	KURTZ SCOTT M
• Mailing Address	148 SWEETBRIAR LN
•	MOORESVILLE, NC 28117
• GIS Owner	KURTZ SCOTT M+JACKIE L
• Deed Info	1500 / 83 - WD - 20031104
• Tax Acres	1.12 AC
• Lot #	
• Description	MEADOWS SR2379 OFF
• Zoning	RA
• Old Parcel #	1604H00000B054
• Bldg Value	$183,590
• OBXF Value	$2,870
• Land Value	$40,990
• Total Value	$227,450
• Defer Value	$0
• Tax Districts	-ALLCOUNTY FIRE- -

IREDELL COUNTY, NC

MAP FOR REFERENCE ONLY
NOT A LEGAL DOCUMENT

Iredell County, North Carolina makes no claims and no warranties, expressed or implied, concerning the validity or accuracy of the GIS data presented on this map.

Print map scale is approximate. Critical layout or measurement activities should not be done using this resource.