IREDELL COUNTY HEALTH DEPARTMENT

STATESVILLE 704-878-5305 MOORESVILLE 704-664-5281

IMPROVEMENT PERMIT / AUTHORIZATION TO CONSTRUCT / OPERATION PERMIT / EXISTING SYSTEM INSPECTION

PERMIT # 158729 PIN # 4669-68-6381 DATE 10-26-09

OWNER or APPLICANT BRAD KESELOWSKI PHONE: Business 704-578-3161 Home: DG HOMES

OWNER or APPLICANT ADDRESS 165 SWEET BRIAR LN

LOCATION / DIRECTIONS SHANNVILLE RD, WINTHROW CREEK, SWEET BRIAR, C END

SUBDIVISION BLOCK / SECTION LOT # 1 LOT AREA 1.36AC DESIGN FLOW 480 L.T.A.R.

Septic Tank 1000 Gallons: STB 1012 Date 4-28-08

Pump Tank Gallons: PT Date

Pump Make Model Serial #

Nitrification Field No Fields EXISTING No Lines Linear Feet

Trench Width Max. Trench Bottom Depth Gravel Depth

☒ New System ☐ Repair ☐ Expansion System Type I (II) III IV V VI

System Description: ADD 1000 GAL TANK

Repair System Description:

Maintenance Agreement Required ☐ YES ☒ NO

☒ GRAVITY ☐ PRESSURE

☒ Residence No. Bedrooms 4

☐ Business No. Persons

☐ Other No. Employees

☐ Slab ☒ Crawl Space

☒ Basement w/plumbing ☐ Basement w/o plumbing


Water Supply: ☒ Private ☐ Public ☐ Community

Comments / Conditions 1) PUMP, CRUSH & FILL OLD TANK


2) ADD NEW 1000 GAL TANK

Comments / Conditions

INITIAL SITE SKETCH

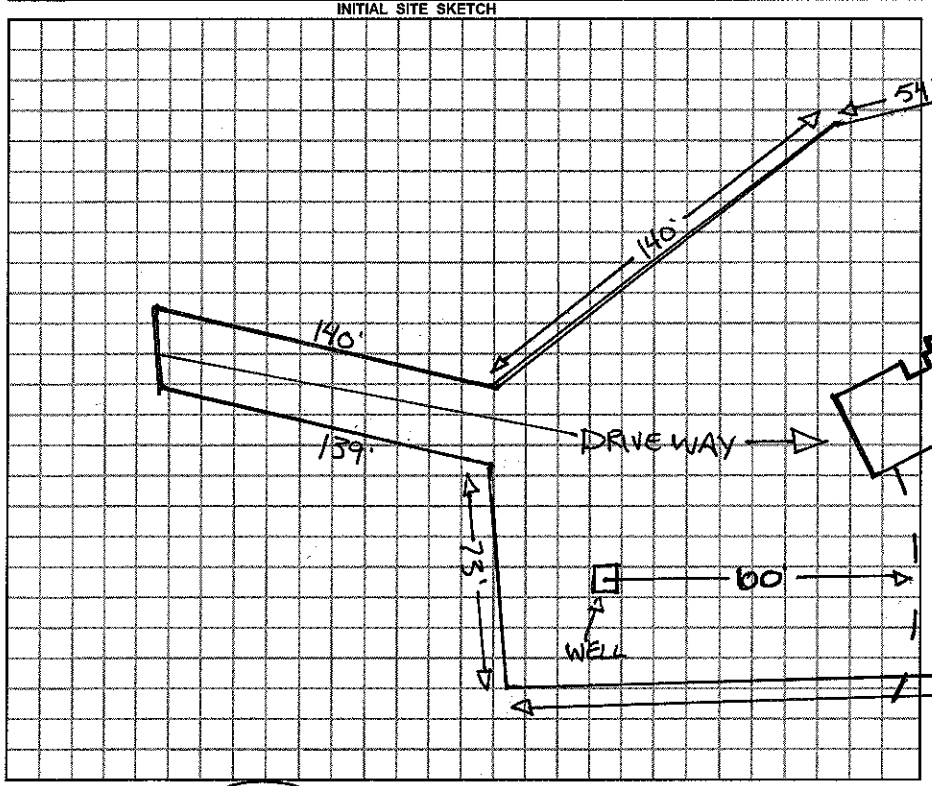

AS BUILT SKETCH

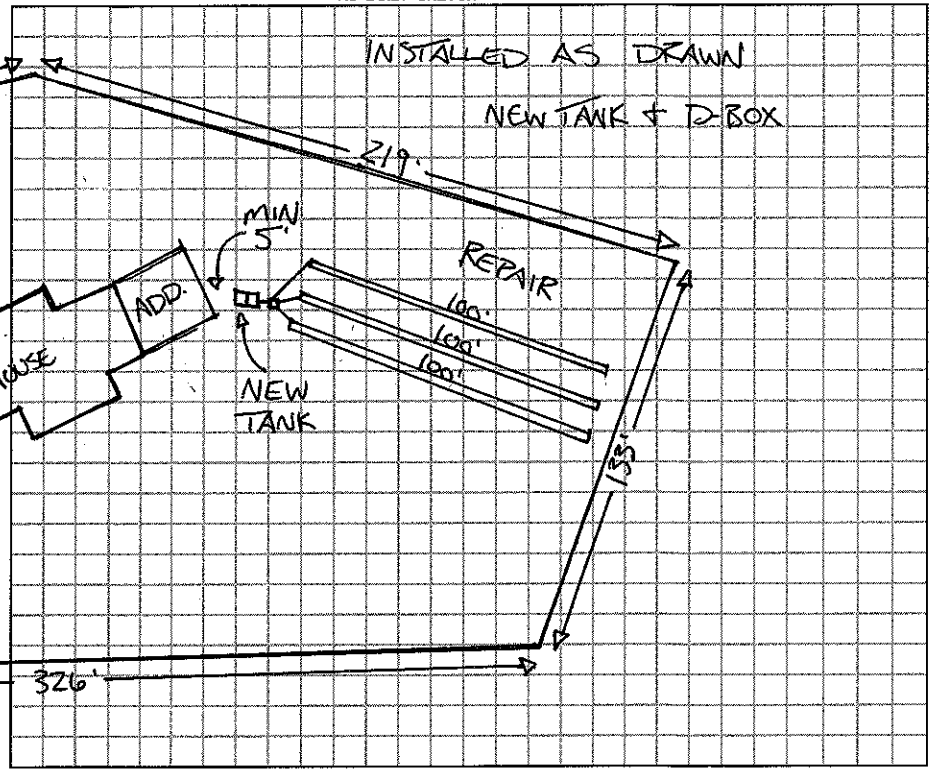

Permit can be suspended or revoked if any false information is supplied toward securing the permit / any unauthorized changes are made to the site / any unauthorized changes are made in the installation of the system.

☐ *IMPROVEMENT PERMIT w / plat valid without expiration.* ☒ *IMPROVEMENT PERMIT w / site plan valid for 60 mos.* ☒ *AUTHORIZATION TO CONSTRUCT valid for period equal to IMPROVEMENT PERMIT-not to exceed 60 mo.*

Owner / Applicant Signature: Rhonda Jones Date 10-26-09

Improvement Permit by: RS. Date 10-26-09

Authorization to Construct by: RS. Date 10-26-09

YOU SHOULD CONTACT A LOCATOR SERVICE PRIOR TO ANY EXCAVATION.

Installed by: PIEDMONT

Operation Permit by: Greens Date: 11-6-09

Existing System Inspected by: Date:

WHITE COPY Environmental Health YELLOW COPY (Final) Owner / Applicant PINK COPY (Initial) Owner / Applicant