IREDELL COUNTY HEALTH DEPARTMENT

STATESVILLE 704-878-5305 MOORESVILLE 704-664-5281

IMPROVEMENT PERMIT / AUTHORIZATION TO CONSTRUCT / OPERATION PERMIT / EXISTING SYSTEM INSPECTION

~~11:00~~ 9:30 - 10:00

PERMIT# 088189 PIN# ~~4669718543 PT~~ 4669 70 7888 DATE 3/23/2000

OWNER OR CONTRACTOR Beverly Pierce PHONE: Business 892-1699 Home 664-9042

ADDRESS 111 Milbrook Ln Mooresville, NC 28117

LOCATION Hwy 115N TR Mazeppa Rd 2.5 miles on left - 669 Mazeppa

SUBDIVISION ~~—~~ BLOCK / SECTION ~~—~~ LOT ~~—~~ LOT AREA 1.08 Acre SITE CLASS. PS DESIGN FLOW 360 gpd L.T.A.R. .3

Septic Tank: 1000 Gallons; STB 312 Date 5-1-00

Pump Tank: ~~—~~ Gallons; PT ~~—~~ Date ~~—~~

Pump Make: ~~—~~ Model ~~—~~ Serial No. ~~—~~

Nitrification Field: No Fields 1 Square Feet 1200' Linear Feet 400'

No Lines ~~4 at 100'~~ 5 at 80' Trench Width 36" Max Trench Bottom Depth 24" Gravel Depth 12"

[X] New System [ ] Repair System Type: I, II, III, IV, V, VI

System Description: Gravity - Conventional

Repair System Description: Pump - Conventional

Maintenance Agreement Required: [ ] Yes [X] No

[X] House/Mod. Home No. Bedrooms 3

[ ] Mobile Home No. Bathrooms 2

[ ] Business No. Employees ~~—~~


[ ] Other ~~—~~

[ ] Slab [X] Crawl Space [ ] Basement w/plumbing [ ] Basement wo/plumbing

Water Supply: [X] Individual [ ] Public [ ] Community

Comments/Conditions: Keep Septic System at least 10' From PL & 5' from house & 50-100' From well. Keep Drainfield higher up on lot due to poorer soils on lower end of lot.


INITIAL SITE SKETCH

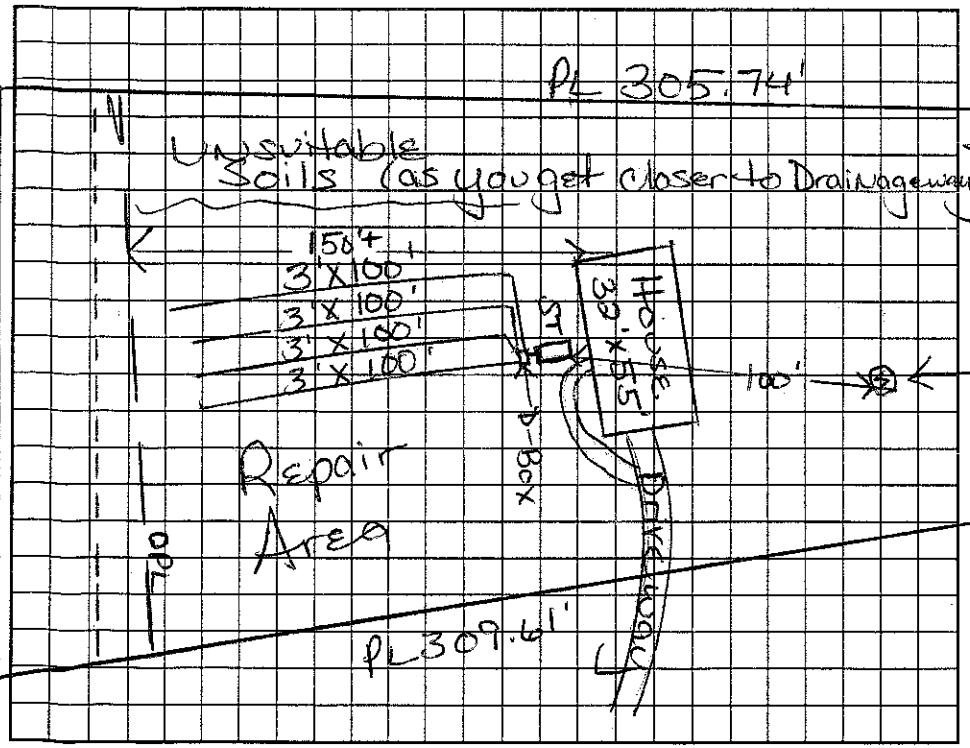

Comments/Conditions: Septic Tank marker use, No riser Filter installed

* Well not installed at time of inspection.

AS BUILT SKETCH

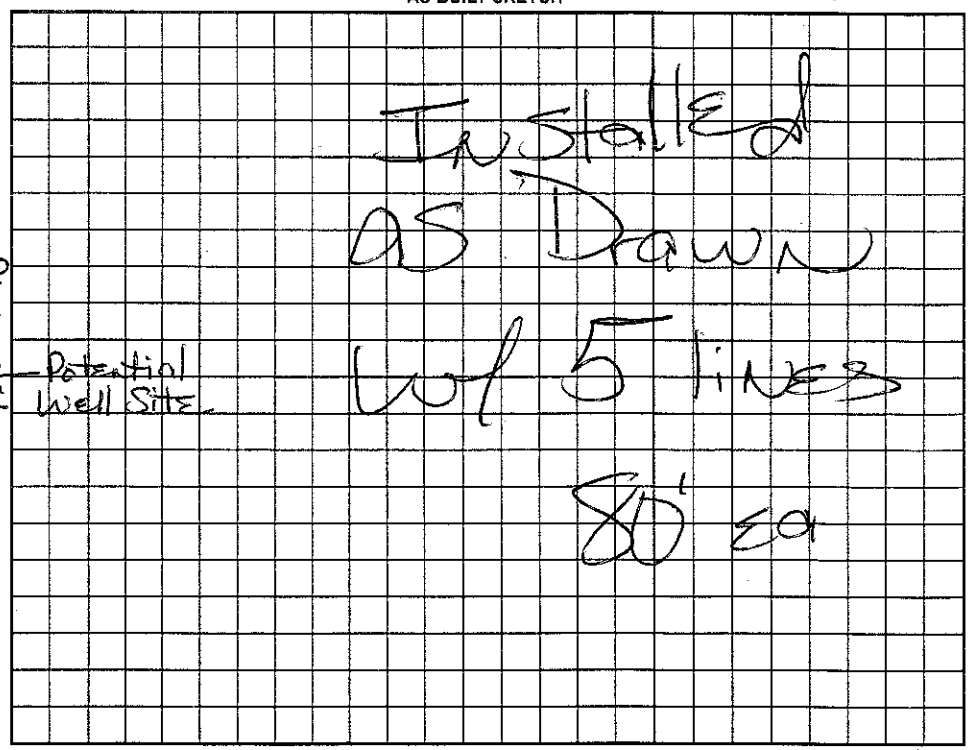

Permit can be suspended or revoked if any false information is supplied toward securing the permit/any unauthorized changes are made to the site/any unauthorized changes are made in the installation of the system. Improvement Permit with plat valid without expiration. Improvement Permit with site plan valid for sixty months. Authorization to Construct is valid for a period equal to that of Improvement Permit – not to exceed sixty months.

Signed: Bradley C. Pierce date 3/23/2000 Installed by: Orbison

Improvement Permit by: Maria H. Dotson RS date 3/23/2000 Operation Permit by: Maria H. Dotson RS date 9/22/2000

Authorization to Construct by: Maria H. Dotson RS date 3/23/2000 Existing System Inspection by: ~~—~~ date ~~—~~

HEALTH DEPT. COPY: WHITE OWNER COPY (FINAL): YELLOW OWNER COPY (INITIAL): PINK