4669718426 4/24/95

IREDELL COUNTY HEALTH DEPARTMENT

STATESVILLE 704-878-5305 MOORESVILLE 704-664-5281

IMPROVEMENT PERMIT / CERTIFICATE OF COMPLETION / OPERATION PERMIT / EXISTING SYSTEM INSPECTION

PROPERTY DESCRIPTION NO. 20888 DATE 4/25/95 TAX MAP NO. 4C-C-11 Watershed: ☐ Yes ☒ No

OWNER OR CONTRACTOR Charles H Pierce PHONE: Business 662-2478 Home

ADDRESS 691 Meyers Rd. Mooresville, NC. 28115

LOCATION gravel road on (L) before the big house

SUBDIVISION BLOCK / SECTION LOT Block 175 LOT AREA SITE CLASS. DESIGN FLOW L.T.A.R.

Septic Tank: 1000 Gallons; STB 794 Date 3/14/95

Pump Tank: Gallons; PT Date

Pump Make: Model Serial No.

Nitrification Field: No Fields 1 Square Feet 800 Linear Feet ~~266~~

No Lines 2 Trench Width 3' Max Trench Bottom Depth 36" Gravel Depth 36"

☒ New System ☐ Repair System Type: I (II) III, IV, V, VI

System Description: Conv - Dist Box

Repair System Description:

Maintenance Agreement Required: ☐ Yes ☒ No

☒ House/Mod. Home No. Bedrooms 2

☐ Mobile Home No. Bathrooms 2

☐ Business No. Employees

☐ Other


☐ Slab ☒ Crawl Space ☐ Basement w/plumbing ☐ Basement wo/plumbing

Water Supply: ☒ Individual ☐ Community ☐ Public

Comments: Contour lines tricky - follow as closely as possible

Comments: sketch as drawn.

INITIAL SITE SKETCH

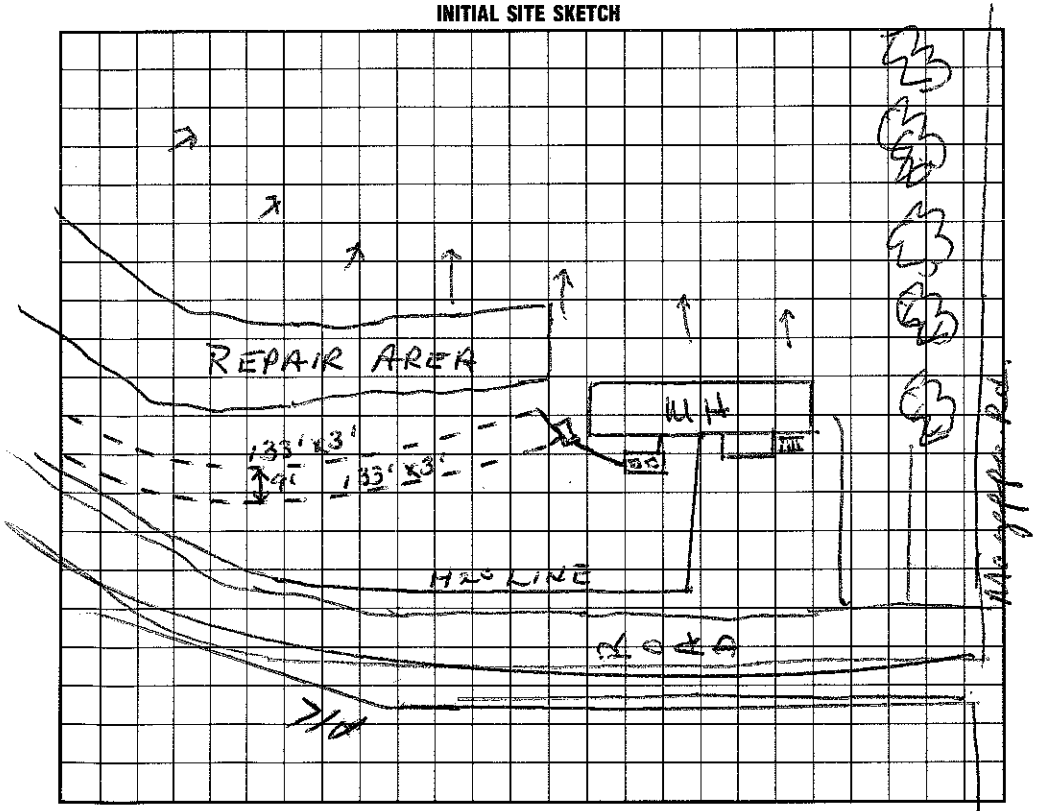

AS BUILT SKETCH

I understand that this permit can be suspended or revoked if any false information is supplied toward securing the permit/any unauthorized changes are made to the site/any unauthorized changes are made in the installation of the system. Improvement Permit is valid for 60 months from date of issuance.

Signed: Charles H Pierce

Improvement Permit by: Wesley Sparks R.S. date 4/25/95

Existing System Inspection by: date

Installed by: Wayne Dalrymple

Certificate of Completion by: Wesley Sparks R.S. date 5/24/95

Operation Permit by: date

HEALTH DEPT. COPY: WHITE INSPECTION COPY (FINAL): GREEN OWNER COPY (FINAL): YELLOW INSPECTION COPY (INITIAL): PINK OWNER COPY (INITIAL): GOLD