IREDELL COUNTY HEALTH DEPARTMENT

Authorization to Construct

STATESVILLE 704-878-5305 MOORESVILLE 704-664-5281

3B

IMPROVEMENT PERMIT / ~~CERTIFICATE OF COMPLETION~~ / OPERATION PERMIT / EXISTING SYSTEM INSPECTION

PROPERTY DESCRIPTION NO. 070097 DATE 12/16/97 TAX MAP NO. 4669765969 Watershed: ☐ Yes ☒ No

OWNER OR CONTRACTOR Waldo Builders PHONE: Business 662-9468 Home

ADDRESS PO Box 1425 Mooresville, NC. 28115

LOCATION 2 IN TR Shinnville Rd, TR Winthrow Creek Rd on (L) past Johns Pond Lane

SUBDIVISION Winthrow Creek F BLOCK/SECTION LOT 10 LOT AREA .75Ac SITE CLASS. PS DESIGN FLOW 360 L.T.A.R. .3

Septic Tank: 1000 Gallons; STB 794 Date 01/5/98

Pump Tank: 1000 Gallons; PT 27 Date 6/13/96

Pump Make: Hydromatic Model SK50 Serial No. 6/96

Nitrification Field: No Fields 1 Square Feet 1200 Linear Feet 400

No Lines 4 Trench Width 36" Max Trench Bottom Depth 36" Gravel Depth 12"

☒ New System ☐ Repair System Type: I, II, (III), IV, V, VI

System Description: Pres Man → Conventional

Repair System Description: Same

Maintenance Agreement Required: ☐ Yes ☒ No

☒ House/Mod. Home No. Bedrooms 3

☐ Mobile Home No. Bathrooms 2

☐ Business No. Employees

☐ Other


☐ Slab ☐ Crawl Space ☒ Basement w/plumbing ☐ Basement wo/plumbing

Water Supply: ☒ Individual ☐ Community ☐ Public


Comments:

Comments:

INITIAL SITE SKETCH

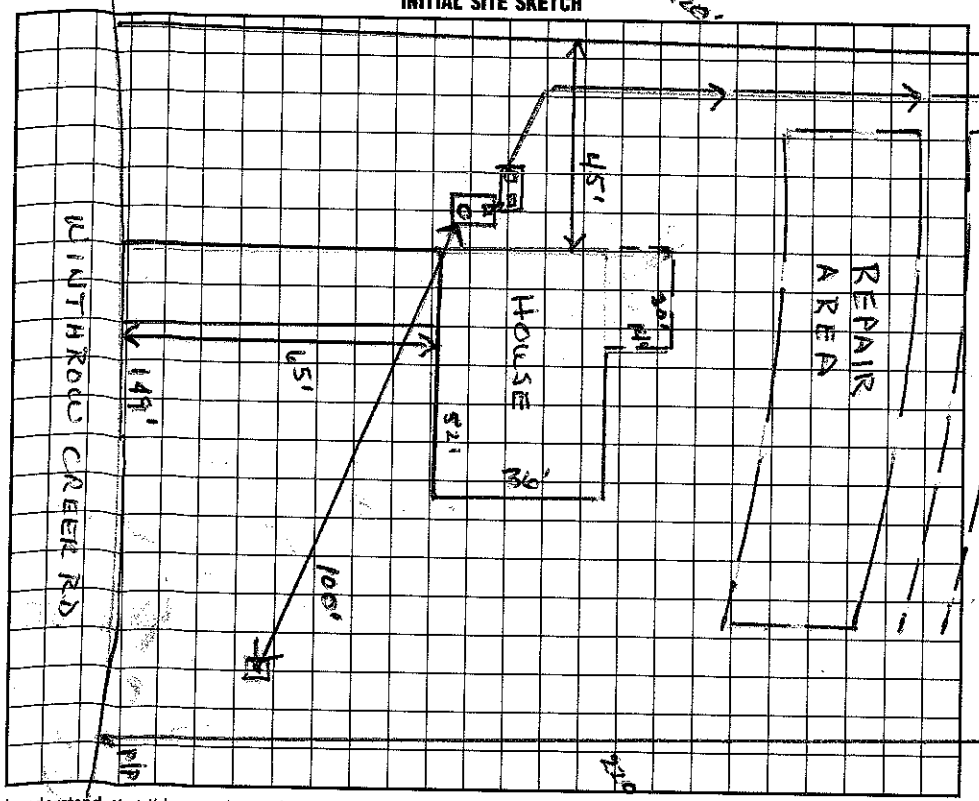

AS BUILT SKETCH

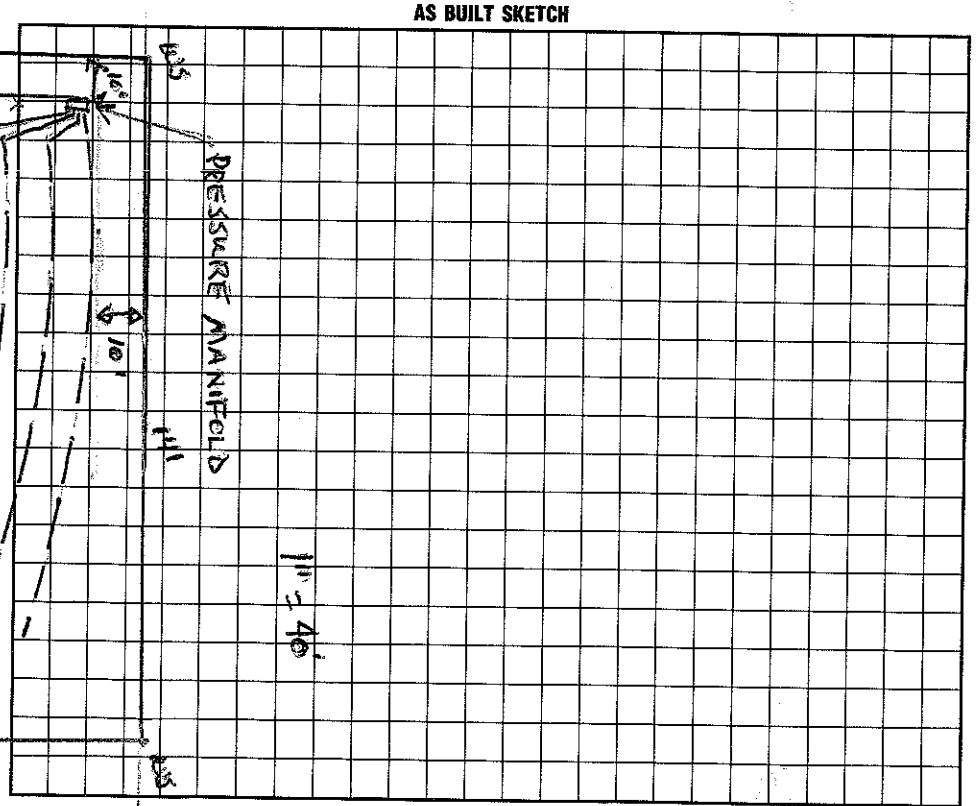

I understand that this permit can be suspended or revoked if any false information is supplied toward securing the permit/any unauthorized changes are made to the site/any unauthorized changes are made in the installation of the system. Improvement Permit is valid for 60 months from date of issuance.

Signed:

Improvement Permit by: Wesley Sparks R.S. date 12/16/97

Existing System Inspection by: Wesley Sparks R.S. date 12/16/97

Installed by: Tim Ammons

Certificate of Completion by: date

Operation Permit by: R.S. date 8/27/98

HEALTH DEPT. COPY: WHITE INSPECTION COPY (FINAL): GREEN OWNER COPY (FINAL): YELLOW INSPECTION COPY (INITIAL): PINK OWNER COPY (INITIAL): GOLD