IREDELL COUNTY HEALTH DEPARTMENT

Auth to Construct 4669770043

ATESVILLE 704-878-5305 MOORESVILLE 704-664-5281

IMPROVEMENT PERMIT / ~~CERTIFICATE OF COMPLETION~~ / OPERATION PERMIT / EXISTING SYSTEM INSPECTION

PROPERTY DESCRIPTION NO. 23117 DATE 3/4/96 TAX MAP NO. 4H 1 A 2 Watershed: ☐ Yes ☒ No

OWNER OR CONTRACTOR F Russell Gibson PHONE: Business _____ Home 875-6100

ADDRESS 209 Gilliard Rd. Huntersville, NC 28078

LOCATION Winthrow Creek Rd; Shinnville Rd. TR Winthrow Creek X bridge to top of hill Winthrow Creek Farm TL lot on L

SUBDIVISION Winthrow Creek F BLOCK# SECTION _____ LOT 2 LOT AREA 5 AC SITE CLASS. PS DESIGN FLOW 360 L.T.A.R. .3

Septic Tank: 1000 Gallons; STB 794 Date 3-19-96

Pump Tank: _____ Gallons; PT _____ Date _____

Pump Make: _____ Model _____ Serial No. _____

Nitrification Field: No Fields 1 Square Feet 1200 Linear Feet *300

No Lines 4 Trench Width 36" Max Trench Bottom Depth 30" Gravel Depth 6" SAND

☒ New System ☐ Repair System Type: I, II, (III), IV, V, VI

System Description: *Chamberd Plastic

Repair System Description: PPBS - 16"

Maintenance Agreement Required: ☐ Yes ☐ No

☒ House/Mod. Home ☐ Mobile Home ☐ Business ☐ Other No. Bedrooms 3 No. Bathrooms 2 No. Employees _____


☐ Slab ☒ Crawl Space ☐ Basement w/plumbing ☐ Basement wo/plumbing

Water Supply: ☒ Individual ☐ Community ☐ Public


Comments: Sand backfill to top of pavers on each pond section.

Comments:

INITIAL SITE SKETCH

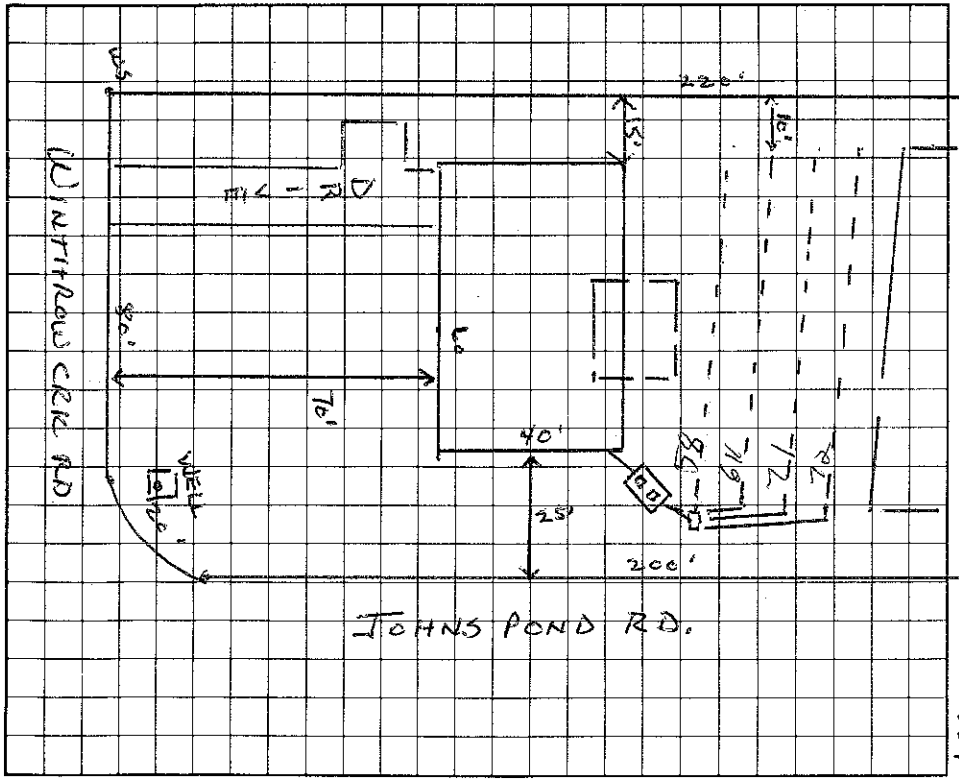

AS BUILT SKETCH

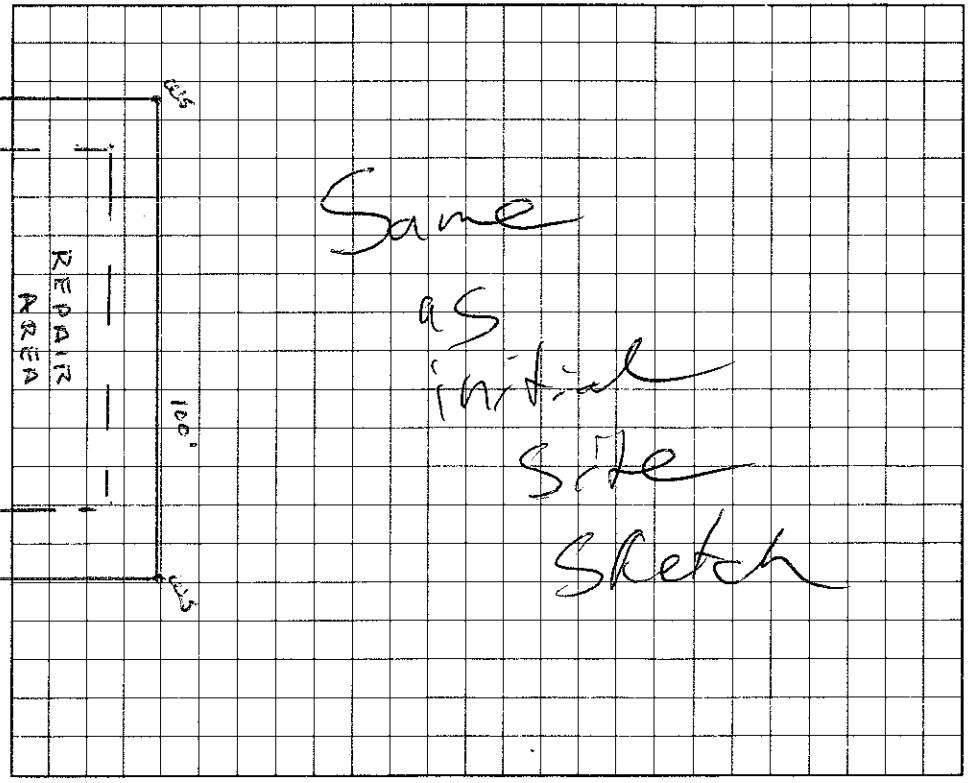

Same as initial site sketch

I understand that this permit can be suspended or revoked if any false information is supplied toward securing the permit/any unauthorized changes are made to the site/any unauthorized changes are made in the installation of the system.

Auth to construct valid 5 years

Signed: Russell Gibson Installed by: Tim Ammons

Improvement Permit by: Wesley Sparks R.S. date 3/4/96 Certificate of Completion by: _____ date _____

Existing System Inspection by: Wesley Sparks R.S. date 3/4/96. Operation Permit by: Cc Buddy Price EHS date 6/20/96

HEALTH DEPT. COPY: WHITE INSPECTION COPY (FINAL): GREEN OWNER COPY (FINAL): YELLOW INSPECTION COPY (INITIAL): PINK OWNER COPY (INITIAL): GOLD