4160977 1091

IREDELL COUNTY HEALTH DEPARTMENT

STATESVILLE 704-878-5305 MOORESVILLE 704-664-5281

IMPROVEMENT PERMIT / CERTIFICATE OF COMPLETION / OPERATION PERMIT / EXISTING SYSTEM INSPECTION

PROPERTY DESCRIPTION NO. 17189 DATE 10/29/93 TAX MAP NO. 4H-1-A-7 Watershed: ☒ Yes ☐ No

OWNER OR CONTRACTOR JOHN W SANDERS PHONE: Business _____ Home 663-2510

ADDRESS 302 E IREDELL AVE. MOORESVILLE, NC.

LOCATION WINTHROW CRK RD. OFF STATESVILLE, TL LOT ON ® CORNER

SUBDIVISION WINTHROW CRK BLOCK / SECTION _____ LOT 7 LOT AREA .6 SITE CLASS. P DESIGN FLOW 360 L.T.A.R. .2-.25

Septic Tank: 1000 Gallons; STB 1012 Date 8/21/94

Pump Tank: _____ Gallons; PT _____ Date _____

Pump Make: _____ Model _____ Serial No. _____

Nitrification Field: No Fields 1 Square Feet _____ Linear Feet 280 ±

No Lines 4 Trench Width 2' Max Trench Bottom Depth 28" ~~Sand~~ Gravel Depth 6" UNDER

☒ New System ☐ Repair System Type: I, II, (III) IV, V, VI

System Description: 16" PPBS

Repair System Description: 16" PPBS

Maintenance Agreement Required: ☐ Yes ☒ No

☒ House/Mod. Home No. Bedrooms 3

☐ Mobile Home No. Bathrooms 2

☐ Business No. Employees _____


☐ Other _____

☐ Slab ☐ Crawl Space ☐ Basement w/plumbing ☐ Basement wo/plumbing

Water Supply:
☒ Individual
☐ Community
☐ Public

Comments: ~~*~~ 16" PANEL BLOCK SYSTEM
28" MAX. TRENCH BOTTOM
WS LINES ON SLOPE CONTOUR

INITIAL SITE SKETCH

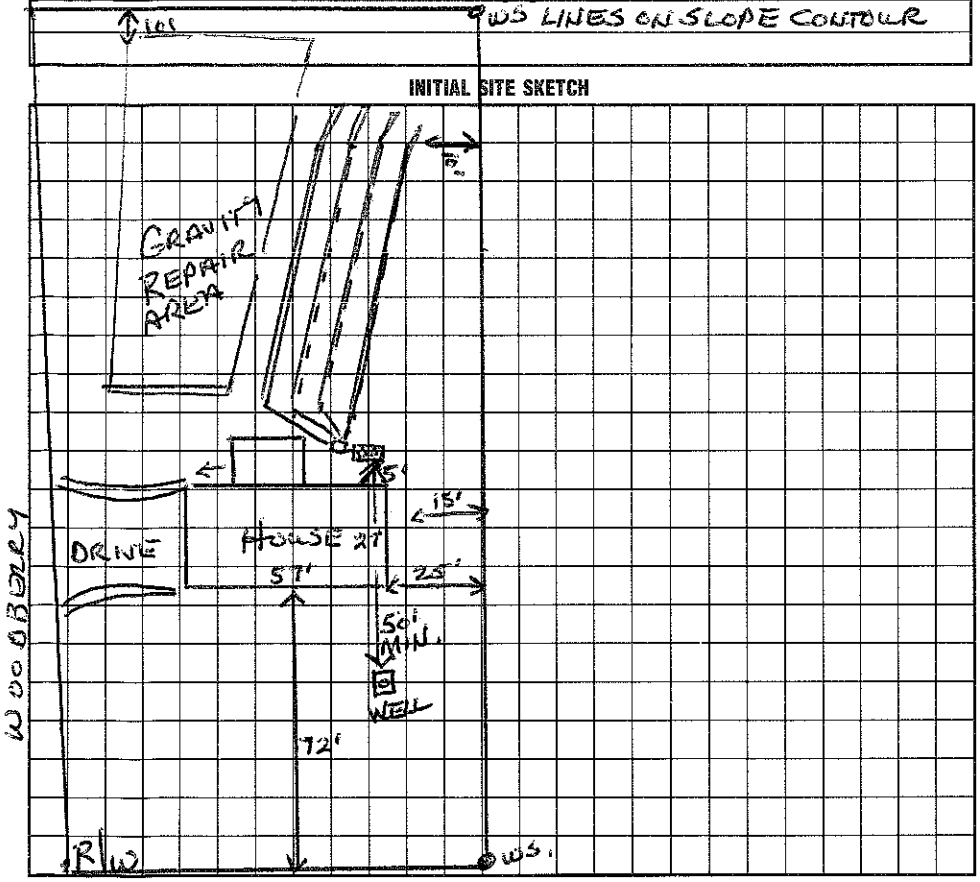

Comments: installed as shown.

AS BUILT SKETCH

I understand that this permit can be suspended or revoked if any false information is supplied toward securing the permit/any unauthorized changes are made to the site/any unauthorized changes are made in the installation of the system. Improvement Permit is valid for 60 months from date of issuance.

Signed: WINTHROW CRK. John W Sanders

Improvement Permit by: Wesley Sparks R.S. date 10/29/93

Existing System Inspection by: _____ date _____

Installed by: Richard Abernathy

Certificate of Completion by: Wesley Sparks R.S. date 10/20/94

Operation Permit by: _____ date _____

HEALTH DEPT. COPY: WHITE INSPECTION COPY (FINAL): GREEN OWNER COPY (FINAL): YELLOW INSPECTION COPY (INITIAL): PINK OWNER COPY (INITIAL): GOLD