PW# 4669-77-1892 350.00 Eq.P 11:15

IREDELL COUNTY HEALTH DEPARTMENT

STATESVILLE 704-878-5305 MOORESVILLE 704-664-5281

IMPROVEMENT PERMIT / AUTHORIZATION TO CONSTRUCT / OPERATION PERMIT / EXISTING SYSTEM INSPECTION

PERMIT# 138506 PIN# ~~4760-71-6443~~ Craig DATE 11-22-06

OWNER OR APPLICANT L&M Construction / Dirty Mc Acres PHONE: Business 662-2204 Home

ADDRESS 137 Bridlepath Ln Mooresville, NC 28117

LOCATION 320 Bullet Ln — Shinnville Rd TR Bullet Ln through gates on right

SUBDIVISION BLOCK / SECTION LOT LOT AREA SITE CLASS. PS DESIGN FLOW 100 g L.T.A.R. .03

Septic Tank: 1000 Gallons; STB 794 Date 6-11-06
Pump Tank: Gallons; PT Date
Pump Make: Model Serial No.
Nitrification Field: No Fields 1 Square Feet 330' Linear Feet 110 ft
No Lines 2055' Trench Width 36" Max Trench Bottom Depth 36" Gravel Depth 12"

☒ New System ☐ Repair ☐ Expansion System Type: I II III IV V VI
System Description: Gravity - Conventional
Repair System Description: Gravity - Innovative
Maintenance Agreement Required: ☐ Yes ☐ No

☐ House/Mod. Home No. Bedrooms
☐ Mobile Home No. Persons
☐ Business No. Employees
☒ Other Personal Shop


Water Supply: ☒ Individual ☐ Public ☐ Community

☒ Gravity ☐ Pressure ☒ Slab ☐ Crawl Space ☐ Basement w/plumbing ☐ Basement wo/plumbing

Comments:/Conditions:

Comments:/Conditions:

INITIAL SITE SKETCH ~~Not to Scale~~

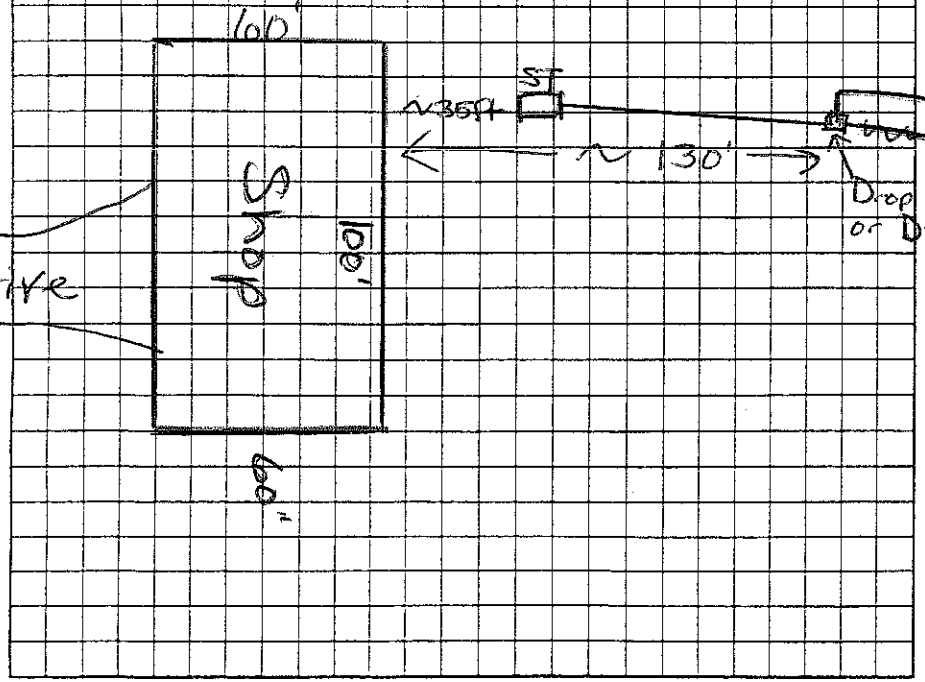

AS BUILT SKETCH

Installed 1 line @ 84ft (25% Reduction) @ Quick 4

Permit can be suspended or revoked if any false information is supplied toward securing the permit/any unauthorized changes are made to the site/any unauthorized changes are made in the installation of the system. Improvement Permit with plat valid without expiration ☐ Improvement Permit with site plan valid for sixty months ☐ Authorization to Construct is valid for a period equal to that of Improvement Permit – not to exceed sixty months.

Signed: Craig W. date 12/1/06 Installed by: Curt Dunnagan

Improvement Permit by: Maria H. Dotson RS date 11/29/06 Operation Permit by: Maria H. Dotson RS date 12/4/06

Authorization to Construct by: Maria H. Dotson RS date 11/29/06 Existing System Inspection by: date

HEALTH DEPT. COPY: WHITE OWNER COPY (FINAL): YELLOW OWNER COPY (INITIAL): PINK