IREDELL COUNTY HEALTH DEPARTMENT

STATESVILLE 704-878-5305 MOORESVILLE 704-664-5281

IMPROVEMENT PERMIT / CERTIFICATE OF COMPLETION / OPERATION PERMIT / EXISTING SYSTEM INSPECTION

PROPERTY DESCRIPTION NO. 17717 DATE 1/24/94 TAX MAP NO. 4H 1A 11 4609772250 Watershed: ☐ Yes ☒ No

OWNER OR CONTRACTOR DOUGLAS WALDO PHONE: Business _____ Home 664-5255

ADDRESS Rt 6 Box 436 MOORESVILLE, NC. 28115

LOCATION WINTHROW CREEK TR OFF SHINNERS RD, X CREEK TL TO 2ND LOT ON (R)

SUBDIVISION WINTHROW CRK BLOCK / SECTION _____ LOT 11 LOT AREA ~1.1 AC SITE CLASS. P DESIGN FLOW 360 L.T.A.R. .3

Septic Tank: 1000 Gallons; STB 94 Date 4/21/94
Pump Tank: _____ Gallons; PT _____ Date _____
Pump Make: _____ Model _____ Serial No. _____
Nitrification Field: No Fields 1 Square Feet 1200 Linear Feet ✱ 200
No Lines 4 Trench Width 2' Max Trench Bottom Depth 36" Gravel Depth 6" STONE

☐ New System ☐ Repair System Type: I, II, III, IV, V, VI
System Description: PPBS 16"
Repair System Description: SAME
Maintenance Agreement Required: ☐ Yes ☒ No

☒ House/Mod. Home No. Bedrooms 3
☐ Mobile Home No. Bathrooms 2
☐ Business No. Employees _____
☐ Other _____


☐ Slab ☒ Crawl Space ☐ Basement w/plumbing ☐ Basement wo/plumbing

Water Supply:
☒ Individual
☐ Community
☐ Public

Comments:

Comments: installed as shown.

INITIAL SITE SKETCH

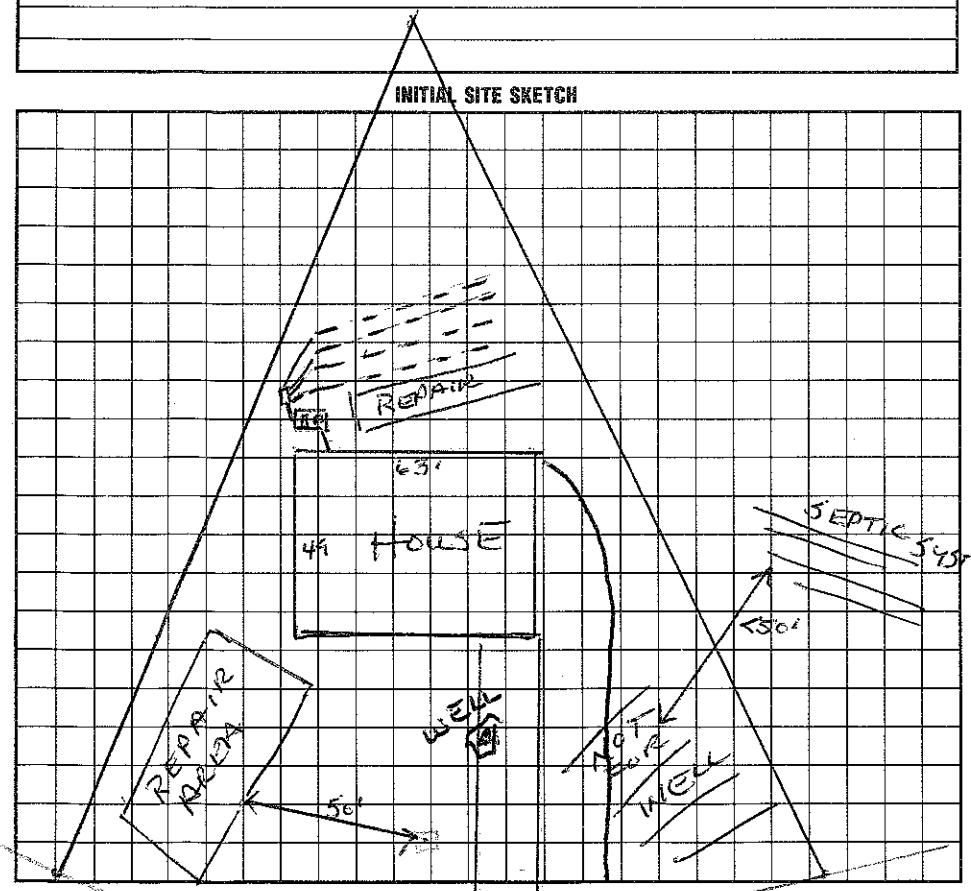

AS BUILT SKETCH

I understand that this permit can be suspended or revoked if any false information is supplied toward securing the permit/any unauthorized changes are made to the site/any unauthorized changes are made in the installation of the system. Improvement Permit is valid for 60 months from date of issuance.

Signed: Douglas Waldo

Improvement Permit by: Wesley Sparks RS. date 1/24/94

Existing System Inspection by: _____ date _____

Installed by: Waldo Simpson Const Co.

Certificate of Completion by: Wesley Sparks RS. date 6/8/94

Operation Permit by: _____ date _____

HEALTH DEPT. COPY: WHITE INSPECTION COPY (FINAL): GREEN OWNER COPY (FINAL): YELLOW INSPECTION COPY (INITIAL): PINK OWNER COPY (INITIAL): GOLD