IREDELL COUNTY HEALTH DEPARTMENT

STATESVILLE 704-878-5305 MOORESVILLE 704-664-5281

IMPROVEMENT PERMIT / AUTHORIZATION TO CONSTRUCT / OPERATION PERMIT / EXISTING SYSTEM INSPECTION

PERMIT# 107848 PIN# 4669773010 DATE 7/26/2002

OWNER OR CONTRACTOR Leche Home Builders PHONE: Business Home (704) 507-7646

ADDRESS 317 Winthrow Creek Rd Mooresville, NC 28115 (311 WINTHROW CRK RD.)

LOCATION Shinnville Rd. TR Winthrow Ck ~ 1/2 mile on left just past entrance to Winthrow Ck.

SUBDIVISION Winthrow Ck BLOCK / SECTION LOT 8 LOT AREA SITE CLASS. PSJ DESIGN FLOW 360 gpd L.T.A.R. .3 - .3 +

Septic Tank: 1000 Gallons; STB 825 Date 10/5/02

Pump Tank: Gallons; PT Date

Pump Make: Model Serial No.

Nitrification Field: No Fields Square Feet 1200' Linear Feet 390'

No Lines 3@133' Trench Width 36" Max Trench Bottom Depth 18" Gravel Depth 12"

☒ New System ☐ Repair System Type: I, II, III, IV, V, VI

System Description: Gravity-Conventional

Repair System Description: Gravity-Innovative

Maintenance Agreement Required: ☐ Yes ☒ No

☒ House/Mod. Home No. Bedrooms 3

☐ Mobile Home No. Bathrooms 2

☐ Business No. Employees

☐ Other


☒ Slab ☐ Crawl Space ☐ Basement w/plumbing ☐ Basement wo/plumbing

Water Supply: ☒ Individual ☐ Public ☐ Community

Comments/Conditions: * Okay to do 4@100' instead Stay 10' from PL & 100' From well.

Comments/Conditions: 4@100"x3'

INITIAL SITE SKETCH Scale 1:50

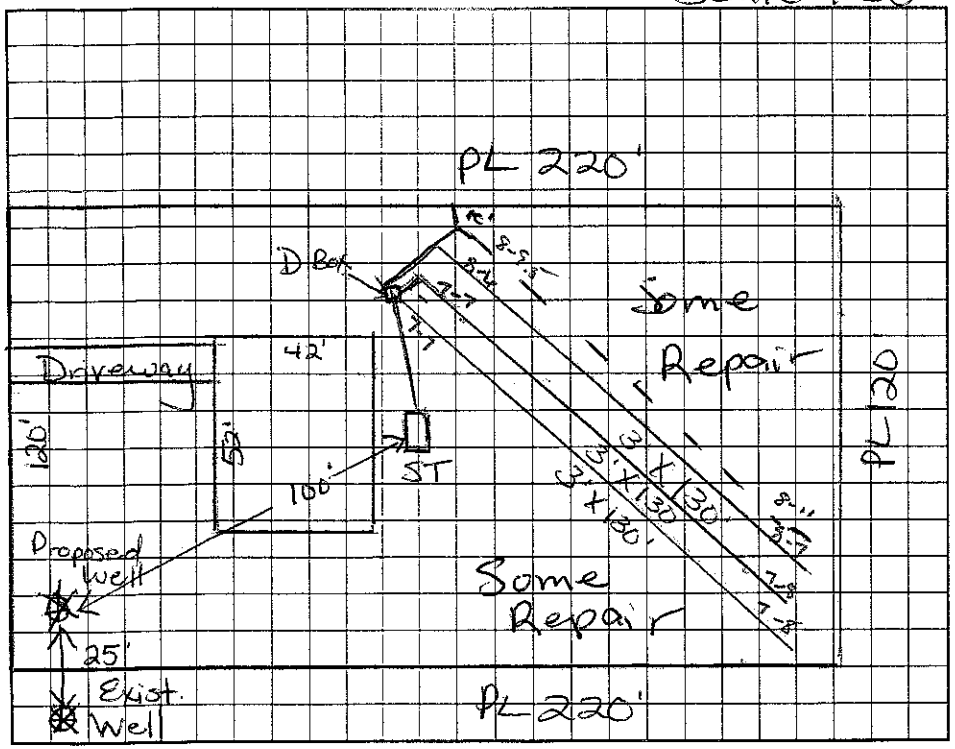

AS BUILT SKETCH

Permit can be suspended or revoked if any false information is supplied toward securing the permit/any unauthorized changes are made to the site/any unauthorized changes are made in the installation of the system. Improvement Permit with plat valid without expiration. Improvement Permit with site plan valid for sixty months. Authorization to Construct is valid for a period equal to that of Improvement Permit – not to exceed sixty months.

Signed: Debbie A. Yulinsky R.S. date 7/29/02 Installed by: Kenny Williams Grading & Hauling

Improvement Permit by: Maria H. Dotson R.S. date 7/26/2002 Operation Permit by: Wesley Sparks R.S. date 12/18/02

Authorization to Construct by: Maria H. Dotson R.S. date 7/26/2002 Existing System Inspection by: date

HEALTH DEPT. COPY: WHITE OWNER COPY (FINAL): YELLOW OWNER COPY (INITIAL): PINK