IREDELL COUNTY HEALTH DEPARTMENT

Authorization to Construct

STATESVILLE 704-878-5305 MOORESVILLE 704-664-5281

IMPROVEMENT PERMIT / ~~CERTIFICATE OF COMPLETION~~ / OPERATION PERMIT / EXISTING ~~SYSTEM~~ INSPECTION

PROPERTY DESCRIPTION NO. 26394 DATE 5/1/97 TAX MAP NO. 4669774020

OWNER OR CONTRACTOR ROBERT J TULBRIDY JR. PHONE: Business Home 664-5255 Watershed: ☐ Yes ☒ No

ADDRESS 177 LAKELAND RD. MRSVL, NC 28115

LOCATION WINTHROW CRK RD., SHINNVILLE RD TR WINTHROW CRK, X CRK ON (L) PAST WINTHROW E ST RD, 2ND LOT

SUBDIVISION WINTHROW CREEK BLOCK / SECTION LOT 9 LOT AREA 1.6 AC SITE CLASS. PS DESIGN FLOW 360 L.T.A.R. .3

Septic Tank: 1000 Gallons; STB 825 Date 7/15/97

Pump Tank: Gallons; PT Date

Pump Make: Model Serial No.

Nitrification Field: No Fields 1 Square Feet 1200 Linear Feet 400

No Lines 5 Trench Width 36" Max Trench Bottom Depth 30" Gravel Depth 12"

☒ New System ☐ Repair System Type: I (II) III, IV, V, VI

System Description: CONV-DBCK-SPEED LVLRS

Repair System Description: PRES - CH PLASTIC

Maintenance Agreement Required: ☐ Yes ☒ No

☒ House/Mod. Home ☐ Mobile Home ☐ Business ☐ Other

No. Bedrooms 3 No. Bathrooms 1.5 No. Employees


☐ Slab ☐ Crawl Space ☐ Basement w/plumbing ☒ Basement wo/plumbing

Water Supply: ☒ Individual ☐ Community ☐ Public


Comments: TANK AND DRAINFIELD MUST BE 25' FROM BASEMENT WALL OK exactly 25'

Comments: ☒ Well not installed at time of inspection.

INITIAL SITE SKETCH

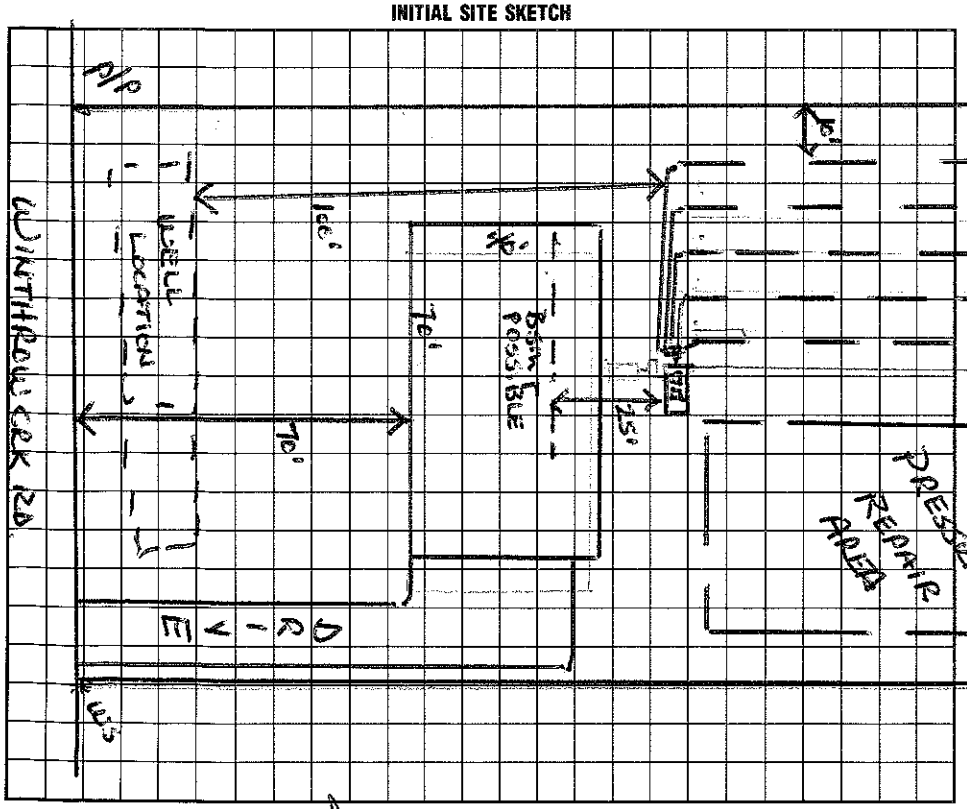

AS BUILT SKETCH

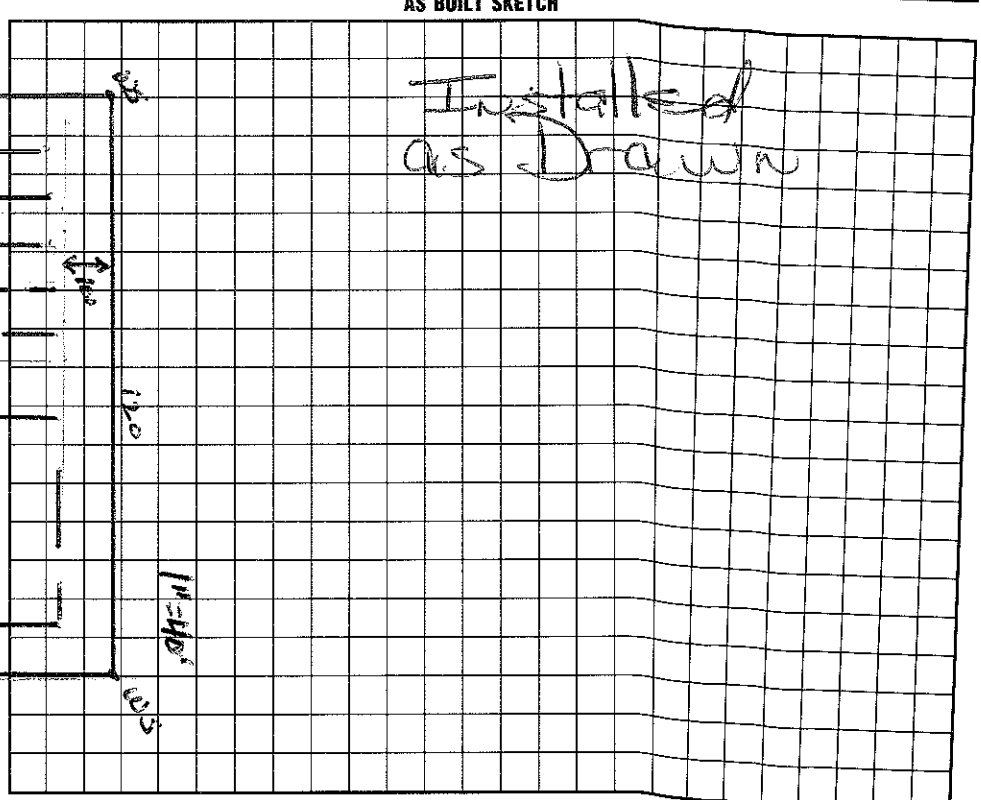

I understand that this permit can be suspended or revoked if any false information is supplied toward securing the permit/any unauthorized changes are made to the site/any unauthorized changes are made in the installation of the system. This Improvement Permit is valid for 60 months from date of issuance.

Wesley Sparks RS. date 5/1/97

Wesley Sparks RS. date 5/1/97

Installed by: Williams Grading

Certificate of Completion by: Martin H. Dotson date 9/17/97

Operation Permit by: Martin H. Dotson date

INSPECTION COPY (FINAL): GREEN OWNER COPY (FINAL): YELLOW INSPECTION COPY (INITIAL): PINK OWNER COPY (INITIAL): GOLD