$130

IREDELL COUNTY HEALTH DEPARTMENT

STATESVILLE 704-878-5305 MOORESVILLE 704-664-5281

IMPROVEMENT PERMIT / AUTHORIZATION TO CONSTRUCT / OPERATION PERMIT / EXISTING SYSTEM INSPECTION

PERMIT# 119165 PIN# 4669 77 5559 DATE 4/7/06

OWNER OR APPLICANT Dream Works Enterprises PHONE: Business 704-526-8369 Home

ADDRESS 516 River Hwy Suite D # 135

LOCATION 115 N TR Shinnville Rd. TR Winthrow Creek Rd. X Creek TL Johns Pond Ln. end on R

SUBDIVISION Winthrow Creek ~~Tract~~ SECTION LOT 15 LOT AREA .89 SITE CLASS. PS DESIGN FLOW 480 L.T.A.R. .3

Septic Tank: 1000 Gallons; STB 1012 Date 3/16/06
Pump Tank: Gallons; PT Date
Pump Make: Model Serial No.
Nitrification Field: No Fields 1 Square Feet 1200 Linear Feet 400
No Lines 4 Trench Width 3' Max Trench Bottom Depth 3'

X New System ☐ Repair ☐ Expansion System Type: I II III IV V VI
System Description: GRAVITY - 25% - Reduced
Repair System Description: GRAVITY - 16" PPBPS
Maintenance Agreement Required: ☐ Yes X No


X House/Mod. Home No. Bedrooms 4
☐ Mobile Home No. Persons
☐ Business No. Employees
☐ Other

Water Supply: X Individual ☐ Public ☐ Community

Gravel Depth No ☐ Gravity ☐ Pressure ☐ Slab X Crawl Space ☐ Basement w/plumbing ☐ Basement wo/plumbing

Comments:/Conditions:

INITIAL SITE SKETCH

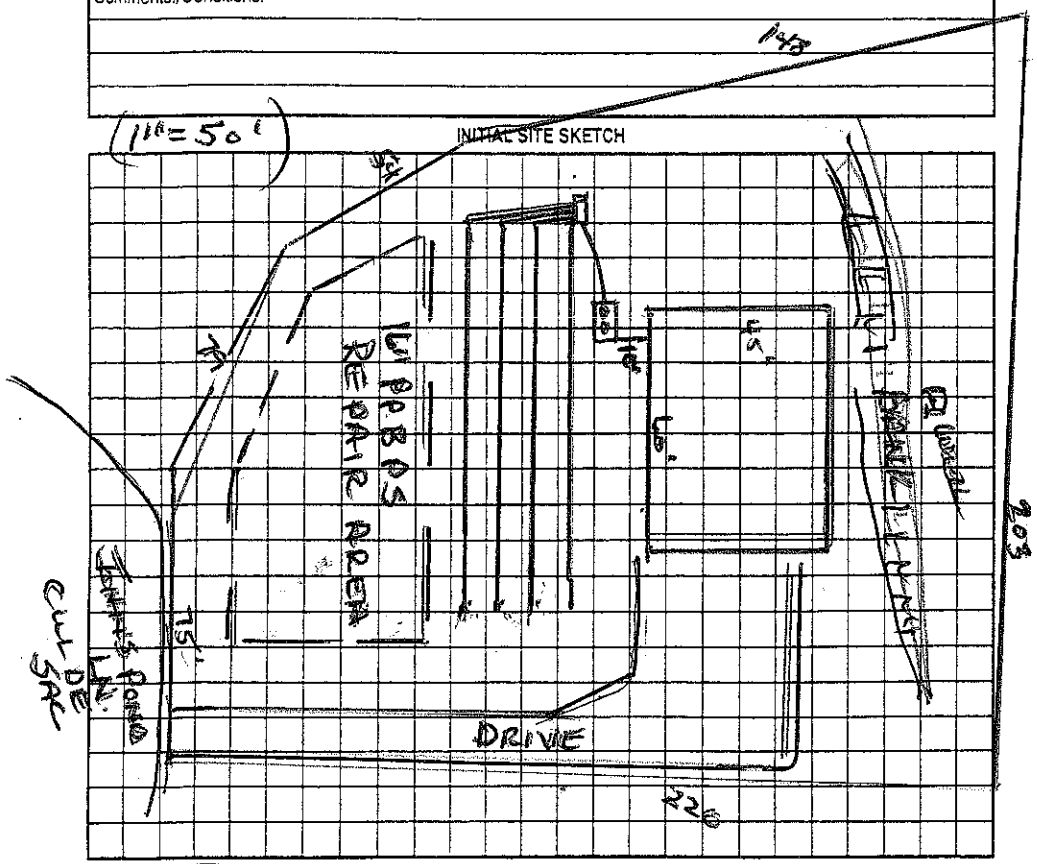

Comments:/Conditions:

AS BUILT SKETCH

Permit can be suspended or revoked if any false information is supplied toward securing the permit/any unauthorized changes are made to the site/any unauthorized changes are made in the installation of the system. Improvement Permit with plat valid without expiration ☐ Improvement Permit with site plan valid for sixty months ☐ Authorization to Construct is valid for a period equal to that of Improvement Permit – not to exceed sixty months.

Signed: Pamela Davis date

Improvement Permit by: Wesley Sparks RS date 4/7/06

Authorization to Construct by: Wesley Sparks RS date 4/7/06

Installed by: Piedmont Backhoe

Operation Permit by: Wesley Sparks RS date 7/24/06

Existing System Inspection by: date

HEALTH DEPT. COPY: WHITE OWNER COPY (FINAL): YELLOW OWNER COPY (INITIAL): PINK