3:30

IREDELL COUNTY HEALTH DEPARTMENT

STATESVILLE 704-878-5305 MOORESVILLE 704-664-5281

IMPROVEMENT PERMIT / AUTHORIZATION TO CONSTRUCT / OPERATION PERMIT / EXISTING SYSTEM INSPECTION

PERMIT # Repair PIN # 4669778036 DATE 2-28-2011

OWNER or APPLICANT DMA (Sonny Lunsford) PHONE: Business 704 791-6601 Home: 704 799 4800

OWNER or APPLICANT ADDRESS 341 Winthrow Creek Mooresville NC 28115

LOCATION / DIRECTIONS 21/115 N TR Shinnville TR Winthrow Creek on left @ Atwell Farm Ln

SUBDIVISION ____ BLOCK / SECTION ____ LOT # ____ LOT AREA ____ DESIGN FLOW 240gpd L.T.A.R. .35

Septic Tank 1000 Gallons: STB 1012 Date 6-23-08

Pump Tank ____ Gallons: PT ____ Date ____

Pump Make ____ Model ____ Serial # ____

Nitrification Field No Fields 1 No Lines 4 Linear Feet 170ft.

Trench Width 36" Max. Trench Bottom Depth 60" Gravel Depth N/A

☐ New System ☒ Repair ☐ Expansion System Type I II III IV V VI

System Description: Gravity-Conv. Bed?

Repair System Description Gravity - 25% Reduction

Maintenance Agreement Required ☐ YES ☒ NO

☒ GRAVITY ☐ PRESSURE


☒ Residence No. Bedrooms 2 ☐ Business No. Persons ____ ☐ Other No. Employees ____ ☐ Slab ☒ Crawl Space ☐ Basement w/plumbing ☐ Basement w/o plumbing

Water Supply: ☒ Private ☐ Public ☐ Community

Comments / Conditions: Scale 1:50

Comments / Conditions: Must keep plumbing high as possible.
Keep Septic System at least 5ft from House.
50ft Setback to ST, 100ft to Drainfield.
* Drainfield will be deep to maintain gravity flow.

INITIAL SITE SKETCH

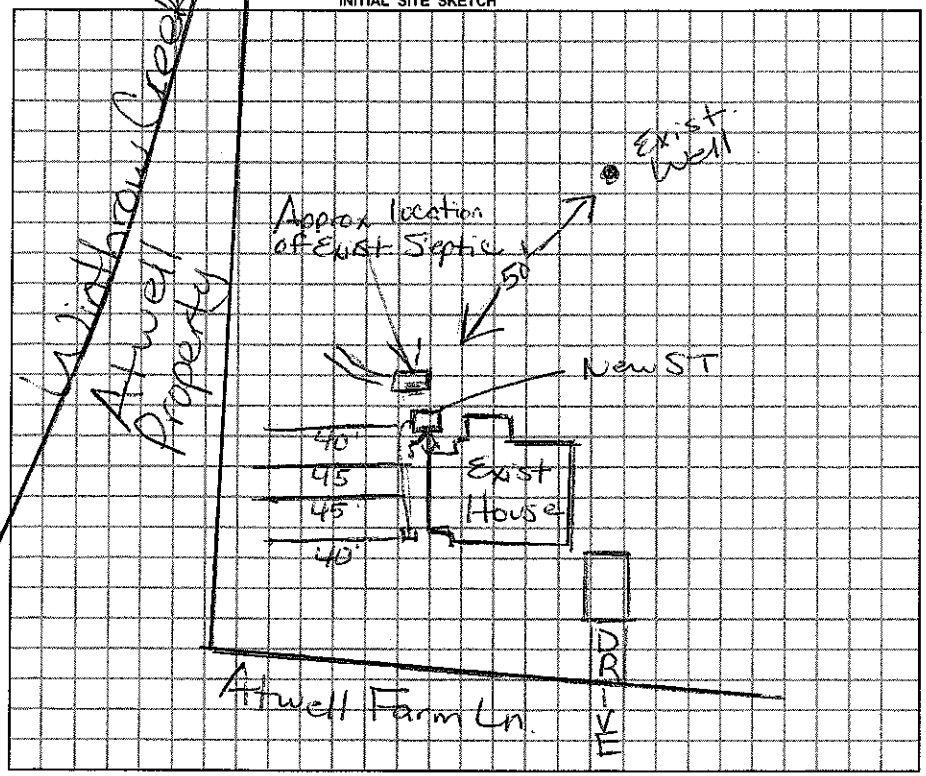

AS BUILT SKETCH

"Properly" abandon existing ST
ST 5ft From porch & House
Drainlines 5ft off Porch
Installed Quick 4
essentially as Drawn

Permit can be suspended or revoked if any false information is supplied toward securing the permit / any unauthorized changes are made to the site / any unauthorized changes are made in the installation of the system.

☐ *IMPROVEMENT PERMIT w / plat valid without expiration.* ☐ *IMPROVEMENT PERMIT w / site plan valid for 60 mps.* ☐ *AUTHORIZATION TO CONSTRUCT valid for period equal to IMPROVEMENT PERMIT-not to exceed 60 mo.*

Owner / Applicant Signature: Sonny Lunsford Date 3-1-11

Improvement Permit by: Maria H. Dotson RS Date 2/28/11

Authorzation to Construct by: Maria H. Dotson RS Date 2/28/11

Installed by: Steve Gordon RS

Operation Permit by: Maria H. Dotson Date: 3/2/2011

Existing System Inspected by: ____ Date: ____

YOU SHOULD CONTACT A LOCATOR SERVICE PRIOR TO ANY EXCAVATION.

WHITE COPY Environmental Health YELLOW COPY (Final) Owner / Applicant PINK COPY (Initial) Owner / Applicant