IREDELL COUNTY HEALTH DEPARTMENT

STATESVILLE 704-878-5305 MOORESVILLE 704-664-5281

IMPROVEMENT PERMIT / AUTHORIZATION TO CONSTRUCT / OPERATION PERMIT / EXISTING SYSTEM INSPECTION

PERMIT # 160752 PIN # 4669780963 DATE 5-5-2010

OWNER or APPLICANT DG Homes PHONE: Business 704 400-2307 Home: 704 876-7049

OWNER or APPLICANT ADDRESS 631-407 Brawley School Rd Mooresville NC 28117

LOCATION / DIRECTIONS Hwy 21 N TR Shinnville TR Twinthrow Creek TL Johns Pond Ln 0.7 thru Gates TL 1st Rd.

SUBDIVISION BLOCK / SECTION LOT # LOT AREA 1.672 DESIGN FLOW 300gpd L.T.A.R. .3

Septic Tank 1000 Gallons: STB 1012 Date 3-9-09 ☒ New System ☐ Repair ☐ Expansion System Type I ◯ II III IV V VI

Pump Tank Gallons: P T Date System Description: Gravity - 25% Reduction

Pump Make Model Serial # Repair System Description: Same

Nitrification Field No Fields 1 No Lines 3 Linear Feet 300 ft Maintenance Agreement Required ☐ YES ☒ NO

Trench Width 36" Max. Trench Bottom Depth 36" Gravel Depth N/A ☒ GRAVITY ☐ PRESSURE

☒ Residence No. Bedrooms 3 ☐ Business No. Persons ☐ Other No. Employees ☐ Slab ☐ Crawl Space ☐ Basement w/plumbing ☐ Basement w/o plumbing


Water Supply: ☒ Private ☐ Public ☐ Community

Comments / Conditions: Keep Septic System 100Ft to well.


Comments / Conditions: Okay to install 4 lines @ 75' each.

Scale 1:60

INITIAL SITE SKETCH

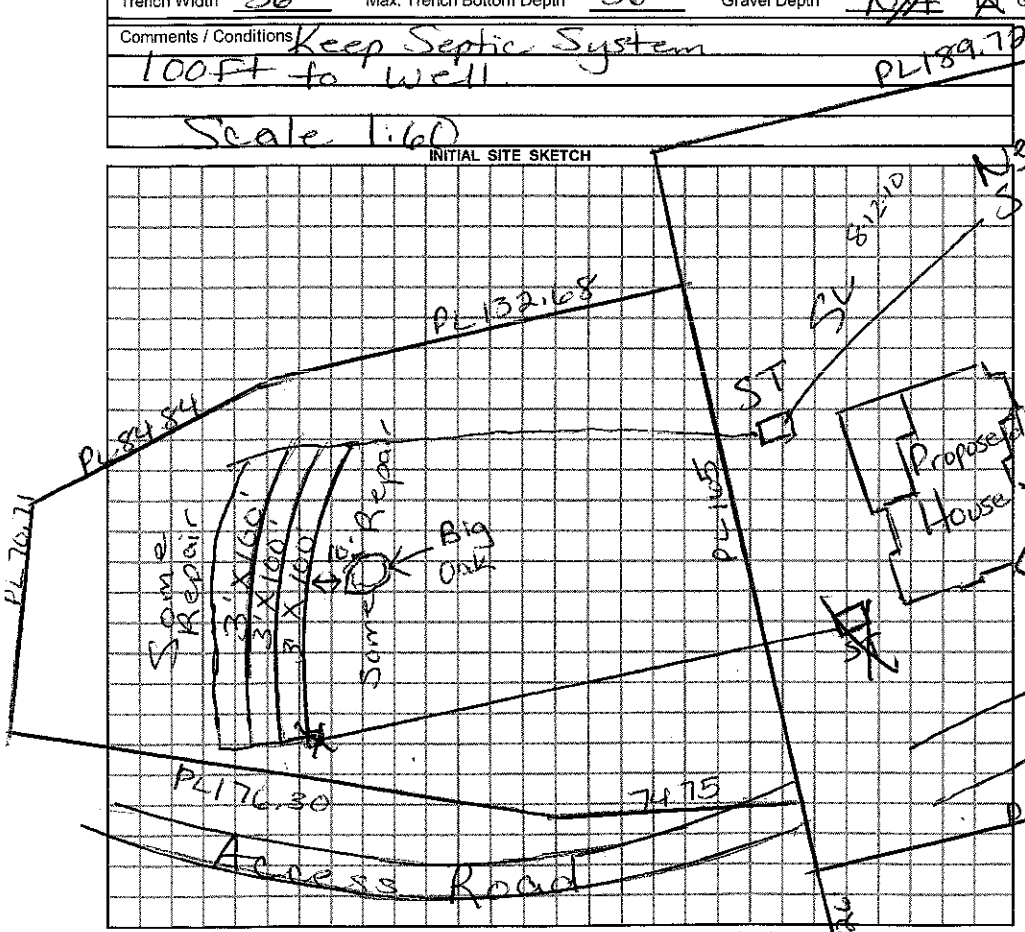

AS BUILT SKETCH

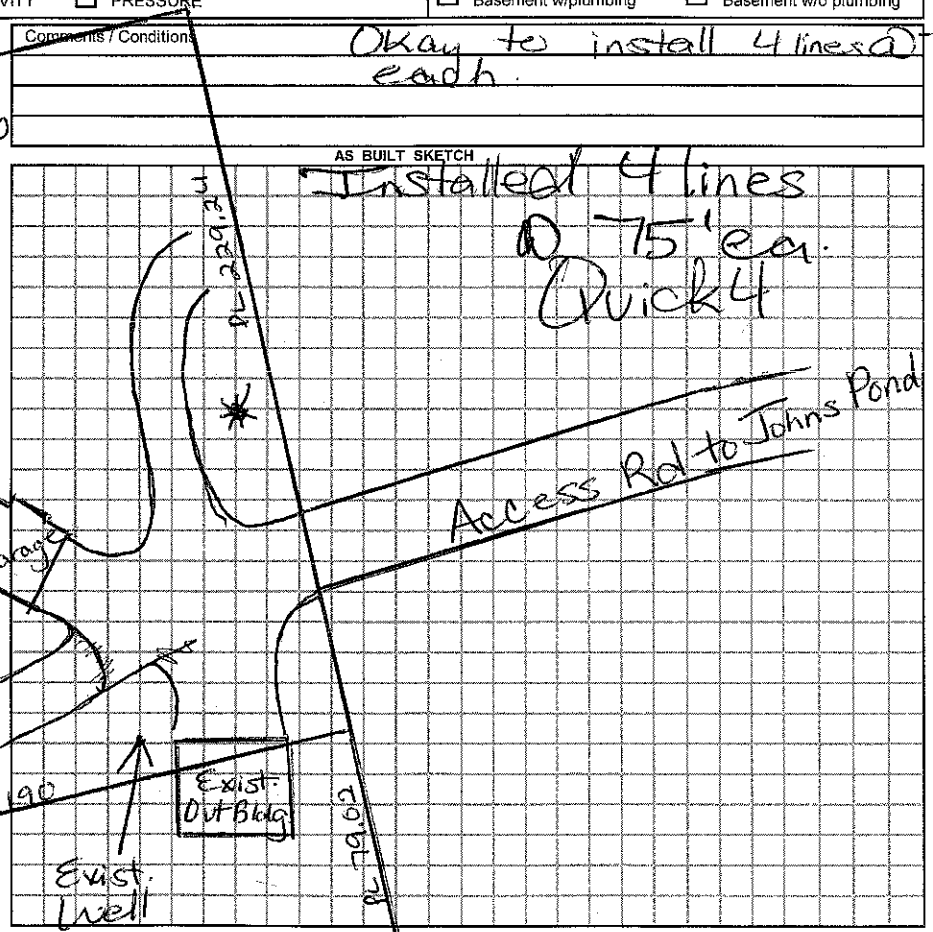

Permit can be suspended or revoked if any false information is supplied toward securing the permit / any unauthorized changes are made to the site / any unauthorized changes are made in the installation of the system.

☐ *IMPROVEMENT PERMIT w / plat valid without expiration.* ☐ *IMPROVEMENT PERMIT w / site plan valid for 60 mos.* ☐ *AUTHORIZATION TO CONSTRUCT valid for period equal to IMPROVEMENT PERMIT-not to exceed 60 mo.*

Owner / Applicant Signature: David Hayes Date 5/5/2010 Installed by: Steven Teague RS

Improvement Permit by: Maria H. Tolson REHS Date 5/5/2010 Operation Permit by: Maria H. Tolson Date: 8/12/2010

Authorzation to Construct by: Maria H. Tolson REHS Date 5/5/2010 Existing System Inspected by: Date:

YOU SHOULD CONTACT A LOCATOR SERVICE PRIOR TO ANY EXCAVATION.

WHITE COPY Environmental Health YELLOW COPY (Final) Owner / Applicant PINK COPY (Initial) Owner / Applicant