2100

COUNTY HEALTH DEPARTMENT

STATESVILLE 704-878-5305 MOORESVILLE 704-664-5281

IMPROVEMENT PERMIT / AUTHORIZATION TO CONSTRUCT / OPERATION PERMIT / EXISTING SYSTEM INSPECTION

PERMIT # 1623576 PIN # 4669814133 DATE 7-29-2010

OWNER or APPLICANT D & G Homes LLC PHONE: Business 528-3161 Home 704 400-2307 Cell

OWNER or APPLICANT ADDRESS 631-407 Brawley School Rd #219 Mooresville, NC 28117

LOCATION / DIRECTIONS US 21 N TR Shinnville Rd TR Winthrow Creek Rd TL Atwell Farm Ln on RT.

SUBDIVISION _____ BLOCK / SECTION _____ LOT # _____ LOT AREA Acreage DESIGN FLOW 360gpd L.T.A.R. 3

Septic Tank 1000 Gallons: STB 1012 Date 3-3-09 ☒ New System ☐ Repair ☐ Expansion System Type I II III IV V VI

Pump Tank _____ Gallons: P T _____ Date _____ System Description: Gravity -25% Reduction

Pump Make _____ Model _____ Serial # _____ Repair System Description: Same

Nitrification Field No Fields 1 No Lines 4 Linear Feet 300ft Maintenance Agreement Required ☐ YES ☒ NO

Trench Width 36" Max. Trench Bottom Depth 36" Gravel Depth N/A ☒ GRAVITY ☐ PRESSURE


☒ Residence No. Bedrooms 3 ☐ Business No. Persons _____ ☐ Other No. Employees _____ ☐ Slab ☐ Crawl Space ☐ Basement w/plumbing ☐ Basement w/o plumbing

Water Supply: ☒ Private ☐ Public ☐ Community


Comments / Conditions Keep Septic System maximum feasible distance from well (>50ft) Install lines on Contour

Comments / Conditions Note: Okay to install in 3-100ft lines

INITIAL SITE SKETCH

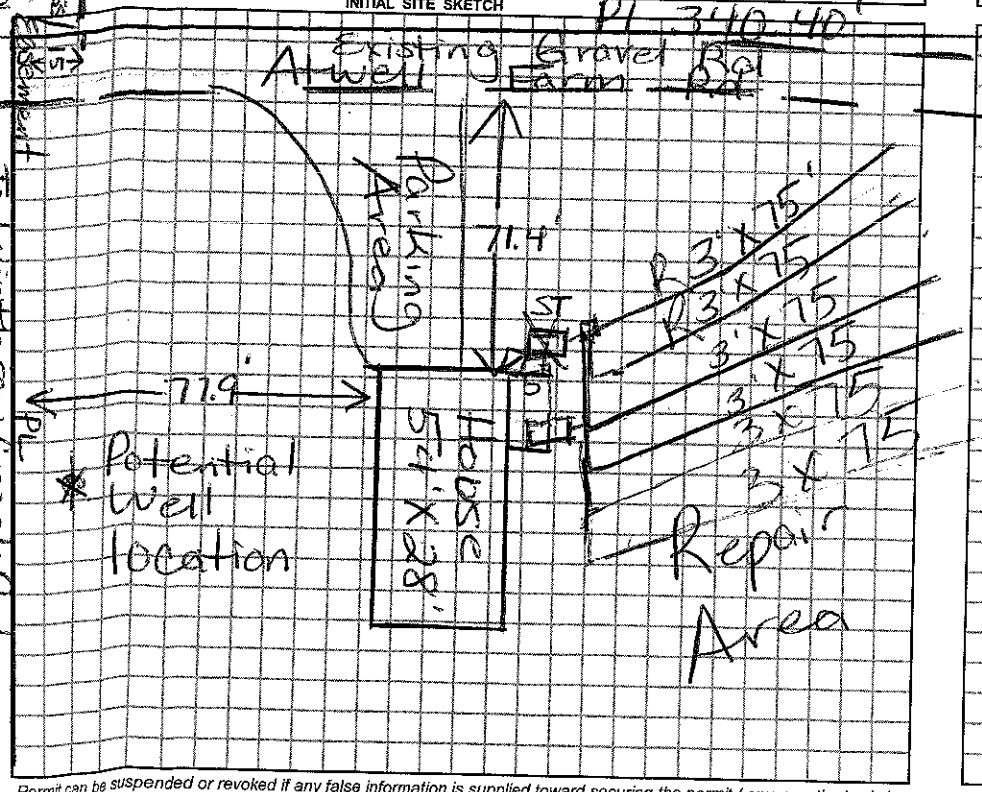

AS BUILT SKETCH

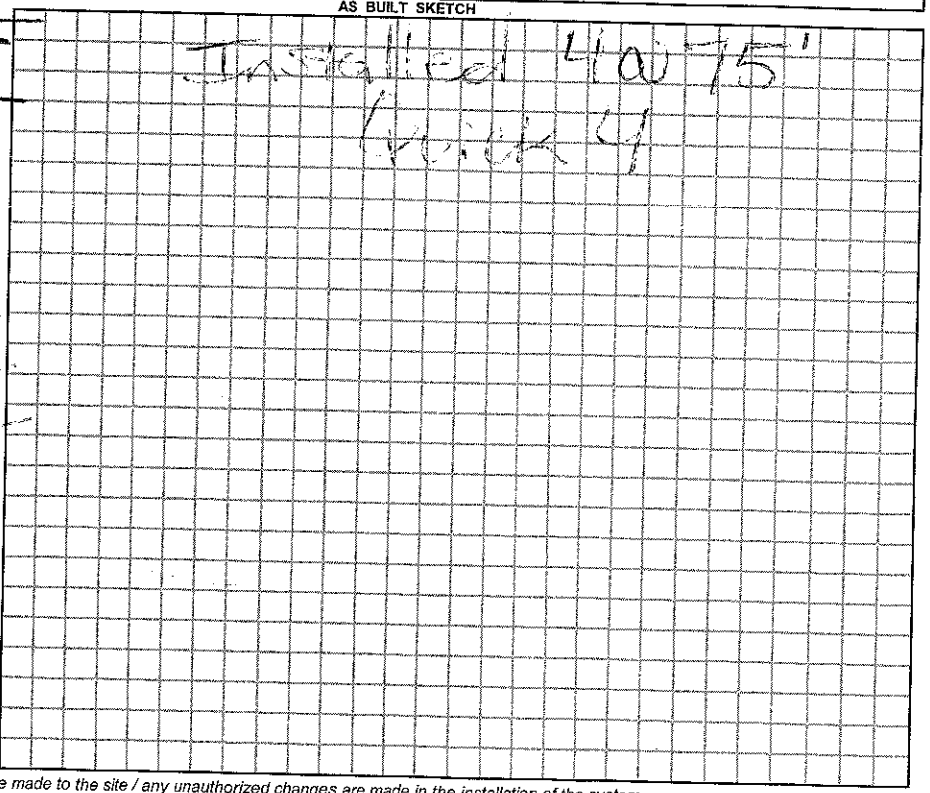

Permit can be suspended or revoked if any false information is supplied toward securing the permit / any unauthorized changes are made to the site / any unauthorized changes are made in the installation of the system.

☐ IMPROVEMENT PERMIT w / plat valid without expiration. ☐ IMPROVEMENT PERMIT w / site plan valid for 60 mos. ☐ AUTHORIZATION TO CONSTRUCT valid for period equal to IMPROVEMENT PERMIT-not to exceed 60 mo.

Owner / Applicant Signature: D & G Homes Date 7/30/10

Improvement Permit by: Marie Thomas Date 7/29/10

Authorization to Construct by: Marie Thomas Date 7/29/10

Installed by: Steve Hedden

Operation Permit by: Marie Thomas Date: 9/3/2010

Existing System Inspected by: _____ Date: _____

SHOULD CONTACT A LOCATOR SERVICE PRIOR TO ANY EXCAVATION.

WHITE COPY Environmental Health YELLOW COPY (Final) Owner / Applicant PINK COPY (Initial) Owner / Applicant