4669 89 5595

# IREDELL COUNTY HEALTH DEPARTMENT

STATESVILLE 704-878-5305 MOORESVILLE 704-664-5281

## IMPROVEMENT PERMIT / CERTIFICATE OF COMPLETION / OPERATION PERMIT / EXISTING SYSTEM INSPECTION

PROPERTY DESCRIPTION NO. 16916 DATE 8/31/93 TAX MAP NO. 4H B 10

OWNER OR CONTRACTOR K SCOTT ATWELL PHONE: Business 664-1929 Home

ADDRESS Rt 8 Box 333 A MOORESVILLE, NC. 28115

LOCATION WINTHROW CK RD, TL OFF TRIPLETT RD, TO 1ST GRAVEL ON (R) TO END OF ROAD

SUBDIVISION N/A BLOCK / SECTION LOT LOT AREA ~78 AC SITE CLASS. P L.T.A. 25 - 3

Water Supply: ☑ Individual ☐ Community ☐ Public ON SITE

Septic Tank: 1000 Gallons; STB Date

Pump Tank: Gallons; PT Date

Nitrification Field: No Fields 1 Square Feet 810 Linear Feet 270

No Lines 2 Trench Width 36" Trench Depth 30" Gravel Depth 12"

☑ New System ☐ Repair System Type: I, ☑ II, IV, V, VI

System Description: CONV - GRAVITY

Repair System Description:

Maintenance Agreement Required: ☐ Yes ☐ No

☐ House/Mod. Home ☑ Mobile Home ☐ Business ☐ Other

No. Bedrooms 2 No. Bathrooms 1 No. Employees

☐ Slab ☑ Crawl Space ☐ Basement w/plumbing ☐ Basement wo/plumbing

Garbage Disposal: ☐ Yes ☑ No


Auto. Dishwasher: ☑ Yes ☐ No

Auto. Washing Machine: ☑ Yes ☐ No

Other

Comments BASEMENT HOUSE PLANNED LATER - ADDITIONAL DRAINFIELD WILL BE REQUIRED. WELL NEAR ROAD TO BARN (LARGE GREEN COVER) TRICKY CONTOUR -

**INITIAL SITE SKETCH**

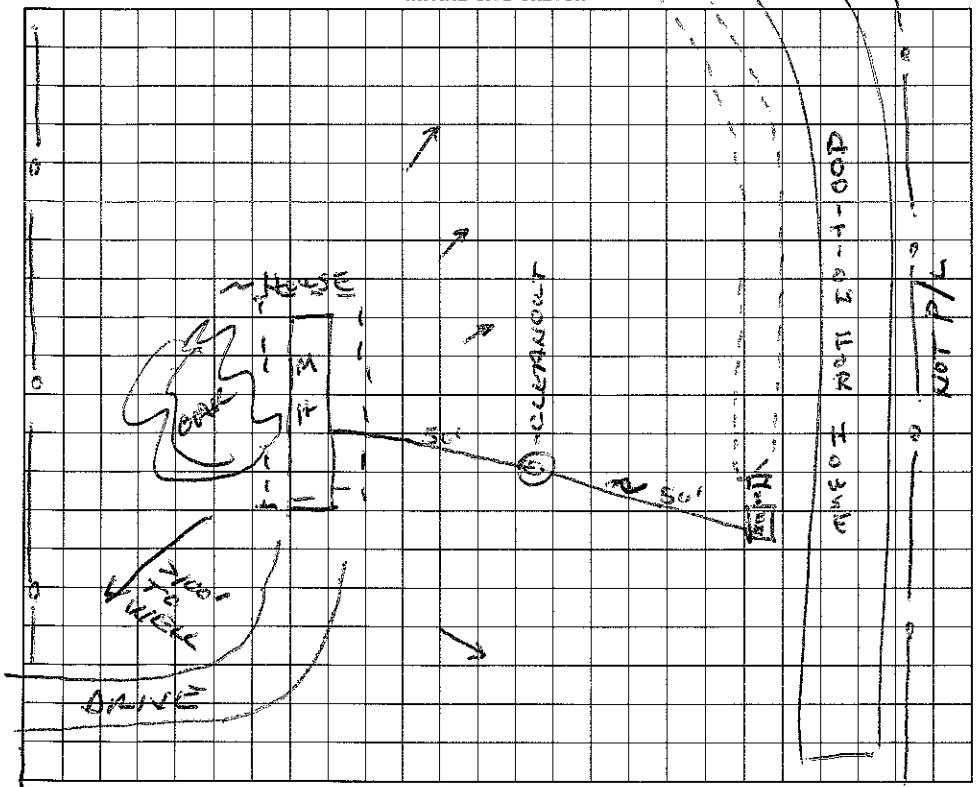


**AS BUILT SKETCH**

I understand that this permit can be suspended or revoked if any false information is supplied toward securing the permit/any unauthorized changes are made to the site/any unauthorized changes are made in the installation of the system. Improvement Permit is valid for 60 months from date of issuance.

Signed: Scott Atwell

Improvement Permit by: Wesley Sparks RS. date 8/31/93

Existing System Inspection by: date

Installed by: Associated Landscape / Scott Atwell

Certificate of Completion by: Wesley Sparks RS. date 9/2/93

Operation Permit by: date

HEALTH DEPT. COPY: WHITE INSPECTION COPY (FINAL): GREEN OWNER COPY (FINAL): YELLOW INSPECTION COPY (INITIAL): PINK OWNER COPY (INITIAL): GOLD