IREDELL COUNTY HEALTH DEPARTMENT

STATESVILLE 704-878-5305 MOORESVILLE 704-664-5281

IMPROVEMENT PERMIT / AUTHORIZATION TO CONSTRUCT / OPERATION PERMIT / EXISTING SYSTEM INSPECTION

PERMIT# 149502 PIN# 4664984110.143 4674-07-3101 DATE 4-16-08

OWNER OR APPLICANT Niblock Development PHONE: Business 704-746-5046 Home

ADDRESS 300 McGill Ave NW Concord NC 28027

LOCATION Anniston Way, TR Burnette, TR Walking Horse, @ end

SUBDIVISION Anniston BLOCK / SECTION 4 LOT 143 LOT AREA 3.17 ac SITE CLASS. PS DESIGN FLOW 600 L.T.A.R. .275

Septic Tank: 1500 Gallons; STB 338 Date 9-1-10

Pump Tank: 1500 Gallons; PT 477 Date 2-10-10

Pump Make: Goulds Model WE0512H Serial No.

Nitrification Field: No Fields 1 Square Feet 1680' Linear Feet 560'

No Lines 4 Trench Width 36" Max Trench Bottom Depth 36" Gravel Depth — ☐ Gravity ☒ Pressure ☐ Slab ☒ Crawl Space ☐ Basement w/plumbing ☐ Basement wo/plumbing

☒ New System ☐ Repair ☐ Expansion System Type: I II III IV V VI

System Description: PM 25% Red.

Repair System Description: LP PPBPS

Maintenance Agreement Required: ☐ Yes ☒ No Initially

☒ House/Mod. Home ☐ Mobile Home ☐ Business ☐ Other

No. Bedrooms 5 No. Persons 10 No. Employees

Water Supply: ☒ Individual ☐ Public ☐ Community

Comments/Conditions: Follow Attached Plan / Use in-line ~~Filter in pump tank~~

Comments/Conditions:

INITIAL SITE SKETCH

See Attached Plan from Rollans Soil + Environmental Services

AS BUILT SKETCH

INSTALLED AS DRAWN
5' ADS CHAMBERS
2 PER DITCH

SET 2' PRESSURE HEAD
CHECKED ALARM


Permit can be suspended or revoked if any false information is supplied toward securing the permit/any unauthorized changes are made to the site/any unauthorized changes are made in the installation of the system. Improvement Permit with plat valid without expiration ☐ Improvement Permit with site plan valid for sixty months ☒ Authorization to Construct is valid for a period equal to that of Improvement Permit – not to exceed sixty months.

Signed: [signature] date 4-22-08 Installed by: LARRY HINKLE

Improvement Permit by: [signature] date 4-16-08 Operation Permit by: [signature] REHS date

Authorization to Construct by: [signature] REHS date 7/22/2010 Existing System Inspection by: [signature] REHS date

HEALTH DEPT. COPY: WHITE OWNER COPY (FINAL): YELLOW OWNER COPY (INITIAL): PINK

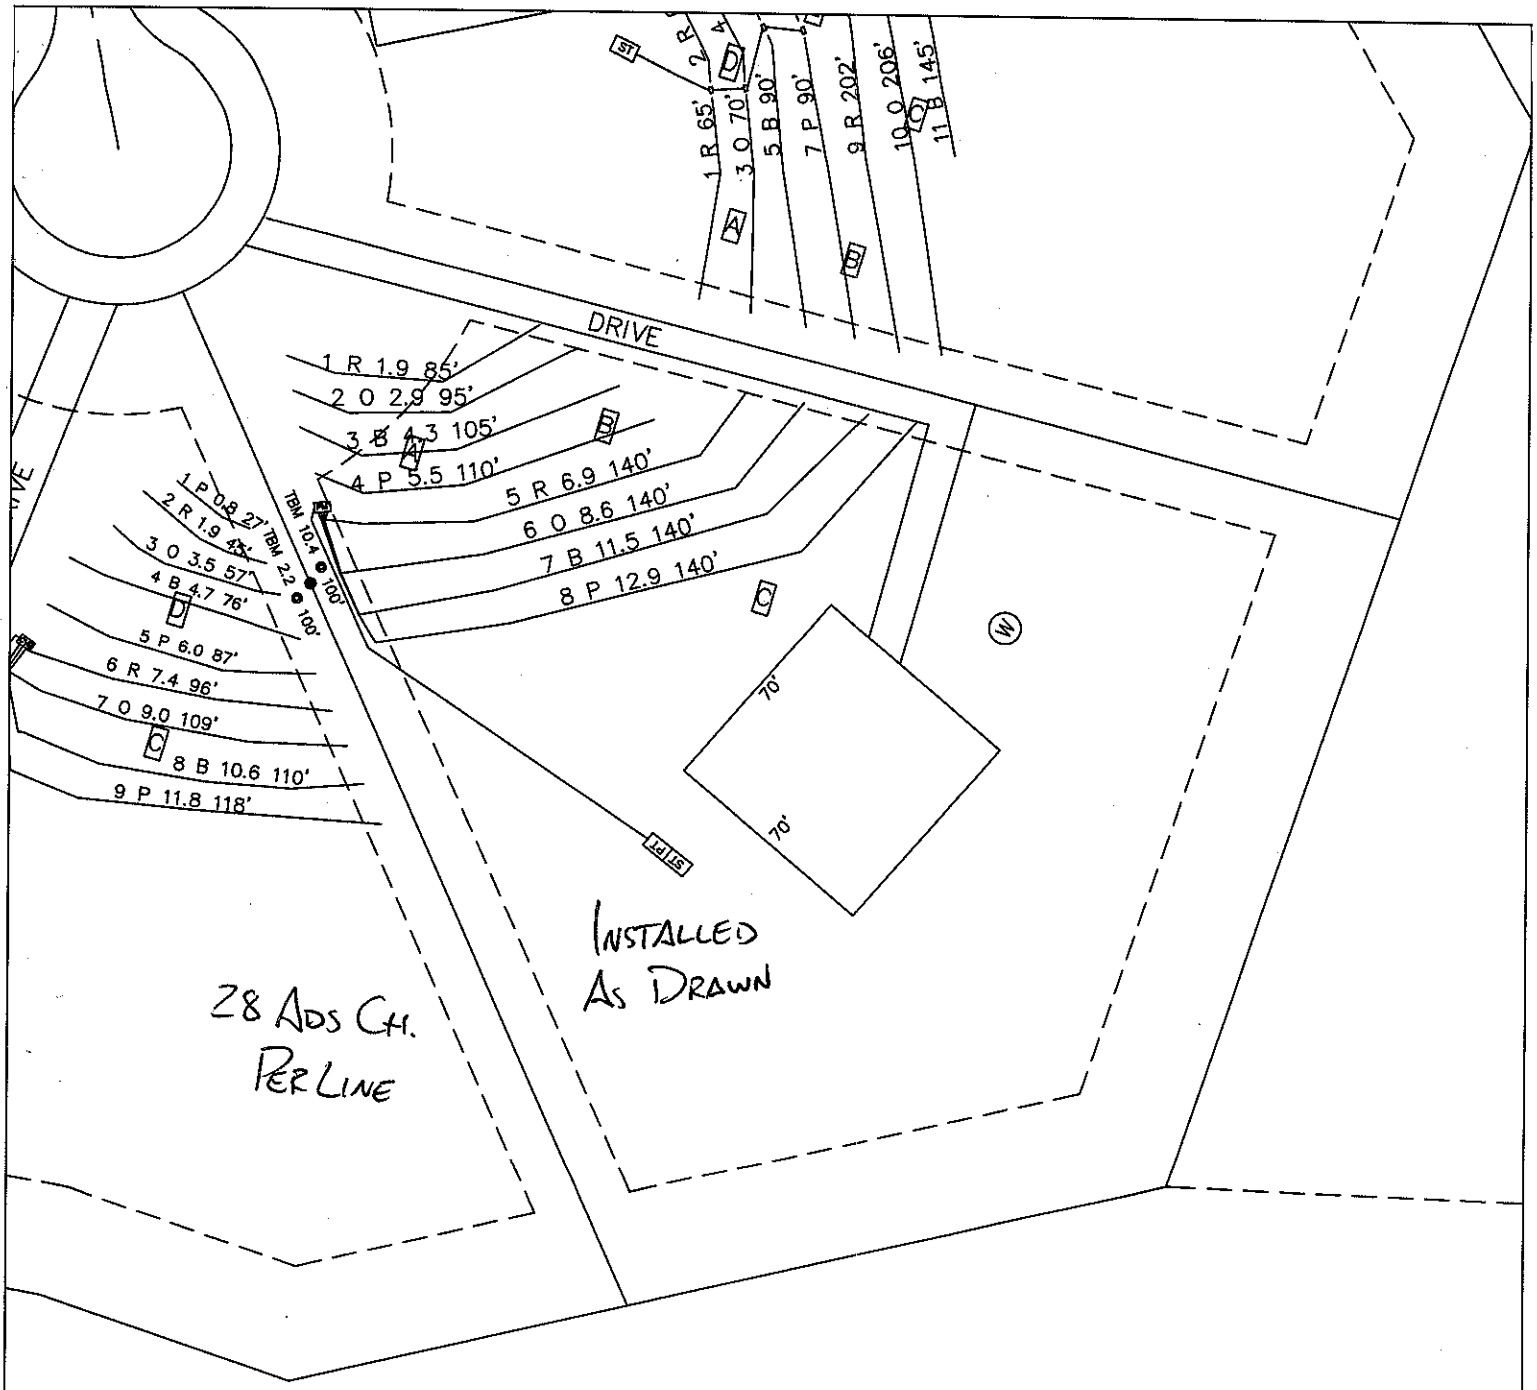

LEGEND

- Areas contain soils with 24 inches or more of useable material and have potential for conventional, modified conventional and low-pressure pipe (lpp) septic systems.
- House Footprint (All 70' x 70')
- System lines.
- Repair lines.
- TBM.
- Well Location.
- RS&ES Pit Location. (A)
- RS&ES Boring Location. (25)
- Health Dept. Pit Location. (28)

GRAPHIC SCALE

o 1" = 60'

60 60 120

FOR PRELIMINARY PLANNING PURPOSES ONLY. ALL LOTS WILL REQUIRE FINAL APPROVAL BY THE COUNTY HEALTH DEPARTMENT ON A LOT BY LOT BASIS. THIS MAP SHOULD BY USED AS A GENERAL GUIDE, SOME ADJUSTMENTS WILL BE NECESSARY IN THE FIELD DUE TO SOIL VARIABILITY AND COMPLEX TOPOGRAPHIC FEATURES. THIS MAP ONLY REFLECTS EXISTING SOIL SUITABILITY FOR ON-SITE SEPTIC TANK SYSTEMS.

PLEASE REFER TO ATTACHED SOIL REPORT FOR ADDITIONAL SITE SPECIFIC INFORMATION

ROLLANS SOIL & ENVIRONMENTAL SERVICES
470 NORTH BROAD ST., SUITE D
MOORESVILLE, NC 28115
PHONE: 704.658.1723 FAX: 704.658.1724
ASHLEY ROLLANS, NC LICENSED SOIL SCIENTIST
MOBILE: (704) 746 - 5046
EMAIL: ROLLANS@WINDSTREAM.NET

MAP TITLE: SITE PLAN & DRAINFIELD AREAS

LOCATION/DATE: SHEARER CHAPEL ROAD, IREDELL COUNTY, NORTH CAROLINA, APRIL 2005

PROJECT NAME: NIBLOCK DEVEOPMENT CORP. / ANNISTON PHASE IV

JOB # : 01-1005
FILE: C:\JOBS\01-1005
PROJECT MGR.: S.A.R.
FIELD WORK: S.A.R.
DRAWN BY: S.A.R.