25

IREDELL COUNTY HEALTH DEPARTMENT

Statesville Office (704) 878-5305 Mooresville Office (704) 660-3625 PERMIT # 206312 (149912)

IMPROVEMENT PERMIT / AUTHORIZATION TO CONSTRUCT / OPERATION PERMIT / EXISTING SYSTEM

PIN # 4674-08-0173.000

APPLICANT: Sheen Homes APPLICANT ADDRESS: 8088 Corporate Center Dr. Charlotte NC

SITE ADDRESS: 271 Walking Horse Trl. Davidson NC PHONE: 704-576-3887 ALT. PHONE:

SITE DIRECTIONS: Sherrers Rd. S. TL Anniston Loop, TR Bywall, TL Walking Horse, Site on L

SUBDIVISION: Anniston SECTION: 4 LOT # 136 LOT AREA: DESIGN FLOW: 600 GPD L.T.A.R.: .275

Septic Tank	1500 (gal)	STB	1546	Date	5/14/16	☒ New System	☐ Repair	☐ Expansion	System Type: I II III IV V VI	☒ Residence	No. Bedrooms 5
Pump Tank	1500 (gal)	PT	1546	Date	4/21/16	System Description: LP - PPBPS				☐ Business	No. Persons 10
Pump Make		Model	152B	Serial #		Repair System Description: Same				☐ Other	No. Employees
# Nitrification Fields	1	# Lines	6	Linear Ft:	365'	Maintenance Agreement Required:	☒ YES	☐ NO		☐ Slab	☐ Crawl Space
Trench Width	24"	Max. Trench Bottom Depth	36"	Gravel Depth	N/A		☐ GRAVITY	☒ PRESSURE		☒ Basement w/plumbing	☐ Basement w/o plumbing

Water Supply: ☒ Private ☐ Public ☐ Community

Comments / Conditions: Rowan Sep NC .1900 Rules

2/29/16 Reviewed Floor plans, in Compliance with Septic plan

INITIAL SITE SKETCH

See Attached/Approved Design By Michael Athans & Associates

DATED APPROVED FEB 09 2016

AS BUILT SKETCH

Rowan Sept Tank Diagram

9-19-16: Alarm OK. Electrical ok (2 breakers) 6.5" differential between on/off floats (functional) + low float Alarm Relay (2" tether) appears functional

* ≈ 70 seconds of siphoning during functional test of system.

9-20-16: Siphon Hole (3/16") drilled.

Permit can be suspended or revoked if any false information is supplied toward securing the permit / any unauthorized changes are made to the site / any unauthorized changes are made in the installation of the system. **CONTACT A LOCATOR SERVICE PRIOR TO ANY EXCAVATION**


☐ **IMPROVEMENT PERMIT** *with plat valid without expiration.* ☒ **IMPROVEMENT PERMIT** *with site plan valid for 60 mos.* ☒ **AUTHORIZATION TO CONSTRUCT** *valid for period equal to IMPROVEMENT PERMIT--not to exceed 60 mo.*

Owner / Applicant Signature: Date: 3-16-16 Installed by: Rowan Septic Tank

IMPROVEMENT PERMIT by: APPROVED FEB 09 2016 Date: OPERATION PERMIT by: Tom Shuck Date: 9-20-16

AUTHORIZATION TO CONSTRUCT by: Date: 2/29/16 Existing System Inspected by: Date:

Health Dept. Copy - WHITE Applicant (Final Approval) - YELLOW Applicant (Conditional Approval) - PINK

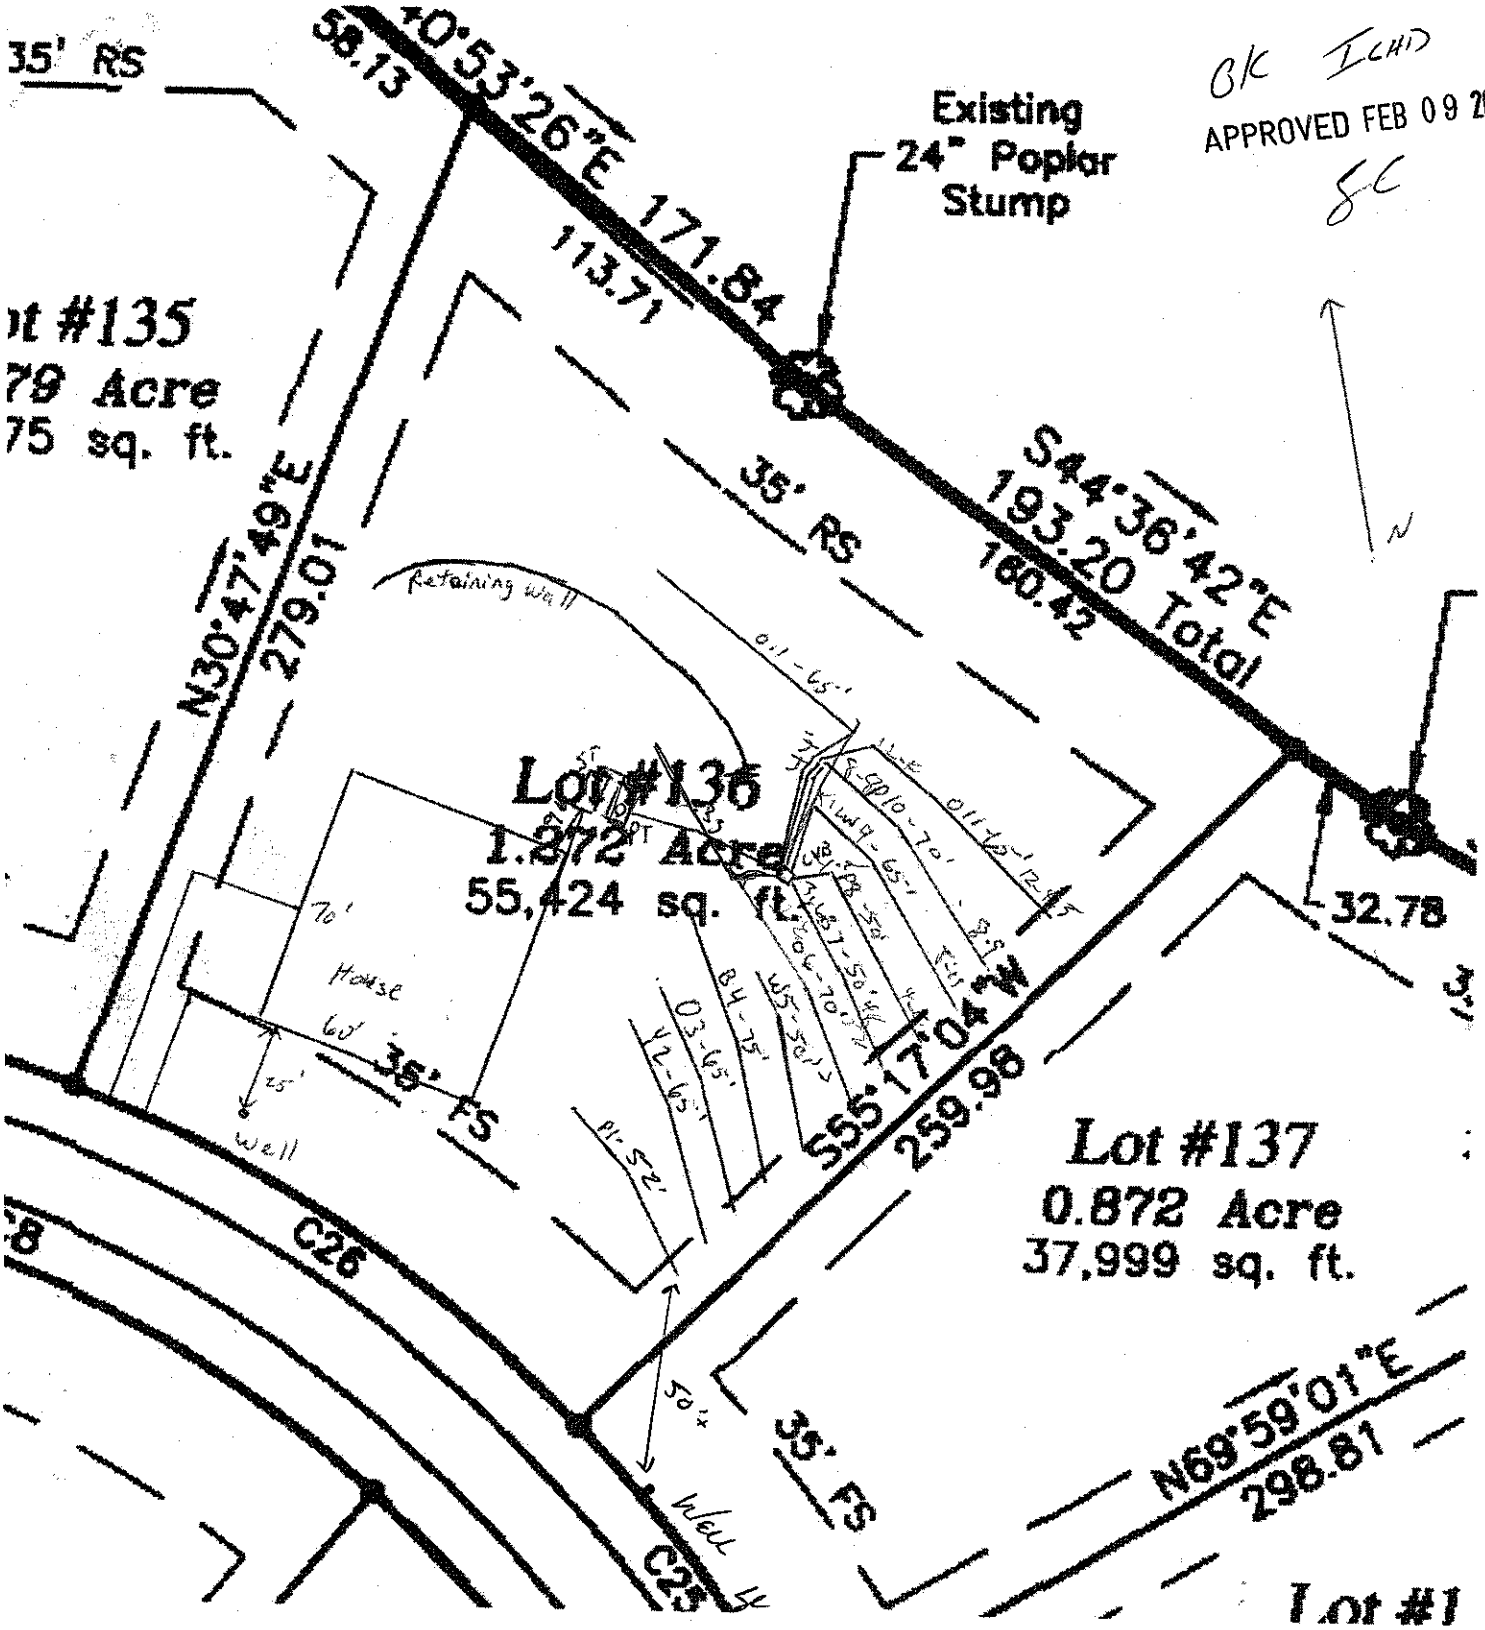

BC ICHD
APPROVED FEB 09 2016
SC