Expansion ones Ø

IREDELL COUNTY HEALTH DEPARTMENT

STATESVILLE 704-878-5305 MOORESVILLE 704-6[illegible]

IMPROVEMENT PERMIT / AUTHORIZATION TO CONSTRUCT / OPERATION PERMIT / EXISTING SYSTEM INSPECTION

PERMIT# 150663 PIN# 4674089539.000 DATE 6/16/08

OWNER OR APPLICANT Daniel Fleming c/o Freedom Homes PHONE: Business 704 806-9898 Home

ADDRESS 154 Fuggitt Dr. Mooresville NC

LOCATION Hwy 3 South TR Johnson Dairy TL Fuggitt Dr. 1st very end

SUBDIVISION N/A BLOCK / SECTION LOT LOT AREA 2.64 SITE CLASS PS DESIGN FLOW 360 L.T.A.R. .35

Septic Tank: 1000 Exis Gallons; STB Date

Pump Tank: Gallons; PT Date

Pump Make: Model Serial No.

Nitrification Field: No Fields 1 Square Feet 264' Linear Feet 88'

No Lines 1 (New) Trench Width 36" Max Trench Bottom Depth 18*

☐ New System ☐ Repair ☑ Expansion System Type: I (II) III IV V VI

System Description: 25% Reduction or Conventional

Repair System Description: Same

Maintenance Agreement Required: ☐ Yes ☑ No

Gravel Depth 12" ☑ Gravity ☐ Pressure

☐ House/Mod. Home ☑ Mobile Home ☐ Business ☐ Other

No. Bedrooms 3 No. Persons No. Employees

Water Supply: ☑ Individual Exis ☐ Public ☐ Community


☐ Slab ☑ Crawl Space ☐ Basement w/plumbing ☐ Basement wo/plumbing

Comments:/Conditions: Install New DB on Line #3 Install either 115' gravel Conventional or 88' 25% Reduction * Maintain 18" max depth.


Comments:/Conditions:

1"=60'

INITIAL SITE SKETCH

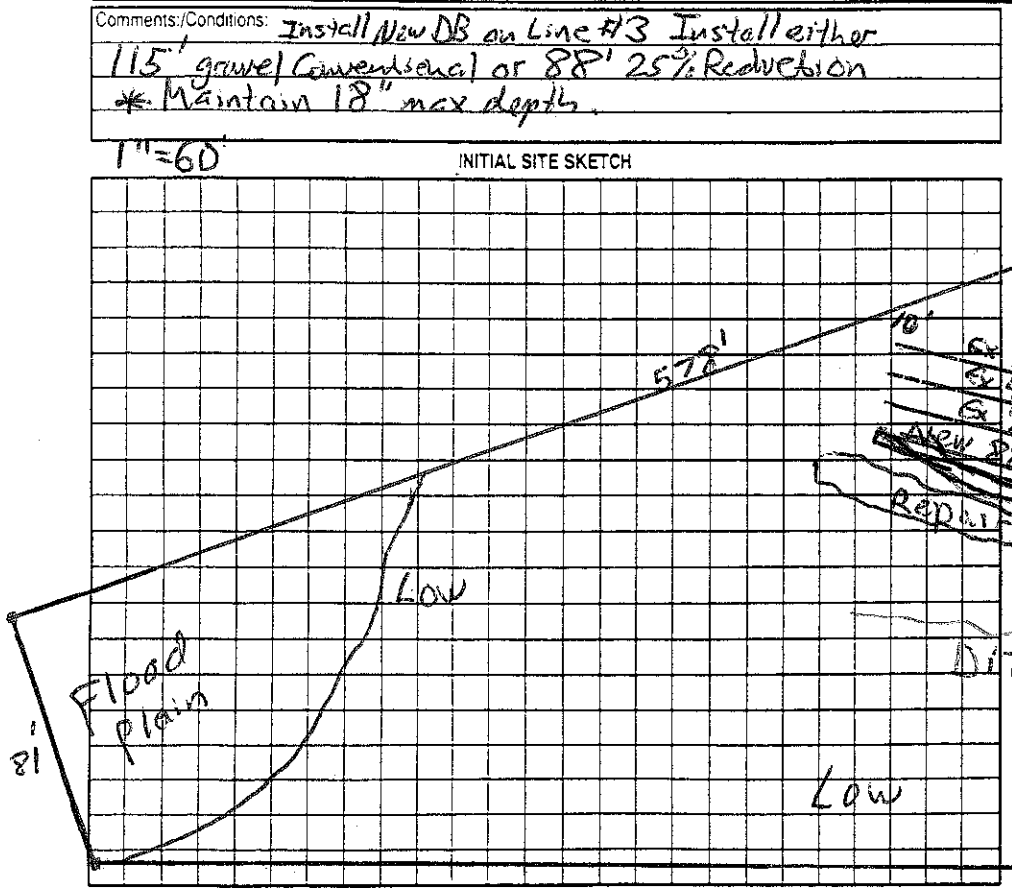

AS BUILT SKETCH

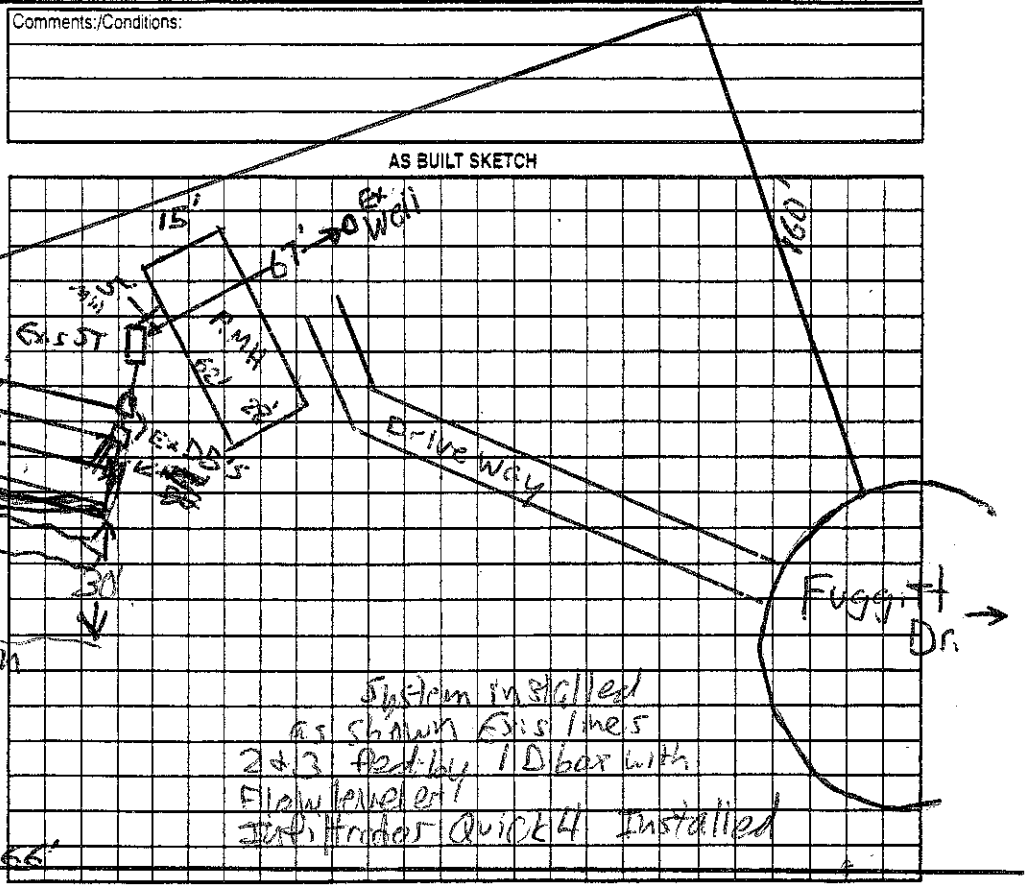

Permit can be suspended or revoked if any false information is supplied toward securing the permit/any unauthorized changes are made to the site/any unauthorized changes are made in the installation of the system. Improvement Permit with plat valid without expiration ☐ Improvement Permit with site plan valid for sixty months ☑ Authorization to Construct is valid for a period equal to that of Improvement Permit – not to exceed sixty months.

Signed: Eric M. Ward date 6-17-08 Installed by: A-1 Backhoe

Improvement Permit by: Anthony Cole Jr date 6/16/08 Operation Permit by: Anthony Cole Jr date 6/25/08

Authorization to Construct by: Anthony Cole Jr date 6/16/08 Existing System Inspection by: date

HEALTH DEPT. COPY: WHITE OWNER COPY (FINAL): YELLOW OWNER COPY (INITIAL): PINK