IREDELL COUNTY HEALTH DEPARTMENT

Authorization to Construct

4674187684

STATESVILLE 704-878-5305 MOORESVILLE 704-664-5281

IMPROVEMENT PERMIT / ~~CERTIFICATE OF COMPLETION~~ / OPERATION PERMIT / EXISTING SYSTEM INSPECTION

PROPERTY DESCRIPTION NO. 2403 DATE 6/11/96 TAX MAP NO. 1B-4-80 Watershed: ☐ Yes ☑ No

OWNER OR CONTRACTOR Dean Reganess PHONE: Business _____ Home 663-0256

ADDRESS 130 Brookstone Ln Mooresville NC 28115

LOCATION Coddle Creek Rd - TR Johnson Dairy Rd - TL Brookstone Ln, on Rt

SUBDIVISION — BLOCK / SECTION — LOT _____ LOT AREA _____ SITE CLASS. PS DESIGN FLOW 360 gpd L.T.A.R. existing

Septic Tank: 1000 existing Gallons; STB _____ Date _____

Pump Tank: _____ Gallons; PT _____ Date _____

Pump Make: _____ Model _____ Serial No. _____

Nitrification Field: No Fields 1 Square Feet 900 Linear Feet 300

No Lines 3 Trench Width 36" Max Trench Bottom Depth — Gravel Depth 12"

☑ New System ☐ Repair System Type: I (II) III. IV. V. VI

System Description: Gravity Conv.

Repair System Description: _____

Maintenance Agreement Required: ☐ Yes ☑ No

☐ House/Mod. Home No. Bedrooms 3

☑ Mobile Home No. Bathrooms 2

☐ Business No. Employees _____

☐ Other _____


☐ Slab ☑ Crawl Space ☐ Basement w/plumbing ☐ Basement wo/plumbing

Water Supply: ☑ Individual ☐ Community ☐ Public


Comments: Existing DW needs to be moved before future trailer is to be hooked to system. (Pool was moved off of system)

Comments:

INITIAL SITE SKETCH

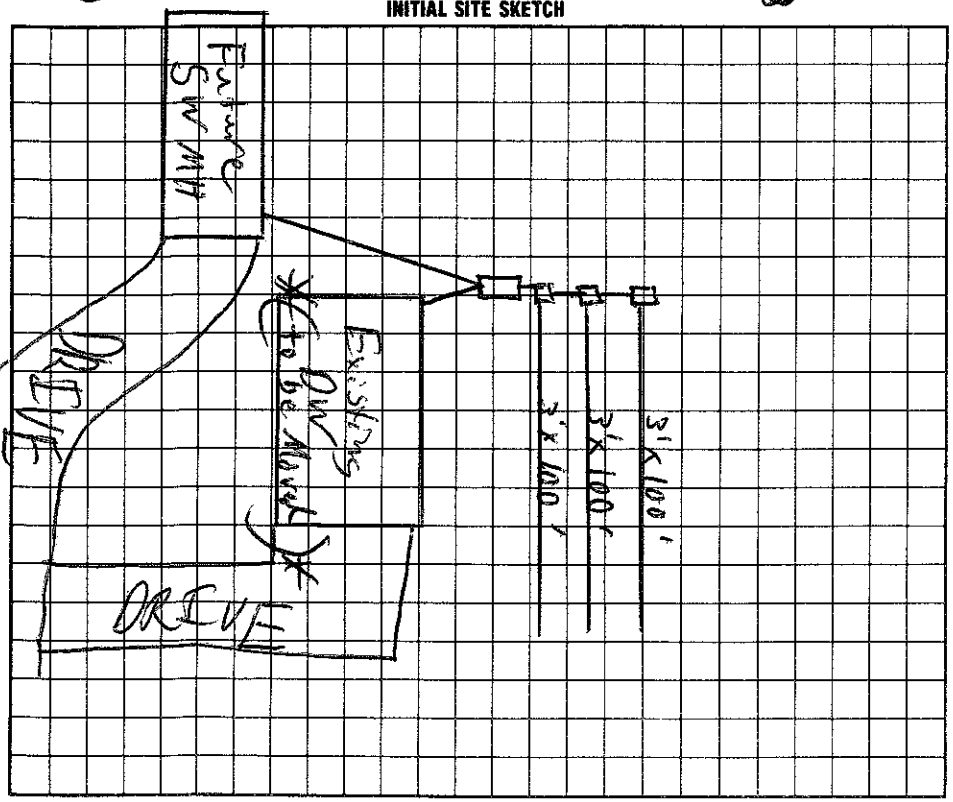

AS BUILT SKETCH

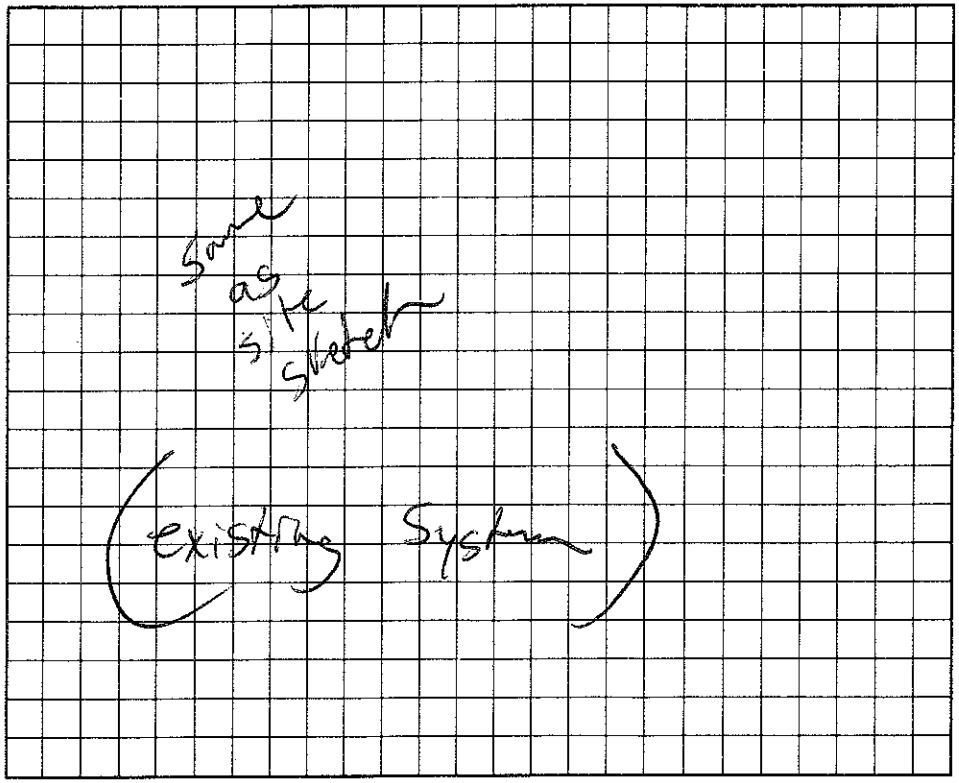

I understand that this permit can be suspended or revoked if any false information is supplied toward securing the permit/any unauthorized changes are made to the site/any unauthorized changes are made in the installation of the system.

Signed: Dean A Reganess

Improvement Permit by: C. Rayburn EHSI date 6/11/96

Existing System Inspection by: C. Rayburn EHSI date 6/11/96

Installed by: _____

Certificate of Completion by: _____ date _____

Operation Permit by: C. Rayburn EHSI date 6/11/96

HEALTH DEPT. COPY: WHITE INSPECTION COPY (FINAL): GREEN OWNER COPY (FINAL): YELLOW INSPECTION COPY (INITIAL): PINK OWNER COPY (INITIAL): GOLD