3:00

IREDELL COUNTY HEALTH DEPARTMENT

STATESVILLE 704-878-5305 MOORESVILLE 704-664-5281

IMPROVEMENT PERMIT / AUTHORIZATION TO CONSTRUCT / OPERATION PERMIT / EXISTING SYSTEM INSPECTION

PERMIT# 94123 PIN# 4674 18 7064 DATE 2/9/01

OWNER OR CONTRACTOR August Reganess PHONE: Business Home 663-0256

ADDRESS 130 Brookstone Ln. Mooresville NC 28115

LOCATION 1365, R Johnson Dairy, L Brookstone

SUBDIVISION BLOCK / SECTION LOT LOT AREA 12.58AC SITE CLASS. PS DESIGN FLOW 360 L.T.A.R. 0.3

Septic Tank: 1000 Gallons; STB 825 Date 2/24/02
Pump Tank: Gallons; PT Date
Pump Make: Model Serial No.
Nitrification Field: No Fields 1 Square Feet 1200 Linear Feet 400
No Lines 4 Trench Width 36" Max Trench Bottom Depth 36" Gravel Depth 12"

☒ New System ☐ Repair System Type: I (II) III, IV, V, VI
System Description: Gravity Conventional
Repair System Description: Pump Conventional
Maintenance Agreement Required: ☐ Yes ☒ No

☒ House/Mod. Home No. Bedrooms 3
☐ Mobile Home No. Bathrooms 2
☐ Business No. Employees
☐ Other
☐ Slab ☐ Crawl Space ☐ Basement w/plumbing ☒ Basement wo/plumbing


Water Supply: ☒ Individual ☐ Public ☐ Community

Comments:/Conditions: Supply Line under Drive Needs to be Sleeved in ductile Iron or equivalent or under a Minimum of 30" of Compacted Cover


Comments:/Conditions: * Water line needs to be 18" over Supply line

Not to Scale

INITIAL SITE SKETCH

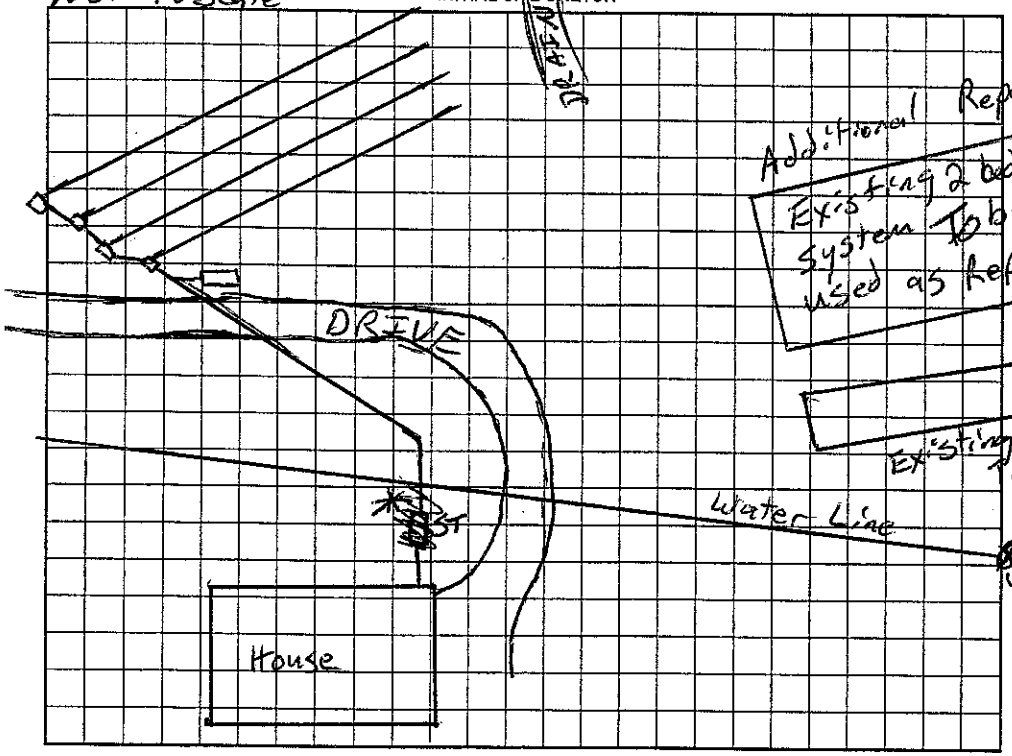

AS BUILT SKETCH

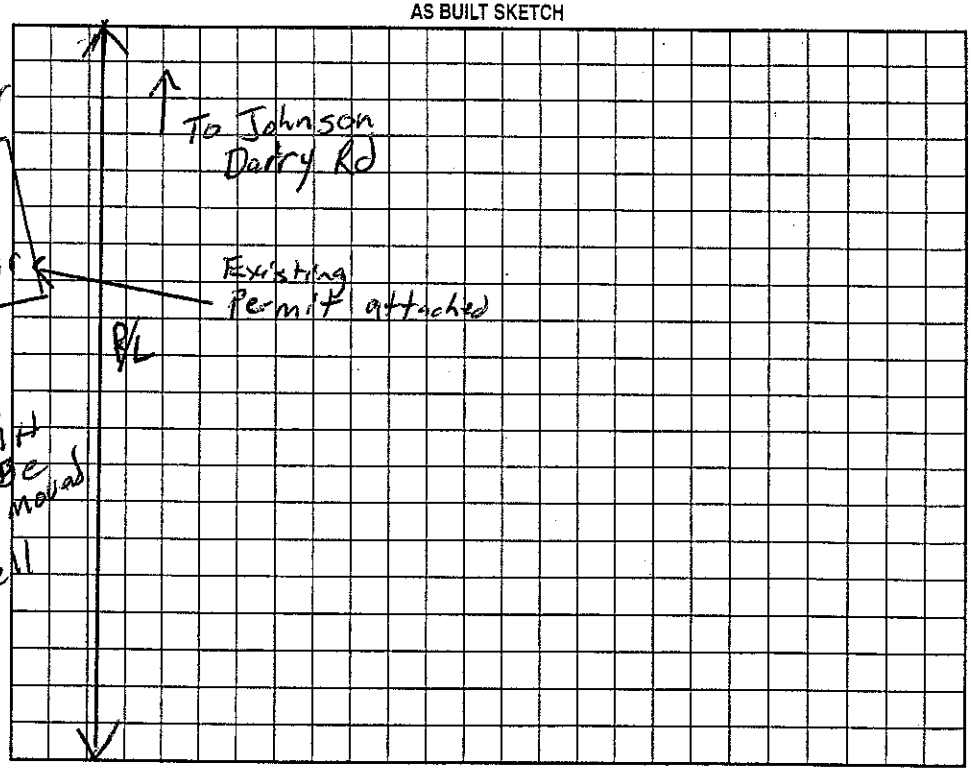

Permit can be suspended or revoked if any false information is supplied toward securing the permit/any unauthorized changes are made to the site/any unauthorized changes are made in the installation of the system. Improvement Permit with plat valid without expiration. Improvement Permit with site plan valid for sixty months. Authorization to Construct is valid for a period equal to that of Improvement Permit – not to exceed sixty months.

Signed: August Reganess date 4/16/01
Improvement Permit by: [signature] RSI date 2/8/01
Authorization to Construct by: [signature] RSI date 2/9/01

Installed by: Rowan Septic
Operation Permit by: [signature] RS date 6/13/02
Existing System Inspection by: date