4674195244

IREDELL COUNTY HEALTH DEPARTMENT

~~Improvement Permit To Construct~~ STATESVILLE 704-878-5305 MOORESVILLE 704-664-5281

IMPROVEMENT PERMIT / ~~CERTIFICATE OF COMPLETION~~ / OPERATION PERMIT / EXISTING SYSTEM INSPECTION

PROPERTY DESCRIPTION NO. 22973 DATE 1/31/96 TAX MAP NO. 1B-A-103 Watershed: ☐ Yes ☑ No

OWNER OR CONTRACTOR Kevin Smith PHONE: Business _____ Home 892-1251

ADDRESS 1784 Shearers Road, Davidson NC 28036

LOCATION Caddle Creek Road Rt on Johnson Dairy, 60 0.25 mile, 250' off road on Lf

SUBDIVISION _____ BLOCK / SECTION _____ LOT _____ LOT AREA 2 acres SITE CLASS. PS DESIGN FLOW 360 L.T.A.R. ~0.25gpd/ft

Septic Tank: 1000 Gallons; STB 794 Date 7/12/96

Pump Tank: _____ Gallons; PT _____ Date _____

Pump Make: _____ Model _____ Serial No. _____

Nitrification Field: No Fields 1 Square Feet 1080 Linear Feet 360'

No Lines 3 Trench Width 3' Max Trench Bottom Depth 36" Gravel Depth N/A

☑ New System ☐ Repair System Type: I. II. III. IV. V. VI

System Description: Chambered Gravelly

Repair System Description: PPBPS Gravelly

Maintenance Agreement Required: ☐ Yes ☑ No

☑ House/Mod. Home No. Bedrooms 3

☐ Mobile Home No. Bathrooms 2

☐ Business No. Employees _____

☐ Other _____


☐ Slab ☐ Crawl Space ☐ Basement w/plumbing ☑ Basement wo/plumbing

Water Supply:
☑ Individual
☐ Community
☐ Public
To Be Drilled

Comments: Run Chambered Lines on Contour. Maintain 100' from new well and neighbors well with System. 60 Chambers Total in 3 Equal Lengths

Comments:

INITIAL SITE SKETCH

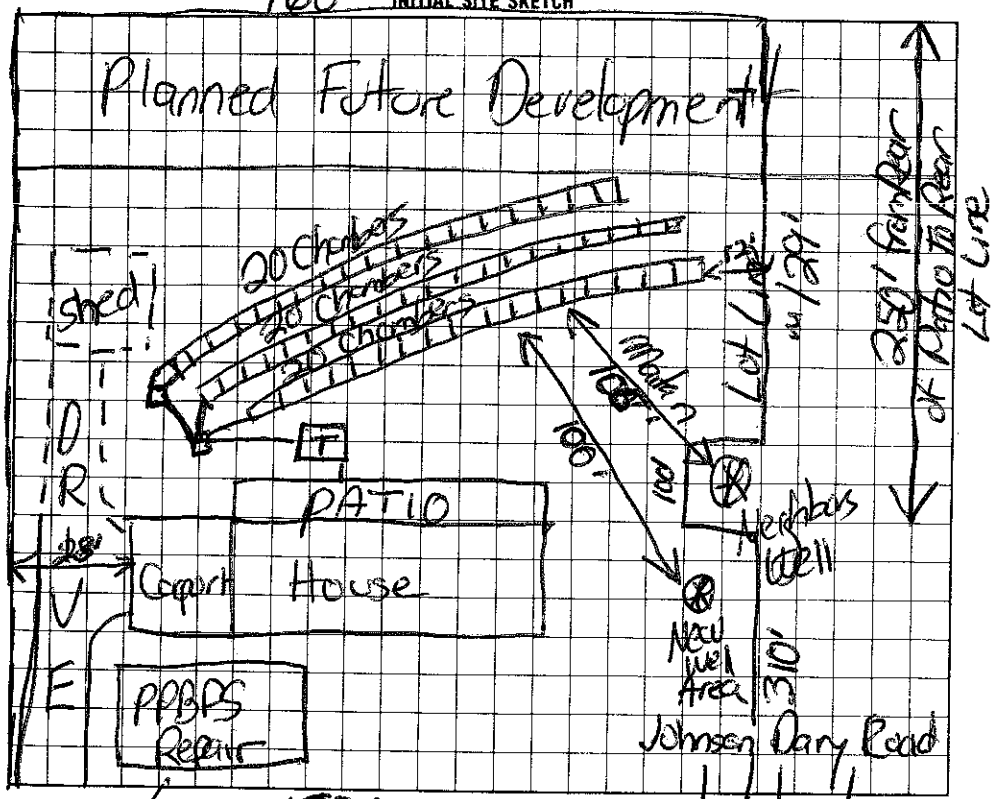

AS BUILT SKETCH

I understand that this permit can be ~~suspended~~ or revoked if any false information is supplied toward securing the permit/any unauthorized changes are made to the site/any unauthorized changes are made in the installation of the system.

Signed: _____

Improvement Permit by: Authorization To Construct Is Valid 5 years from date of Issuance date 1/31/96

Existing System Inspection by: _____ date 1/31/96

Installed by: Larry Beam

Certificate of Completion by: _____ date _____

Operation Permit by: Wesley Sparks RS. date 10/3/96

HEALTH DEPT. COPY: WHITE INSPECTION COPY (FINAL): GREEN OWNER COPY (FINAL): YELLOW INSPECTION COPY (INITIAL): PINK OWNER COPY (INITIAL): GOLD