IREDELL COUNTY HEALTH DEPARTMENT

STATESVILLE 704-878-5305 MOORESVILLE 704-664-5281

IMPROVEMENT PERMIT / AUTHORIZATION TO CONSTRUCT / OPERATION PERMIT / EXISTING SYSTEM INSPECTION

PERMIT# 076905 PIN# 4674197719 DATE 10/19/98

OWNER OR CONTRACTOR William & Harriet White PHONE: Business 663-5061 Home wk 347-5635

ADDRESS 436 Johnson Dairy Rd Mooresville, NC 28115

LOCATION Coddle Creek Rd TR) Johnson Dairy ~ 1/4 mile on Rt. on Hill (Log Home)

SUBDIVISION _____ BLOCK / SECTION _____ LOT _____ LOT AREA 6.44/Acre SITE CLASS. PS DESIGN FLOW 480gpd L.T.A.R. .3-.25

Septic Tank: 1000 Gallons; STB 794 Date 9/24/98
Pump Tank: _____ Gallons; PT _____ Date _____
Pump Make: _____ Model Add'l Serial No. _____
Nitrification Field: No Fields 1 Square Feet 450' Linear Feet Add'l 150'
No Lines Add 2 at 75' Exist 3 at 100' Trench Width 36" Max Trench Bottom Depth 24" Gravel Depth 12"

☒ New System ☐ Repair System Type: I, II, III, IV, V, VI
System Description: Addition Gravity-Conventional
Repair System Description: _____
Maintenance Agreement Required: ☐ Yes ☒ No

☒ House/Mod. Home ☐ Mobile Home ☐ Business ☐ Other
No. Bedrooms 4 No. Bathrooms 4 No. Employees _____
☐ Slab ☒ Crawl Space ☐ Basement w/plumbing ☐ Basement wo/plumbing


Water Supply: ☒ Individual ☐ Public ☐ Community

Comments:/Conditions: Note to Installer! Abandon Old Septic Tank & Drainfield per Building Code in area of proposed Addition & up to 5' away from Building Addition. Okay to use the remaining Drainfield Standing at 5' Setback.


Comments:/Conditions: Add'l 2 New Drainlines 3'x75' with Flow Divider (Original System Installed 12/86 for Bd's.

Not to Scale

INITIAL SITE SKETCH

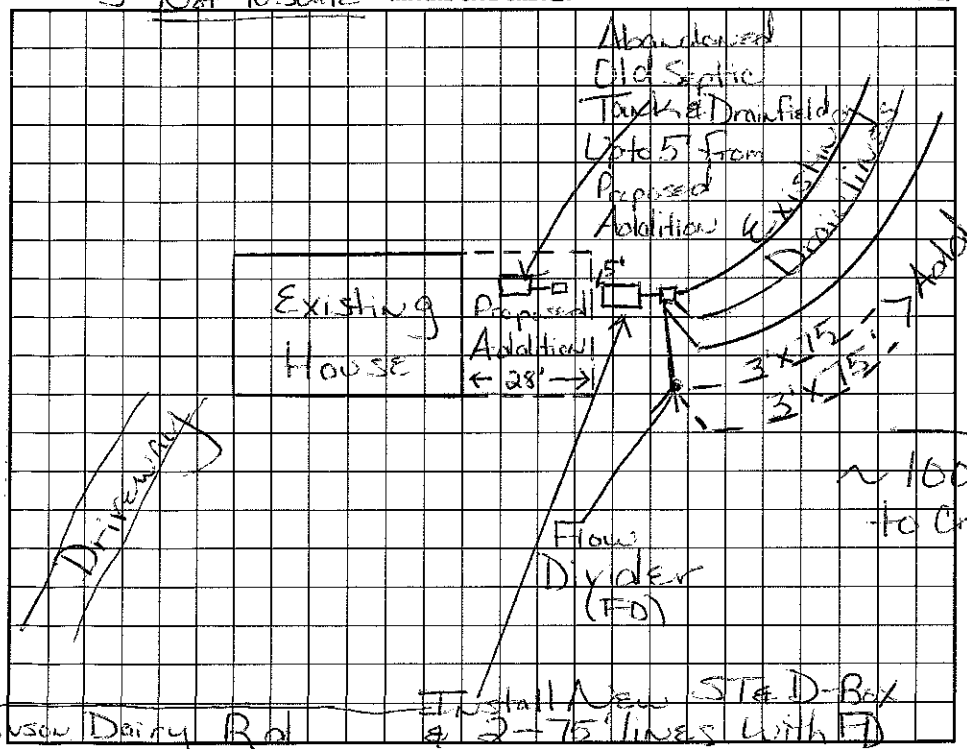

AS BUILT SKETCH

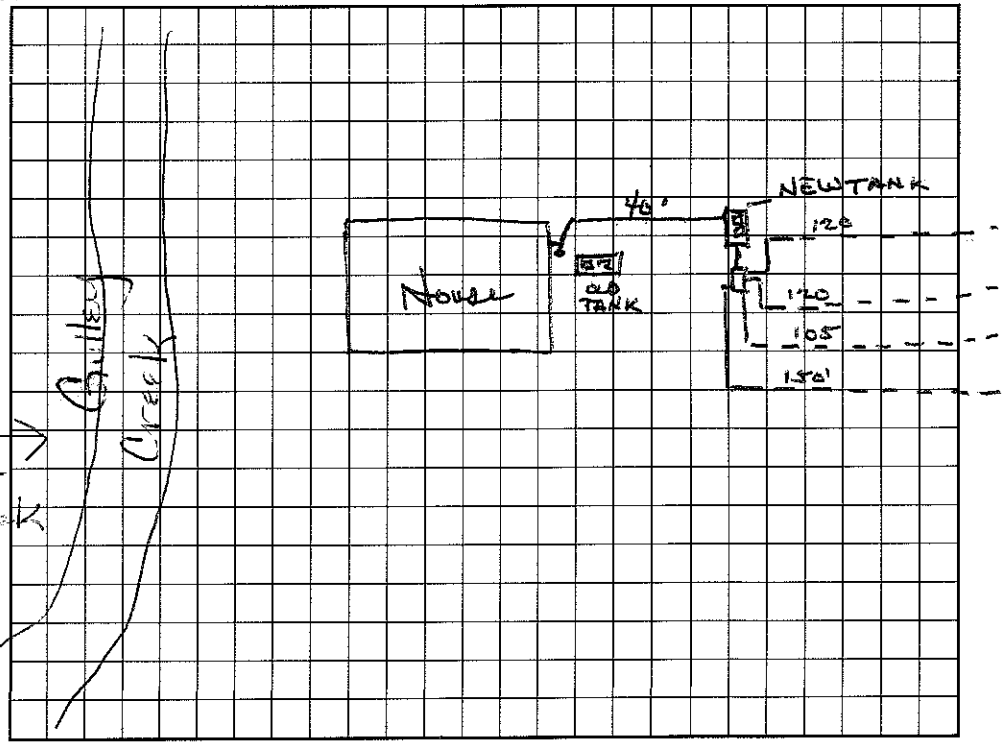

I understand that this permit can be suspended or revoked if any false information is supplied toward securing the permit/any unauthorized changes are made to the site/any unauthorized changes are made in the installation of the system. Improvement Permit with plat valid without expiration. Improvement Permit with site plan valid for sixty months. Authorization to Construct is valid for a period equal to that of Improvement Permit – not to exceed sixty months.

Signed: Harriet K. White date 10/20/98
Improvement Permit by: Marian H. Watson date 10/19/98
Authorization to Construct by: Marian H. Watson date 10/19/98

Installed by: Julian Bowles
Operation Permit by: Wesley Sparrows. date 10/28/98
Existing System Inspection by: _____ date _____

HEALTH DEPT. COPY: WHITE INSPECTION COPY (FINAL): GREEN OWNER COPY (FINAL): YELLOW INSPECTION COPY (INITIAL): PINK OWNER COPY (INITIAL): GOLD