IREDELL COUNTY HEALTH DEPARTMENT

STATESVILLE 704-878-5305 MOORESVILLE 704-664-5281

IMPROVEMENT PERMIT / AUTHORIZATION TO CONSTRUCT / OPERATION PERMIT / EXISTING SYSTEM INSPECTION

PERMIT # 133921 PIN # ~~4674-26-5079~~ 4674256 DATE 12-5-08

OWNER or APPLICANT MIKE YOUNG PHONE: Business 704-363-~~5571~~ Home:

OWNER or APPLICANT ADDRESS 106 LEDGEWOOD LN MOORESVILLE NC 28115

LOCATION / DIRECTIONS HWY 3, TR FOURTRAX, ON L

SUBDIVISION BLOCK / SECTION LOT # LOT AREA DESIGN FLOW 480 L.T.A.R. .3

Septic Tank 1000 Gallons: STB 794 Date 9-10-09

Pump Tank Gallons: PT Date

Pump Make Model Serial #

Nitrification Field No Fields 1 No Lines 4 Linear Feet 400'

Trench Width 36" Max. Trench Bottom Depth 36" Gravel Depth ←

☒ New System ☐ Repair ☐ Expansion System Type I II III IV V VI

System Description: GRAVITY 25%

Repair System Description: GRAVITY 25%

Maintenance Agreement Required ☐ YES ☒ NO

☒ GRAVITY ☐ PRESSURE

☒ Residence No. Bedrooms 4

☐ Business No. Persons

☐ Other No. Employees

☐ Slab ☐ Crawl Space


☒ Basement w/plumbing ☐ Basement w/o plumbing

Water Supply: ☒ Private ☐ Public ☐ Community


Comments / Conditions: 1) SEPTIC TANK MUST BE 10' OFF HOUSE
2) INSTALL 4 LINES @ 100'
1" = 50'

Comments / Conditions 2/19/2010 Checked ST MO
- 3 drop boxes installed level. Chamber system installed on contour.

INITIAL SITE SKETCH

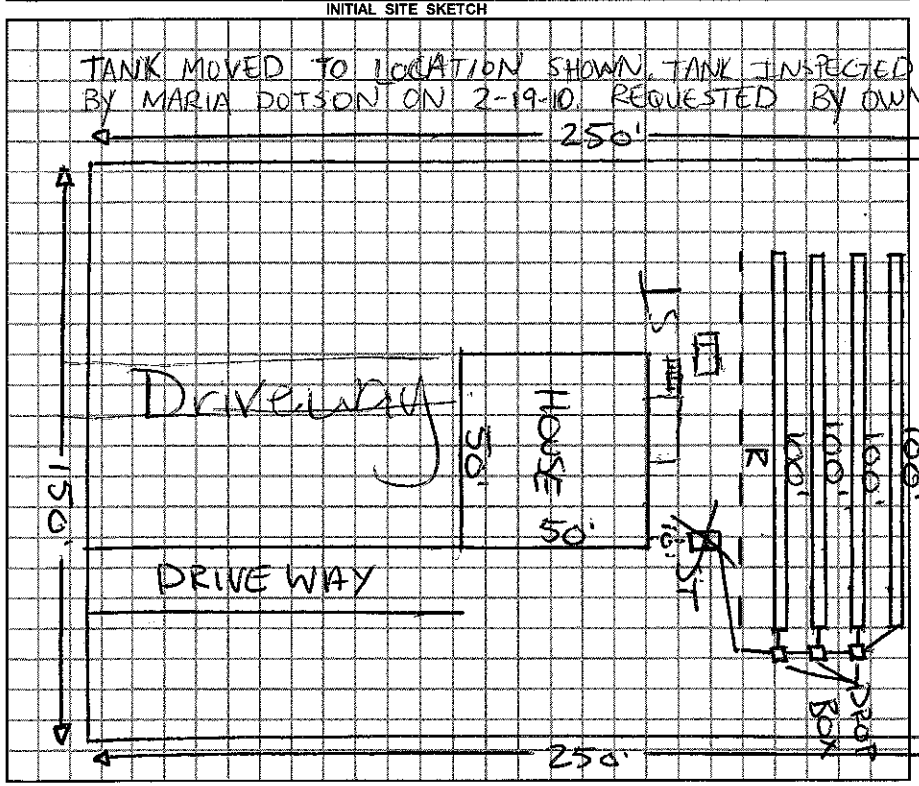

AS BUILT SKETCH

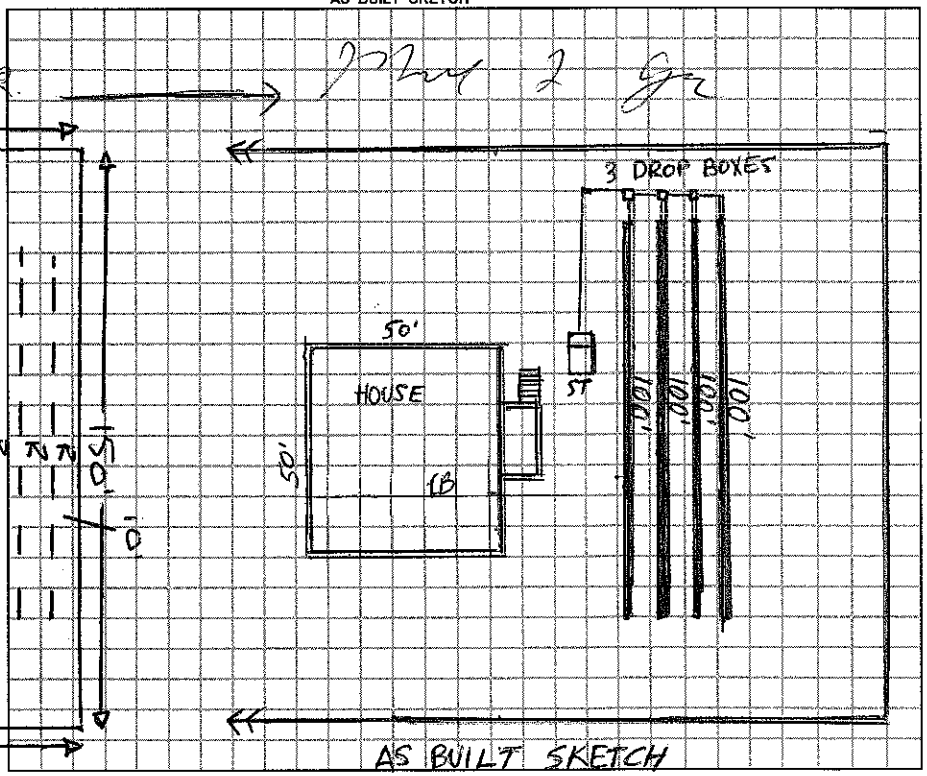

Permit can be suspended or revoked if any false information is supplied toward securing the permit / any unauthorized changes are made to the site / any unauthorized changes are made in the installation of the system.

☐ *IMPROVEMENT PERMIT w / plan valid without expiration.* ☒ *IMPROVEMENT PERMIT w / site plan valid for 60 mos.* ☒ *AUTHORIZATION TO CONSTRUCT valid for period equal to IMPROVEMENT PERMIT-not to exceed 60 mo.*

Owner / Applicant Signature: Date 4-24-09

Improvement Permit by: Date 12-5-08

Authorization to Construct by: Date 5-1-09

Installed by: E J Ervin

Operation Permit by: Tyler Ballew, REHS Date: 2-19-10

Existing System Inspected by: Date:

YOU SHOULD CONTACT A LOCATOR SERVICE PRIOR TO ANY EXCAVATION.

WHITE COPY Environmental Health YELLOW COPY (Final) Owner / Applicant PINK COPY (Initial) Owner / Applicant