4971205443

IREDELL COUNTY HEALTH DEPARTMENT

AUTHORIZATION TO CONSTRUCT

11/30

STATESVILLE 704-878-5305 MOORESVILLE 704-664-5281

IMPROVEMENT PERMIT / CERTIFICATE OF COMPLETION / OPERATION PERMIT / EXISTING SYSTEM INSPECTION

PROPERTY DESCRIPTION NO. 069235 DATE 10/8/97 TAX MAP NO. 674 25543

OWNER OR CONTRACTOR NEIL JACKSON PHONE: Business Home 663-0153 Watershed: ☐ Yes ☐ No

ADDRESS 498 JOHNSON DAIRY RD - MOORESVILLE NC 28115

LOCATION 1365 - TR JOHNSON DAIRY RD - 2ND DRIVE ON LT

SUBDIVISION — BLOCK / SECTION — LOT — LOT AREA 3.13AC SITE CLASS. PS DESIGN FLOW 360 L.T.A.R. .3

Septic Tank: 1000 EXISTING Gallons; STB Date

Pump Tank: Gallons; PT Date

Pump Make: Model Serial No.

Nitrification Field: No Fields 1 Square Feet 360 Linear Feet 120

No Lines 1 @ 120' Trench Width 36" Max Trench Bottom Depth 36" Gravel Depth 12"

☑ New System ☐ Repair System Type: I, II, III, IV, V, VI

System Description: GRAVITY CONVENTIONAL

Repair System Description: SAME

Maintenance Agreement Required: ☐ Yes ☑ No

☑ House/Mod. Home No. Bedrooms 3

☐ Mobile Home No. Bathrooms 3

☐ Business No. Employees

☐ Other


☐ Slab ☐ Crawl Space ☑ Basement w/plumbing ☐ Basement wo/plumbing

Water Supply: ☑ Individual ☐ Community ☐ Public


Comments: EXISTING MH TO BE REMOVED

Comments:

INITIAL SITE SKETCH NOT TO SCALE

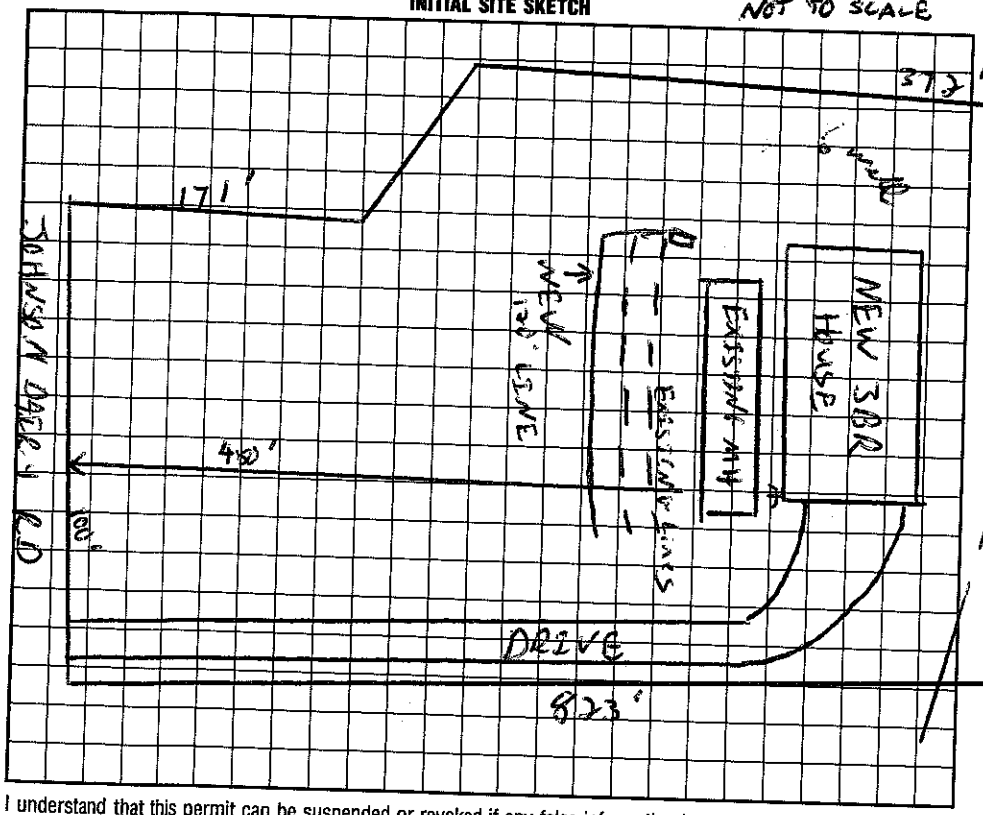

AS BUILT SKETCH

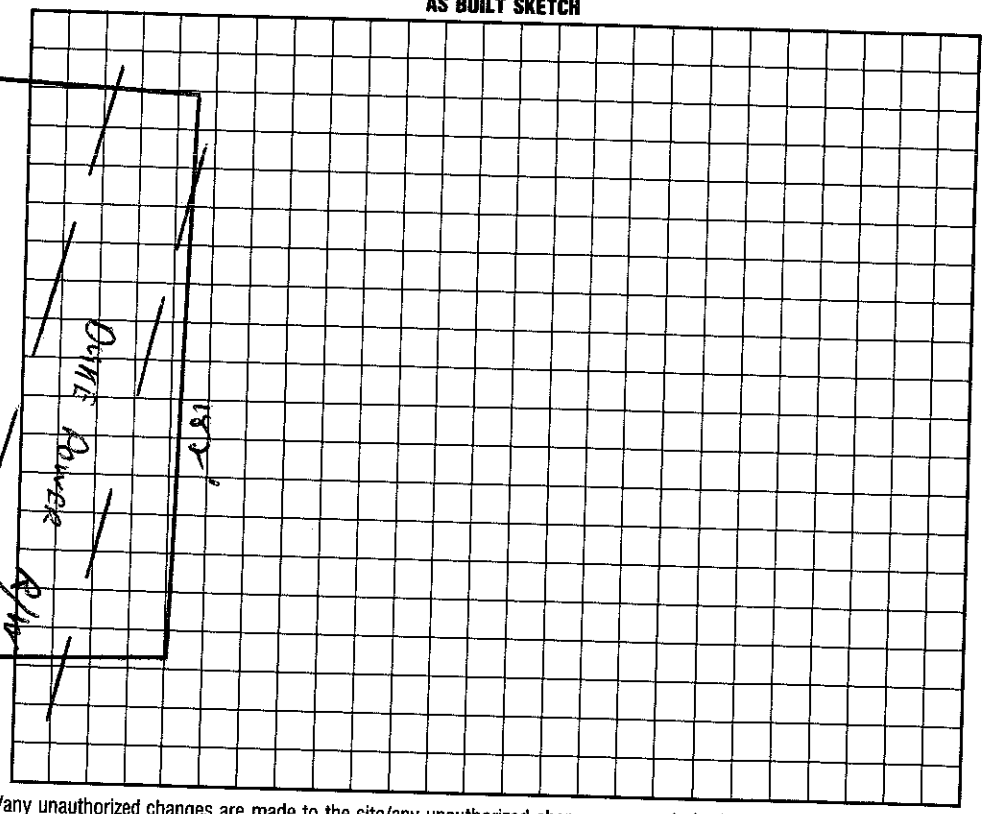

I understand that this permit can be suspended or revoked if any false information is supplied toward securing the permit/any unauthorized changes are made to the site/any unauthorized changes are made in the installation of the system. Improvement Permit is valid for 60 months from date of issuance.

Signed: Mitchell J. Abraham - Agent

Improvement Permit by: date 10/8/97

AUTHORIZATION Existing System Inspection by: date 10/8/97

CONSTRUCT

Installed by:

Certificate of Completion by: date

Operation Permit by: date 5/4/98

HEALTH DEPT. COPY: WHITE INSPECTION COPY (FINAL): GREEN OWNER COPY (FINAL): YELLOW INSPECTION COPY (INITIAL): PINK OWNER COPY (INITIAL): GOLD