(10.00)

IREDELL COUNTY HEALTH DEPARTMENT

STATESVILLE 704-878-5305 MOORESVILLE 704-664-5281

IMPROVEMENT PERMIT / AUTHORIZATION TO CONSTRUCT / OPERATION PERMIT / EXISTING SYSTEM INSPECTION

PERMIT# 080274 PIN# 4674 36 7709 4674-36-7815 DATE 4/15/99

OWNER OR CONTRACTOR Ross McKay PHONE: Business Young - 363-5571 Home

ADDRESS 5501 Prosperity Church Rd. Charlotte, NC

LOCATION 1365 on L just before Patterson Farm Rd.

SUBDIVISION Rocky River Est BLOCK / SECTION LOT 7 LOT AREA ~1AC SITE CLASS. PS DESIGN FLOW 360 L.T.A.R. .3

Septic Tank: 1000 Gallons; STB 794 Date 4/22/99
Pump Tank: Gallons; PT Date
Pump Make: Model Serial No.
Nitrification Field: No Fields 1 Square Feet 1200 Linear Feet 400
No Lines 3 Trench Width 36" Max Trench Bottom Depth 36" Gravel Depth 12"

☒ New System ☐ Repair System Type: I (II) III IV V VI
System Description: GRAVITY CONVENTIONAL
Repair System Description: GRAVITY - TYPE 3
Maintenance Agreement Required: ☐ Yes ☒ No


☒ House/Mod. Home No. Bedrooms 3
☐ Mobile Home No. Bathrooms 3
☐ Business No. Employees
☐ Other
☐ Slab ☒ Crawl Space ☐ Basement w/plumbing ☐ Basement wo/plumbing

Water Supply: ☒ Individual ☐ Public ☐ Community


Comments:/Conditions: (4@100 INSTALLED AS SHOWN)

Comments:/Conditions:

INITIAL SITE SKETCH (1" = 50')

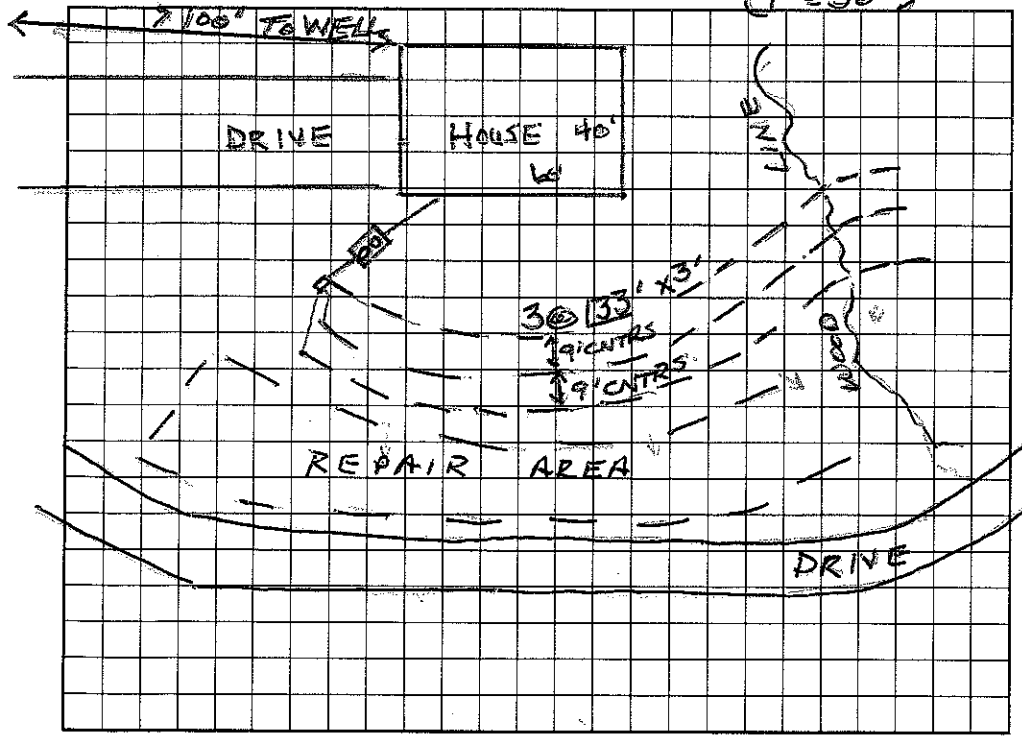

AS BUILT SKETCH

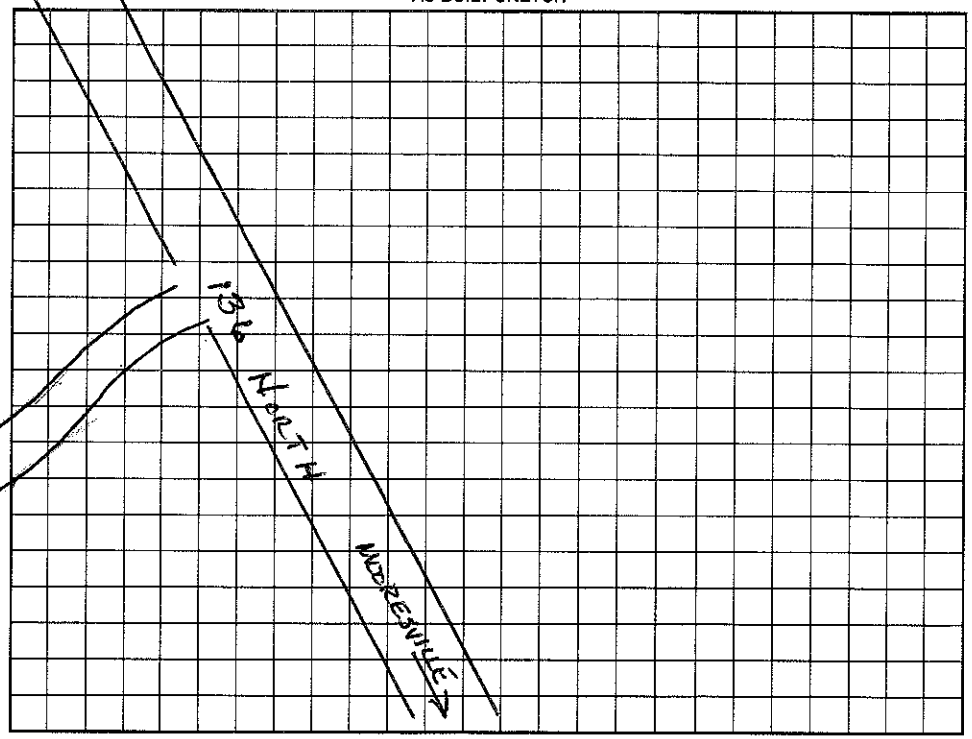

Permit can be suspended or revoked if any false information is supplied toward securing the permit/any unauthorized changes are made to the site/any unauthorized changes are made in the installation of the system. Improvement Permit with plat valid without expiration. Improvement Permit with site plan valid for sixty months. Authorization to Construct is valid for a period equal to that of Improvement Permit – not to exceed sixty months.

Signed: ✱ Richard J. Jay date 12-14-99 Installed by: FS ERWIN

Improvement Permit by: Wesley Sparks RS. date 4/15/99 Operation Permit by: C. [illegible] RS date 6/1/00

Authorization to Construct by: Wesley Sparks RS. date 4/15/99 Existing System Inspection by: date

HEALTH DEPT. COPY: WHITE OWNER COPY (FINAL): YELLOW OWNER COPY (INITIAL): PINK