IREDELL COUNTY HEALTH DEPARTMENT

D. Thorgeton + Construct

STATESVILLE 704-878-5305 MOORESVILLE 704-664-5281

96 T 5 11 055

IMPROVEMENT PERMIT / ~~CERTIFICATE OF COMPLETION~~ / OPERATION PERMIT / EXISTING SYSTEM INSPECTION

Watershed: ☐ Yes ☒ No

PROPERTY DESCRIPTION NO. 23753 DATE 5/7/96 TAX MAP NO. 1B A 19

OWNER OR CONTRACTOR Michael Young PHONE: Business Home 664-2774

ADDRESS 104 Ledgewood Lane Mooresville, NC. 28115

LOCATION 1345 on (R) before Patterson Farm Rd. to sharp curve in Lawn on (R)

SUBDIVISION No BLOCK / SECTION LOT LOT AREA SITE CLASS. DESIGN FLOW L.T.A.R.

Septic Tank: 1000 Gallons; STB 821 Date 3/22/96

Pump Tank: Gallons; PT Date

Pump Make: Model Serial No.

Nitrification Field: No Fields 1 Square Feet 1200 Linear Feet 400

No Lines 4 Trench Width 36.4 Max Trench Bottom Depth 36.11

☒ New System ☐ Repair System Type: I, II, III, IV, V, VI

System Description: Conventional - Dist Box

Repair System Description: None

Maintenance Agreement Required: ☐ Yes ☒ No

☐ House/Mod. Home ☒ Mobile Home ☐ Business ☐ Other

No. Bedrooms 3 No. Bathrooms 2 No. Employees

Water Supply: ☒ Individual ☐ Community ☐ Public


☐ Slab ☐ Crawl Space ☐ Basement w/plumbing ☐ Basement wo/plumbing

Gravel Depth 12"


Comments:

Comments:

INITIAL SITE SKETCH

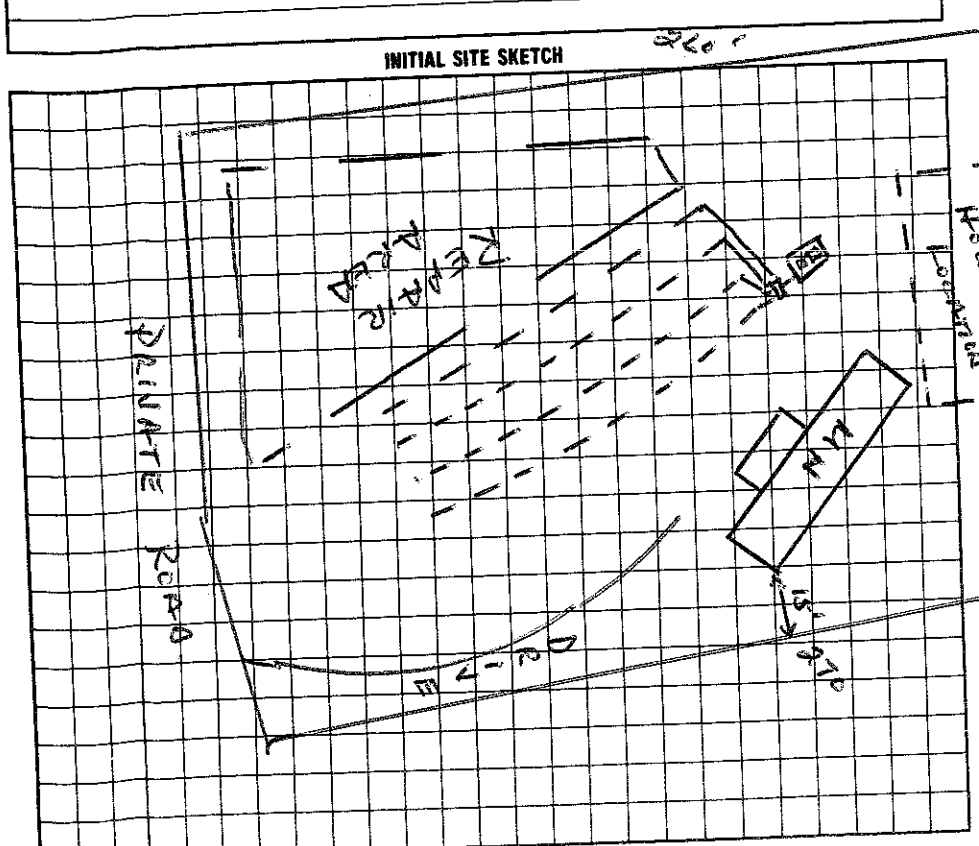

AS BUILT SKETCH

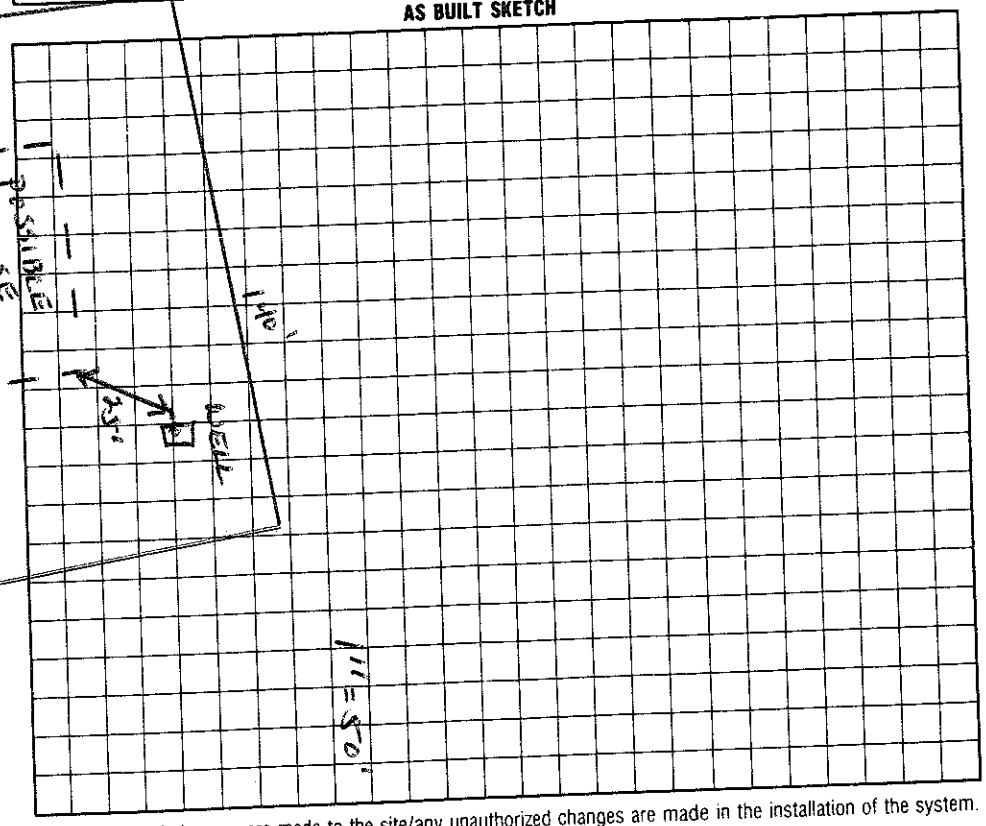

I understand that this permit can be suspended or revoked if any false information is supplied toward securing the permit/any unauthorized changes are made to the site/any unauthorized changes are made in the installation of the system.

Authorization to Construct valid 5 years.

Signed: ✕

Installed by: B + M Enterprises

Improvement Permit by: Wesley Sparks RS. date 5/7/96

System Inspection by: ~~Authorization to Construct~~ Wesley Sparks RS date 5/7/96

Certificate of Completion by: date

Operation Permit by: Wesley Sparks RS. date 6/19/96

HEALTH DEPT. COPY: WHITE INSPECTION COPY (FINAL): GREEN OWNER COPY (FINAL): YELLOW INSPECTION COPY (INITIAL): PINK OWNER COPY (INITIAL): GOLD