IREDELL COUNTY HEALTH DEPARTMENT

STATESVILLE 704-878-5305 MOORESVILLE 704-664-5281

IMPROVEMENT PERMIT / CERTIFICATE OF COMPLETION / OPERATION PERMIT / EXISTING SYSTEM INSPECTION

PROPERTY DESCRIPTION NO. 15289 DATE 12/21/94 TAX MAP NO. 18-A-91 Watershed: ☑ Yes ☐ No

OWNER OR CONTRACTOR Mildred Young PHONE: Business _____ Home _____

ADDRESS Rt 10 Box 365 Mocksville

LOCATION 1365 on (R) in 2ND drive on Post County Line Rd

SUBDIVISION 14/17 BLOCK / SECTION _____ LOT _____ LOT AREA ~ SOILS SITE CLASS. P DESIGN FLOW 240 L.T.A.R. .125-.3

Septic Tank: 1000 Gallons; STB 760 Date 5/21/94

Pump Tank: _____ Gallons; PT _____ Date _____

Pump Make: _____ Model _____ Serial No. _____

Nitrification Field: No Fields 1 Square Feet 960 Linear Feet 321

No Lines 3 Trench Width 3' Max Trench Bottom Depth 24-26" Gravel Depth 12"

☑ New System ☐ Repair System Type: I, (II), III, IV, V, VI

System Description: Conv. Dist.

Repair System Description: SAME

Maintenance Agreement Required: ☐ Yes ☐ No

☐ House/Mod. Home No. Bedrooms 2

☑ Mobile Home No. Bathrooms 2

☐ Business No. Employees _____

☐ Other _____

☐ Slab ☑ Crawl Space ☐ Basement w/plumbing ☐ Basement wo/plumbing


Water Supply: ☑ Individual ☐ Community ☐ Public DADS

Comments:


Comments: Asphalt Drive - Retaining walls system built to specs not being inspected

Entire area will need to maintain 6" cover

INITIAL SITE SKETCH

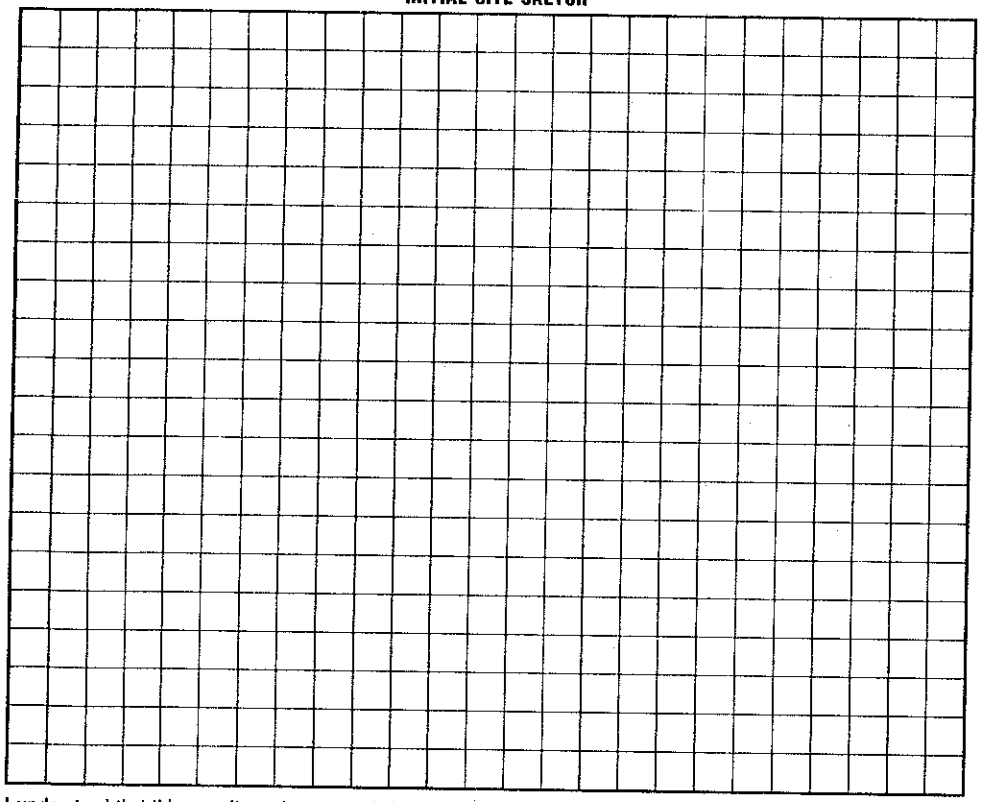

AS BUILT SKETCH

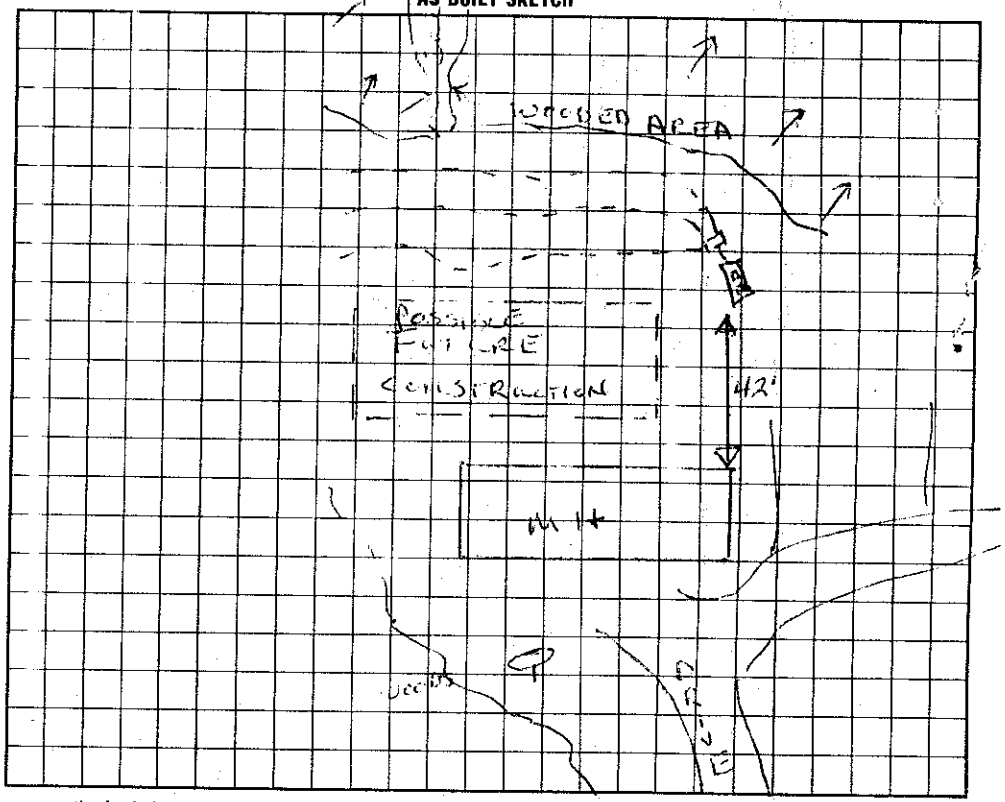

I understand that this permit can be suspended or revoked if any false information is supplied toward securing the permit/any unauthorized changes are made to the site/any unauthorized changes are made in the installation of the system. Improvement Permit is valid for 60 months from date of issuance.

Signed: _____

Improvement Permit by: _____ date _____

Existing System Inspection by: _____ date _____

Installed by: Julian Bowles

Certificate of Completion by: Wesley Sparks RS date 12/21/94

Operation Permit by: _____ date _____

HEALTH DEPT COPY: WHITE INSPECTION COPY (FINAL): GREEN OWNER COPY (FINAL): YELLOW INSPECTION COPY (INITIAL): PINK OWNER COPY (INITIAL): GOLD