IREDELL COUNTY HEALTH DEPARTMENT

4674-87-6143

STATESVILLE 704-878-5305 MOORESVILLE 704-664-5281

IMPROVEMENT PERMIT / CERTIFICATE OF COMPLETION / OPERATION PERMIT / EXISTING SYSTEM INSPECTION

PROPERTY DESCRIPTION NO. 12425 DATE 9/1/93

OWNER OR CONTRACTOR MICHAEL YOUNG TAX MAP NO. 1B-3-A-4

ADDRESS 1365, ON (L) JUST PAST JOHNSON DAIRY RD, 2ND GRAVEL DRIVE ON (L) PHONE: Business Home

LOCATION

SUBDIVISION ROCKY RIVER EST BLOCK / SECTION 1 LOT 4 LOT AREA ~ 1 AC SITE CLASS. P L.T.A.R. .35 - .4

Water Supply: ☑ Individual ☐ Community ☐ Public

Septic Tank: 1000 Gallons; STB 358 Date 7/11/93

Pump Tank: Gallons; PT Date

Nitrification Field: No Fields 1 Square Feet 700 Linear Feet 30

No Lines 4 Trench Width 36" Trench Depth 36" Gravel Depth 12"

☑ New System ☐ Repair System Type: I, II, III, IV, V, VI

System Description: CONV.

Repair System Description: CONV.

Maintenance Agreement Required: ☐ Yes ☐ No

☐ House/Mod. Home ☐ Mobile Home ☐ Business ☐ Other

No. Bedrooms No. Bathrooms No. Employees

☐ Slab ☐ Crawl Space ☐ Basement w/plumbing

Garbage Disposal: ☐ Yes ☐ No

Auto. Dishwasher: ☐ Yes ☐ No


Auto. Washing Machine: ☐ Yes ☐ No

Other ☐ Basement wo/plumbing

Comments

INITIAL SITE SKETCH

AS BUILT SKETCH N KLEIL

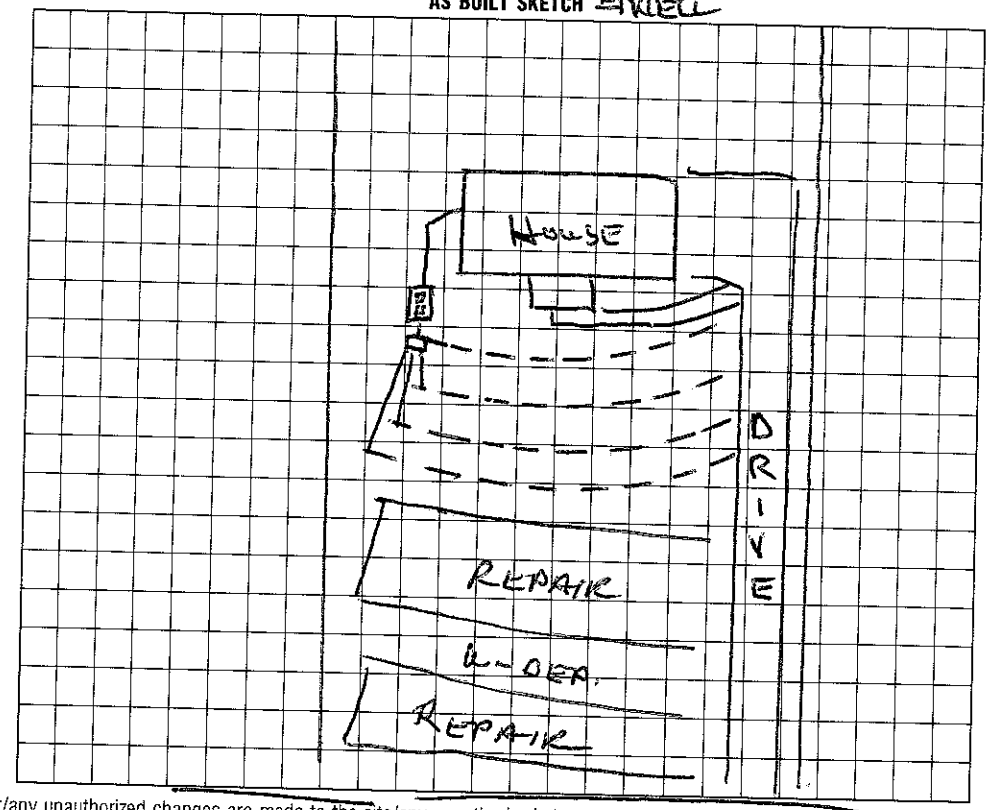

I understand that this permit can be suspended or revoked if any false information is supplied toward securing the permit/any unauthorized changes are made to the site/any unauthorized changes are made in the installation of the system. Improvement Permit is valid for 60 months from date of issuance.

Signed:

Improvement Permit by: date

Existing System Inspection by: date

Installed by: EJ ERVIN 136 PP

Certificate of Completion by: Wesley Sparks. date 9/1/93

Operation Permit by: date

HEALTH DEPT. COPY: WHITE INSPECTION COPY (FINAL): GREEN OWNER COPY (FINAL): YELLOW INSPECTION COPY (INITIAL): PINK OWNER COPY (INITIAL): GOLD