IREDELL COUNTY HEALTH DEPARTMENT

Statesville Office (704) 878-5305 Mooresville Office (704) 660-3625 PERMIT # 215333

IMPROVEMENT PERMIT / AUTHORIZATION TO CONSTRUCT / OPERATION PERMIT / EXISTING SYSTEM

PIN # 4674-37-~~6275~~ 6143

APPLICANT: MARK KENNEDY APPLICANT ADDRESS: Po Box 1477 Mooresville 28115

SITE ADDRESS: 2199 Coddle Creek Hwy PHONE: 704-877-5494 ALT. PHONE:

SITE DIRECTIONS: Hwy 3 past Del, on L 2199

SUBDIVISION: Rocky River Estates SECTION: LOT # 4 LOT AREA: 1.388 AC DESIGN FLOW: 360 L.T.A.R.: 1 (Ex. Permit)

Septic Tank Ex. 1000 (gal) STB Date

Pump Tank (gal) PT Date

Pump Make Model Serial#

Nitrification Fields EX # Lines ISTING Linear Ft:

Trench Width Max. Trench Bottom Depth Gravel Depth

☐ New System ☐ Repair ☐ Expansion System Type: I (II) III IV V VI

System Description: GRAVEL

Repair System Description: SAME

Maintenance Agreement Required: ☐ YES ☒ ~~NO~~

☒ GRAVITY ☐ PRESSURE

☒ Residence ☐ Business ☐ Other ☐ Slab ☐ Basement w/plumbing

No. Bedrooms 3 No. Persons No. Employees

☒ ~~Crawl Space~~

Water Supply: ☒ ~~Private~~ ☐ Public ☐ Community

☐ Basement w/o plumbing


Comments / Conditions:

MASTER BEDROOM EXPANSION

INITIAL SITE SKETCH

NOT ADDING BED ROOMS
EXPANDING MASTER

AS BUILT SKETCH

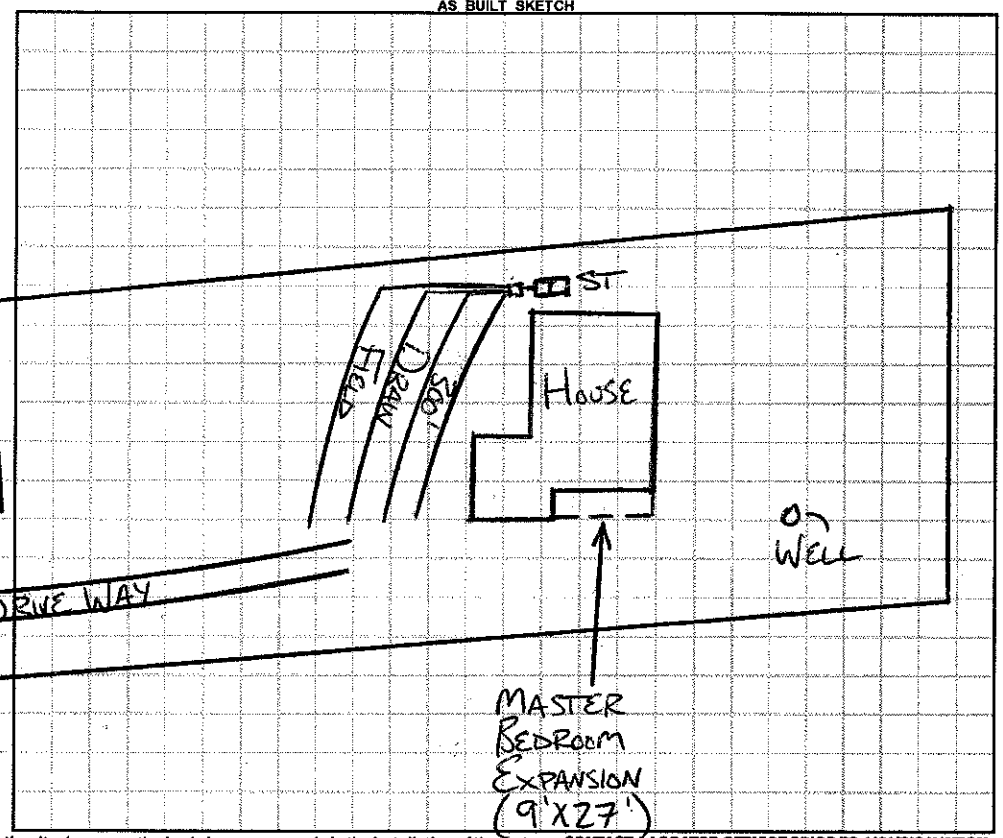

Permit can be suspended or revoked if any false information is supplied toward securing the permit / any unauthorized changes are made to the site / any unauthorized changes are made in the installation of the system. **CONTACT A LOCATOR SERVICE PRIOR TO ANY EXCAVATION**

☐ **IMPROVEMENT PERMIT** ***with plat*** *valid without expiration.* ☐ **IMPROVEMENT PERMIT** ***with site plan*** *valid for 60 mos.* ☐ **AUTHORIZATION TO CONSTRUCT** *valid for period equal to IMPROVEMENT PERMIT--not to exceed 60 mo.*

Owner / Applicant Signature: M. Kennedy Date: 1/15/16 Installed by:

IMPROVEMENT PERMIT by: Date: OPERATION PERMIT by: Date:

AUTHORIZATION TO CONSTRUCT by: Date: Existing System Inspected by: Date: 1-8-16

Health Dept. Copy - WHITE Applicant (Final Approval) - YELLOW Applicant (Conditional Approval) - PINK