IREDELL COUNTY HEALTH DEPARTMENT

STATESVILLE 704-878-5305 MOORESVILLE 704-664-5281

IMPROVEMENT PERMIT / AUTHORIZATION TO CONSTRUCT / OPERATION PERMIT / EXISTING SYSTEM INSPECTION

PERMIT# 135158 PIN# 4674374928 4674-38-4005 DATE 5-8-06

OWNER OR APPLICANT mL Young Construction PHONE: Business 704-664-2774 Home

ADDRESS 106 Legdewood Lane Mooresville 28115

LOCATION Eoddle Creek Rd TL Aragon on right 1016 Aragon Ct

SUBDIVISION Cabes Crossing BLOCK / SECTION LOT 6 LOT AREA 1.319 Ac SITE CLASS PS DESIGN FLOW 480gpd L.T.A.R. 3gpd/ft2

Septic Tank: 1000 Gallons; STB 1007 Date 4-30-08

Pump Tank: Gallons; PT Date

Pump Make: Model Serial No.

Nitrification Field: No Fields 1 Square Feet 1600 Linear Feet 400

No Lines 6@68' Trench Width 36" Max Trench Bottom Depth 36"

☒ New System ☐ Repair ☐ Expansion System Type: I (II) III IV V VI

System Description: 25% reduction gravity

Repair System Description: 25% reduction gravity

Maintenance Agreement Required: ☐ Yes ☒ No

Gravel Depth N/A ☒ Gravity ☐ Pressure ☐ Slab ☒ Crawl Space ☐ Basement w/plumbing ☐ Basement wo/plumbing

☒ House/Mod. Home ☐ Mobile Home ☐ Business ☐ Other

No. Bedrooms 4 No. Persons 8 No. Employees


Water Supply: ☒ Individual ☐ Public ☐ Community

Comments/Conditions: Good Soil in all trenches


Comments/Conditions: Installed 3 lines 130-136 ft each (line closest to road 3.7 ft deep) Quick 4 installed Fed on end.

1" = 60'

INITIAL SITE SKETCH

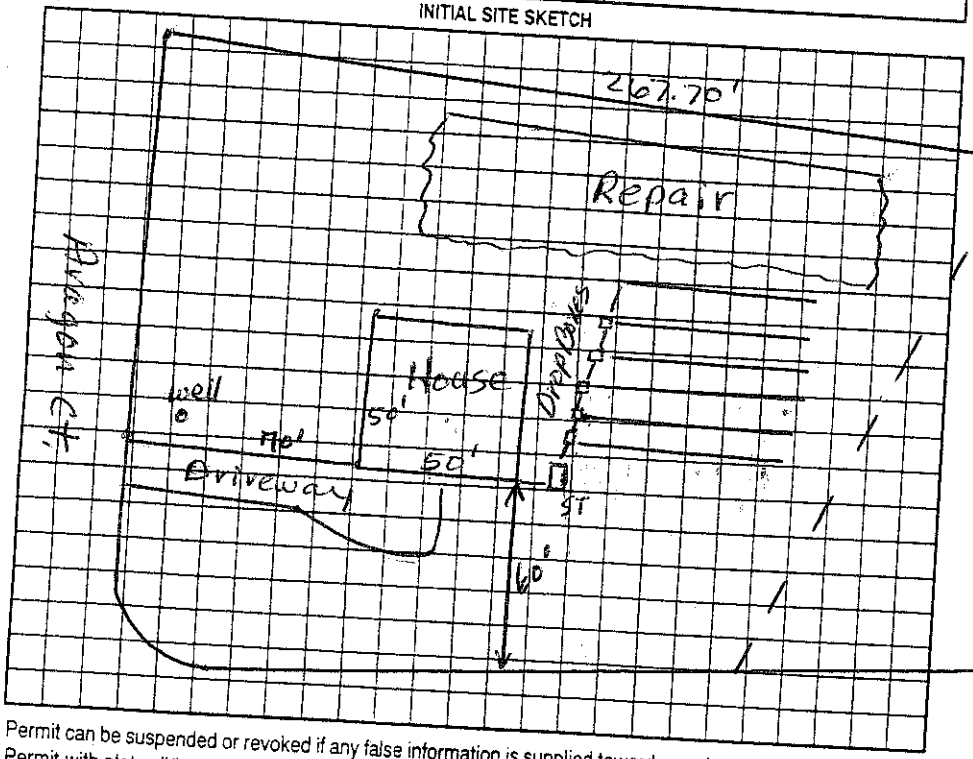

AS BUILT SKETCH

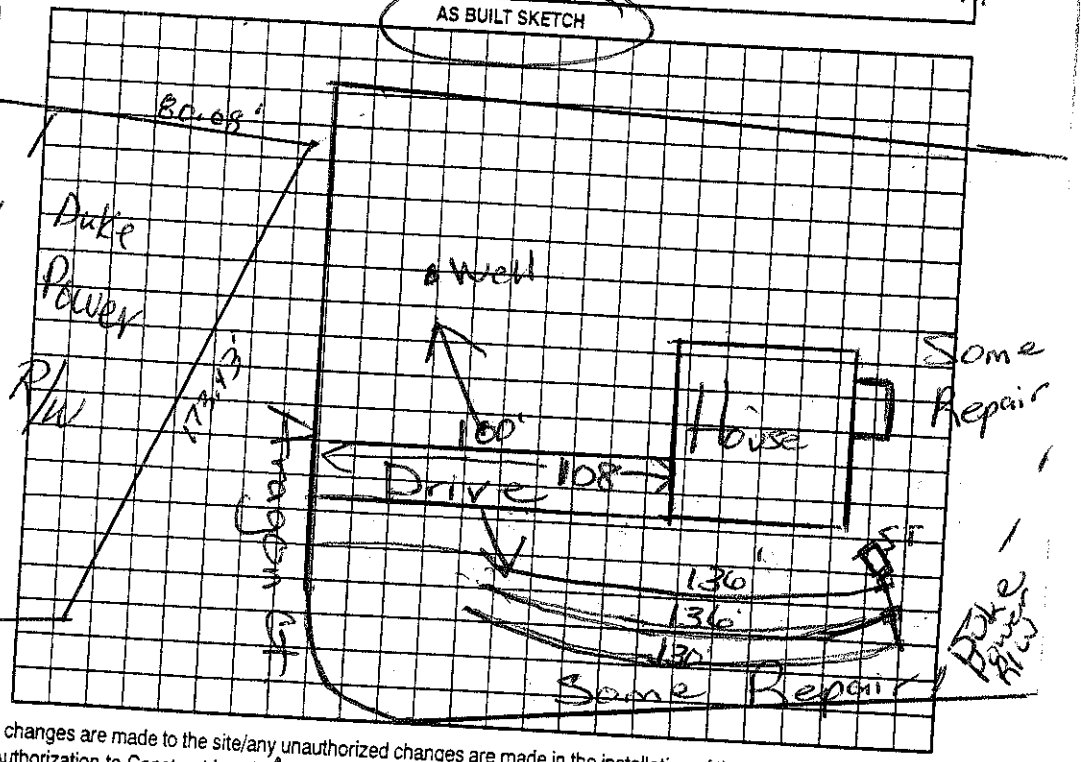

Permit can be suspended or revoked if any false information is supplied toward securing the permit/any unauthorized changes are made to the site/any unauthorized changes are made in the installation of the system. Improvement Permit with plat valid without expiration ☐ Improvement Permit with site plan valid for sixty months ☒ Authorization to Construct is valid for a period equal to that of Improvement Permit – not to exceed sixty months.

Signed:

Improvement Permit by: date 5-15-06

Authorization to Construct by: date 5-8-06

Installed by: A & S Grading

Operation Permit by: date 1/23/08

Existing System Inspection by: date 6/9/08

HEALTH DEPT. COPY: WHITE OWNER COPY (FINAL): YELLOW OWNER COPY (INITIAL): PINK