550.00 Paid 3.00

IREDELL COUNTY HEALTH DEPARTMENT

STATESVILLE 704-878-5305 MOORESVILLE 704-664-5281

IMPROVEMENT PERMIT / AUTHORIZATION TO CONSTRUCT / OPERATION PERMIT / EXISTING SYSTEM INSPECTION

PERMIT# 133920 PIN# ~~4674376947~~ 4674334259 DATE 3-6-06

OWNER OR APPLICANT Michael Young PHONE: Business 704-363-5571 Home

ADDRESS 221 Fourtrax Dr

LOCATION Hwy 3 south on left across from Johnson Dairy Rd

SUBDIVISION BLOCK / SECTION LOT LOT AREA 2.88 Ac SITE CLASS. PS DESIGN FLOW 480gpd L.T.A.R. .3 gpd, .25 Repair

Septic Tank: 1000 Gallons: STB 1007 Date 4-30-08
Pump Tank: 1000 Gallons: PT 274 Date 4-23-08
Pump Make: Zoeller Model ~~NR152-8~~ Serial No.
Nitrification Field: No Fields 1 Square Feet 1600 Linear Feet 400
No Lines 4@100' Trench Width 36" Max Trench Bottom Depth 36"

☒ New System ☐ Repair ☐ Expansion System Type: I II III IV V VI
System Description: 25% reduction, pump pm
Repair System Description: 25% Red. pump 24" Max trench bottom
Maintenance Agreement Required: ☐ Yes ☒ No

☒ House/Mod. Home No. Bedrooms 4
☐ Mobile Home No. Persons
☐ Business No. Employees
☐ Other


Water Supply: ☒ Individual ☐ Public ☐ Community

Gravel Depth NA ☐ Gravity ☒ Pressure ☐ Slab ☐ Crawl Space ☒ Basement w/plumbing ☐ Basement wo/plumbing

Comments:/Conditions: Hold AC until deed recorded
5/14/08 Deed Copy Attached.
Pump = Zoeller N152-8

Comments:/Conditions: 5/14/08 Reviewed Floor plans House Footprint larger than shown but will be adjusted to Septic fits as shown.
11/6/08 Eff pressure set, Checked tanks & lines Installed Quick Lt as drawn

INITIAL SITE SKETCH

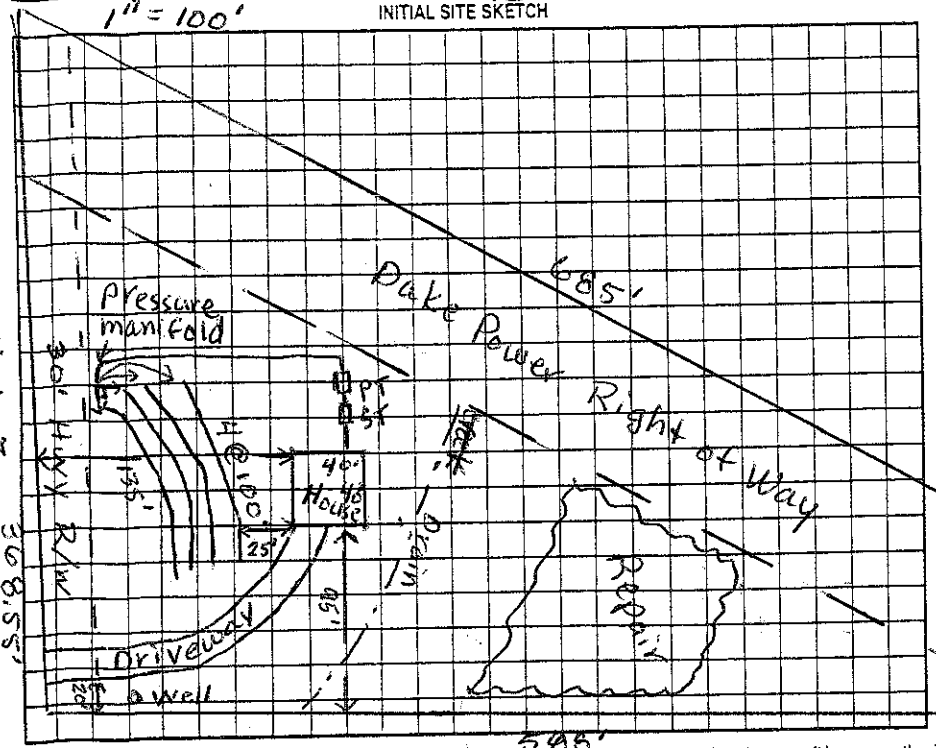

AS BUILT SKETCH

Permit can be suspended or revoked if any false information is supplied toward securing the permit/any unauthorized changes are made to the site/any unauthorized changes are made in the installation of the system. Improvement Permit with plat valid without expiration ☐ Improvement Permit with site plan valid for sixty months ☒ Authorization to Construct is valid for a period equal to that of Improvement Permit – not to exceed sixty months.

Owner: date

Improvement Permit by: date 3-7-06

Authorization to Construct by: date 5/14/08

Installed by: A&S Grading Ketts date 4/1/2010

Operation Permit by: date

Existing System Inspection by: date

HEALTH DEPT. COPY: WHITE OWNER COPY (FINAL): YELLOW OWNER COPY (INITIAL): PINK