IREDELL COUNTY HEALTH DEPARTMENT

Statesville Office (704) 878-5305 Mooresville Office (704) 660-3625

AMP PERMIT # 210820

IMPROVEMENT PERMIT / AUTHORIZATION TO CONSTRUCT / OPERATION PERMIT / EXISTING SYSTEM

PIN # 4674-38-7342 .000

APPLICANT: Charlotte Pools APPLICANT ADDRESS: 1458 Brawley School Rd. Mooresville NC

SITE ADDRESS: 117 Aragon Ct. Mooresville NC PHONE: 704-799-7575 ALT. PHONE: 704-564-5136

SITE DIRECTIONS: Hwy 115 to Hwy 3, TL on Aragon Ct, Site at End.

SUBDIVISION: Cares Crossing SECTION: - LOT # 2 LOT AREA: 1.934 Acre DESIGN FLOW: 360 GPD. L.T.A.R.: Existing

Septic Tank Existing (gal) STB Date

Pump Tank Existing (gal) PT Date

Pump Make Existing Model Existing Serial # Existing

Nitrification Fields Ex. # Lines Existing 3 Linear Ft: Ex. 240'

Trench Width Existing Max. Trench Bottom Depth Existing Gravel Depth Sand

☐ New System ☐ Repair ☐ Expansion System Type: I II III (IV) V VI

System Description: Existing LP - Panel

Repair System Description: LP - Panel

Maintenance Agreement Required: ☒ YES ☐ NO ☐ GRAVITY ☒ PRESSURE

☑ Residence No. Bedrooms 3 ☐ Business No. Persons 6 ☐ Other No. Employees ☐ Slab ☐ Crawl Space ☐ Basement w/plumbing ☒ Basement w/o plumbing


Water Supply: ☑ Private ☐ Public ☐ Community

Comments / Conditions: Homeowner Began Digging For Retaining Wall Before Existing System Inspection. 4th Line of Existing System Was Exposed Upon Inspection. Owner Wants To Go To A 3 Bedroom System From A 4 Bedroom And Use An Existing Bedroom As An Office/Study. Upon Inspection, 4th Line Was Cut Off And Pressure Set For Existing 3 Lines And Appeared To Function.

INITIAL SITE SKETCH

1" = 50'

AS BUILT SKETCH

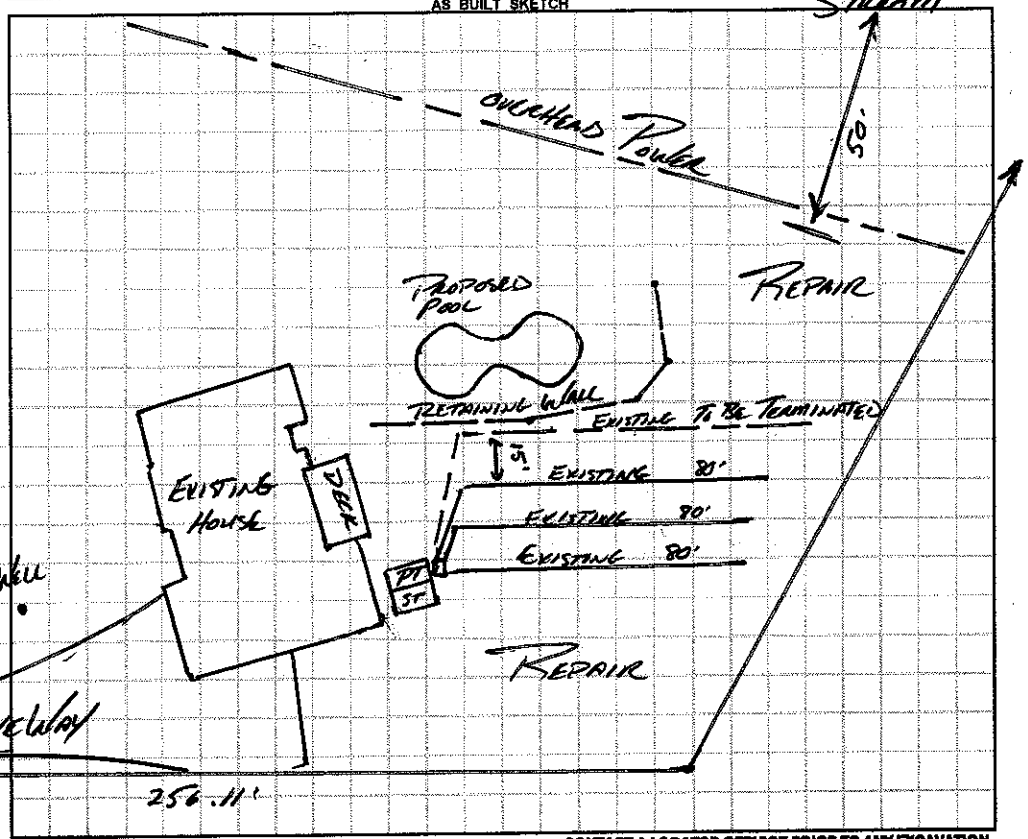

Permit can be suspended or revoked if any false information is supplied toward securing the permit / any unauthorized changes are made to the site / any unauthorized changes are made in the installation of the system. **CONTACT A LOCATOR SERVICE PRIOR TO ANY EXCAVATION**


☐ **IMPROVEMENT PERMIT** *with plat valid without expiration.* ☐ **IMPROVEMENT PERMIT** *with site plan valid for 60 mos.* ☐ **AUTHORIZATION TO CONSTRUCT** *valid for period equal to IMPROVEMENT PERMIT--not to exceed 60 mo.*

Owner / Applicant Signature: [signature] Date: 7/1/2015 Installed by:

IMPROVEMENT PERMIT by: Date: OPERATION PERMIT by: Date:

AUTHORIZATION TO CONSTRUCT by: Date: Existing System Inspected by: APPROVED Date: JUL 25 2015

Health Dept. Copy - WHITE Applicant (Final Approval) - YELLOW Applicant (Conditional Approval) - PINK

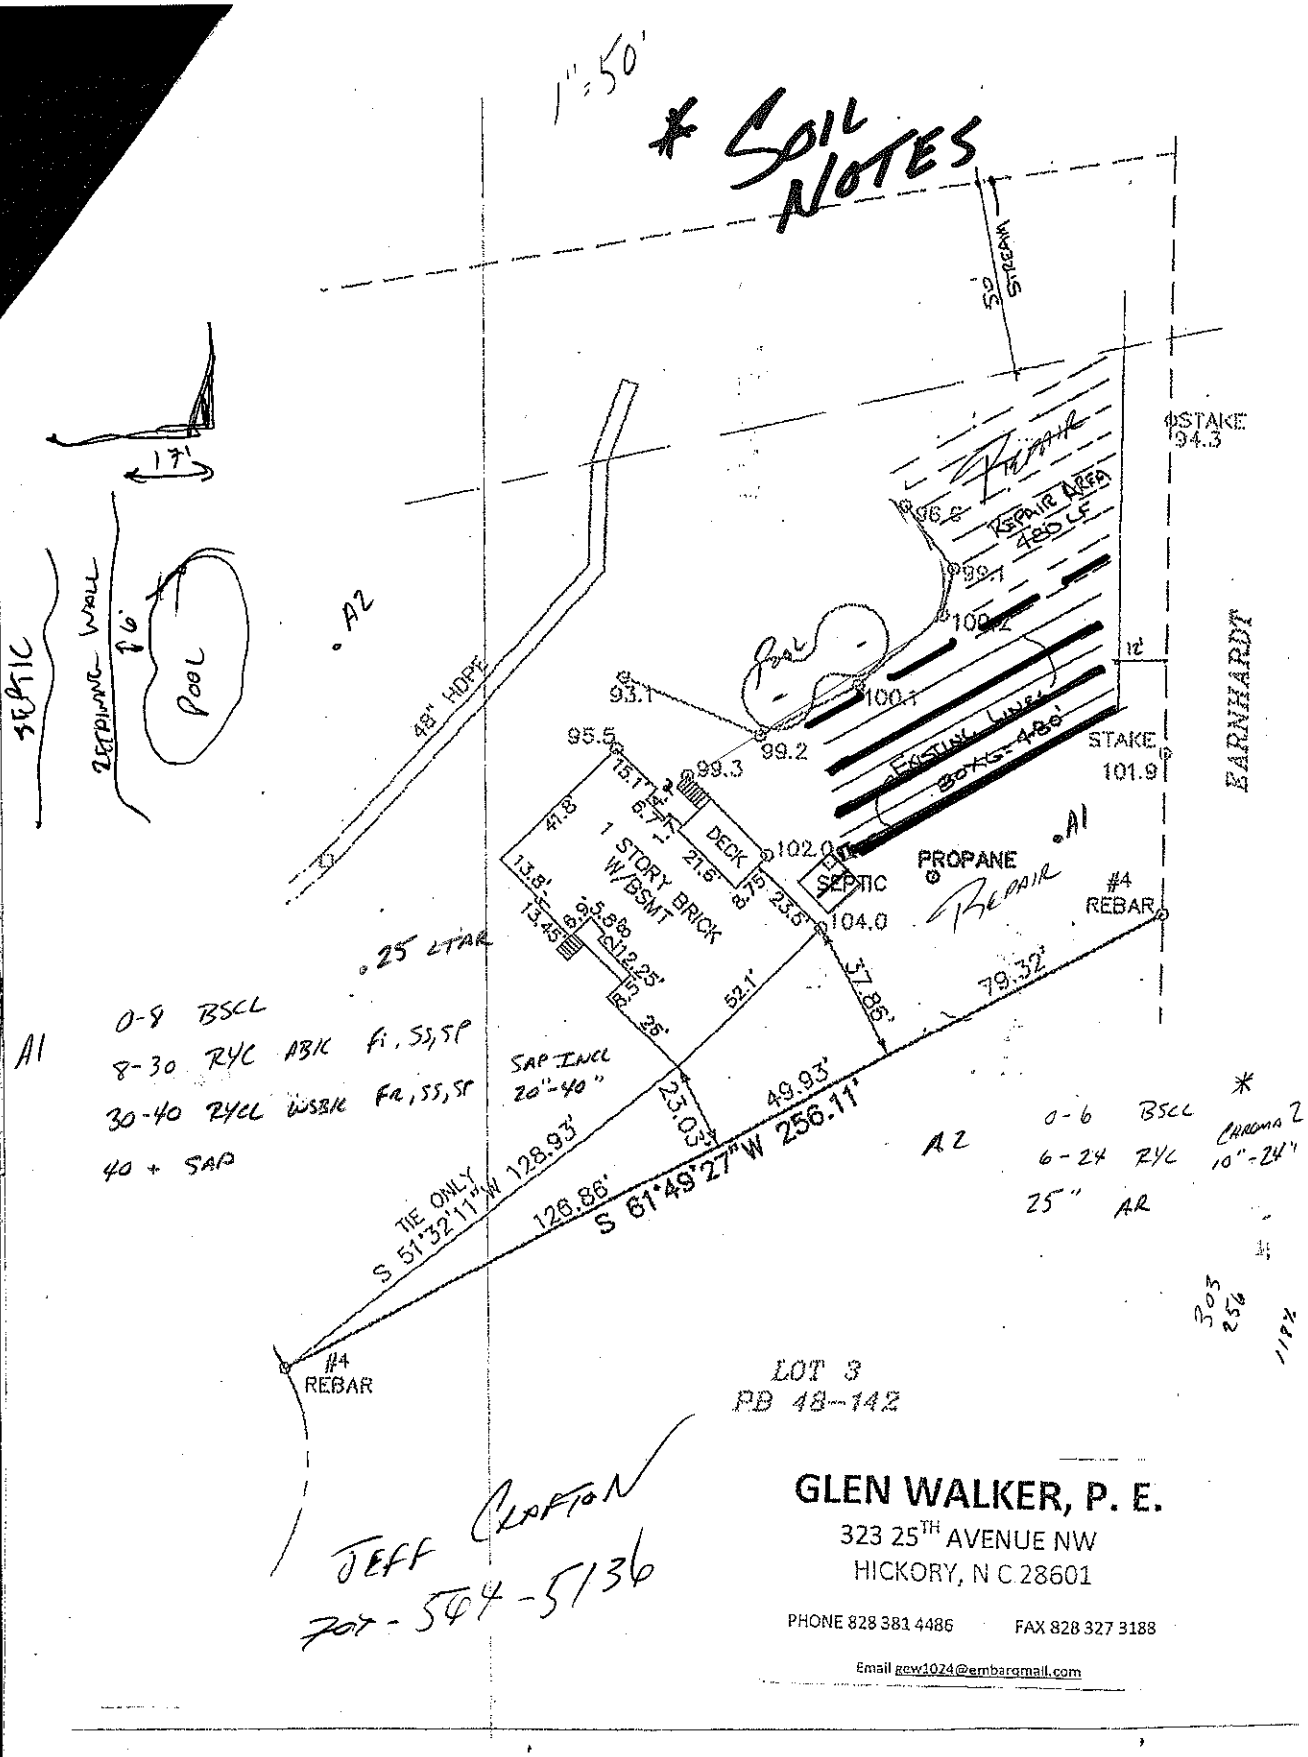
1" = 50'
* SOIL NOTES
50' STREAM
STAKE 94.3
REPAIR AREA 480 LF
96.6
99.1
100.2
12'
EARNHARDT
17'
SEPTIC
RETAINING WALL 10'
POOL
A2
48" HDPE
93.1
95.5
15.1'
99.3
99.2
100.1
EXISTING LINE
80 LF = 486'
STAKE 101.9
41.8
1 STORY BRICK W/BSMT
DECK
21.6'
6.7'
102.0
PROPANE
SEPTIC
104.0
REPAIR
A1
#4 REBAR
13.8'
13.45'
5.8'
5.8'
12.25'
8.75'
23.5'
25' LTAR
52.1'
37.85'
79.32'
A1
0-8 BSCL
8-30 RYC ABK Fi, SS, SP
30-40 RYCL WSBK Fr, SS, SP
40 + SAP
SAP INCL 20"-40"
23.03'
49.93'
TIE ONLY
S 51°32'11"W 128.93'
126.86'
S 61°49'27"W 256.11'
A2
0-6 BSCL
6-24 RYC
25" AR
Chroma 2
10"-24"
#4 REBAR
LOT 3
PB 48-142
JEFF CLAYTON
704-564-5136
GLEN WALKER, P. E.
323 25TH AVENUE NW
HICKORY, N C 28601
PHONE 828 381 4486
FAX 828 327 3188
Email gew1024@embarqmail.com