11/30-12-10

IREDELL COUNTY HEALTH DEPARTMENT

STATESVILLE 704-878-5305 MOORESVILLE 704-664-5281

IMPROVEMENT PERMIT / AUTHORIZATION TO CONSTRUCT / OPERATION PERMIT / EXISTING SYSTEM INSPECTION

PERMIT# 135142 / 142-811 PIN# 4674388134 DATE 5-9-06

OWNER OR APPLICANT ML Young Construction Inc PHONE: Business 704-363-5571 Home 704-664-2774

ADDRESS ~~Coddle Creek Rd (Hwy 3) Tl Aragon Ct at end~~ 106 Ledgewood Ln Mooresville 28115

LOCATION Hwy 3 (Coddle Creek Rd) Tl Aragon at end

SUBDIVISION Cabes Crossing BLOCK / SECTION ____ LOT 3 LOT AREA 1.048 SITE CLASS. PS DESIGN FLOW 480gpd L.T.A.R. .3 gpd/ft²

Septic Tank: 1000 Gallons; STB 1007 Date 11-20-06
Pump Tank: ____ Gallons; PT ____ Date ____
Pump Make: ____ Model ____ Serial No. ____
Nitrification Field: No Fields 1 Square Feet 1600 Linear Feet 400
No Lines 5 Trench Width 36" Max Trench Bottom Depth 36"

☑ New System ☐ Repair ☐ Expansion System Type: I II III IV V VI
System Description: 25% reduction gravity
Repair System Description: 25% reduction pump
Maintenance Agreement Required: ☐ Yes ☒ No

☑ House/Mod. Home No. Bedrooms 4
☐ Mobile Home No. Persons ____
☐ Business No. Employees ____
☐ Other ____


Water Supply: ☑ Individual ☐ Public ☐ Community

Gravel Depth NA ☑ Gravity ☐ Pressure ☐ Slab ☑ Crawl Space ☐ Basement w/plumbing ☐ Basement wo/plumbing


Comments:/Conditions: D-Box w/ Equalizers or speed levelers
If unable to plumb out to ST location a pump must be used
1"=60'

Comments:/Conditions: Installed Quick 4 Drainfield
~~Any Future pool must be 15ft from~~ Septic System

INITIAL SITE SKETCH 349.79'

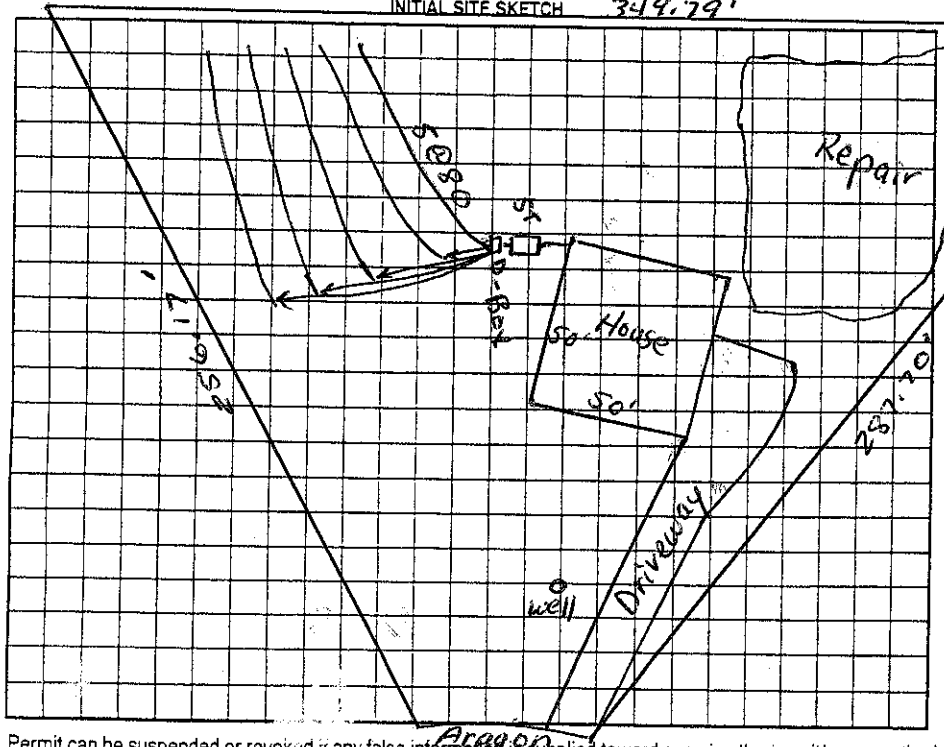

AS BUILT SKETCH

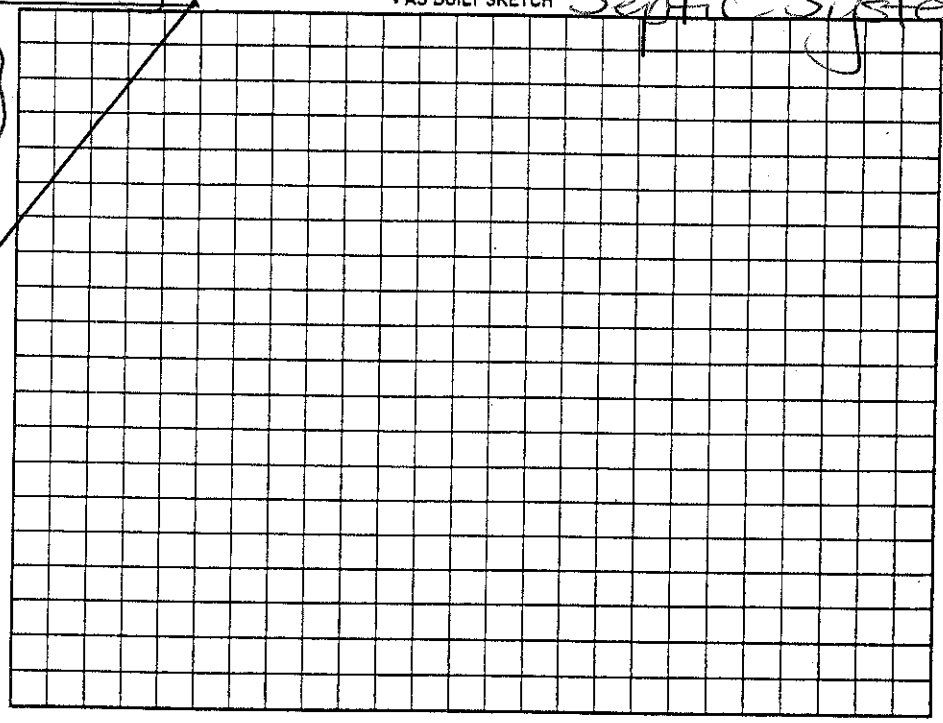

Permit can be suspended or revoked if any false information is supplied toward securing the permit/any unauthorized changes are made to the site/any unauthorized changes are made in the installation of the system. Improvement Permit with plat valid without expiration ☐ Improvement Permit with site plan valid for sixty months ☒ Authorization to Construct is valid for a period equal to that of Improvement Permit – not to exceed sixty months.

Signed: ____ date 5-15-06 Installed by: A&S Trenching

Improvement Permit by: Mary Melville date 5-9-06 Operation Permit by: Mariah H Dolan RS date 1/12/07

Authorization to Construct by: Wesley Sparkes date 8/7/06 Existing System Inspection by: ____ date ____

HEALTH DEPT. COPY: WHITE OWNER COPY (FINAL): YELLOW OWNER COPY (INITIAL): PINK