IREDELL COUNTY HEALTH DEPARTMENT

STATESVILLE 704-878-5[illegible] MOORESVILLE 704-664-5281

IMPROVEMENT PERMIT / AUTHORIZATION TO CONSTRUCT / OPERATION PERMIT / EXISTING SYSTEM INSPECTION

PERMIT# 143294 PIN# 4674396320,000 DATE 7/2/07

OWNER OR APPLICANT Judith & Allen Warlick PHONE: Business 704 662-2886 Home 704 663-5684

ADDRESS 2067 Coddle Creek Hwy. Mooresville NC 28115

LOCATION 2093 Coddle Creek Hwy Mooresville NC 28115

SUBDIVISION N/A BLOCK / SECTION _____ LOT 4 pm LOT AREA 2.87 acres SITE CLASS. PS DESIGN FLOW 360 L.T.A.R. .3

Septic Tank: 1000 Gallons; STB 760 Date 4/17/07
Pump Tank: _____ Gallons; PT _____ Date _____
Pump Make: _____ Model _____ Serial No. _____
Nitrification Field: No Fields 1 Square Feet 900' Linear Feet 300'
No Lines 3 Trench Width 36" Max Trench Bottom Depth 36" Gravel Depth N/A ☑ Gravity ☐ Pressure

☑ New System ☐ Repair ☐ Expansion System Type: I (II) III IV V VI
System Description: Gravity 25% Reduction
Repair System Description: Same
Maintenance Agreement Required: ☐ Yes ☑ No

☐ House/Mod. Home ☑ Mobile Home ☐ Business ☐ Other
No. Bedrooms 3 No. Persons ___ No. Employees ___


Water Supply: ☑ Individual ☐ Public ☐ Community

☐ Slab ☐ Crawl Space ☐ Basement w/plumbing ☐ Basement wo/plumbing


Comments/Conditions: Applicant may use existing well on adjacent lot. If installing well maintain min. 100' from septic system, Repair Area, and adjacent Lot septic System. * System requires Serial Distribution or Drop box with Speed levelers.

Comments/Conditions: 8/15/07 red poly-lock filter installed. No well on site at time of inspection. System installed as designed. No home onsite at time of inspection. AC

INITIAL SITE SKETCH (NTS)

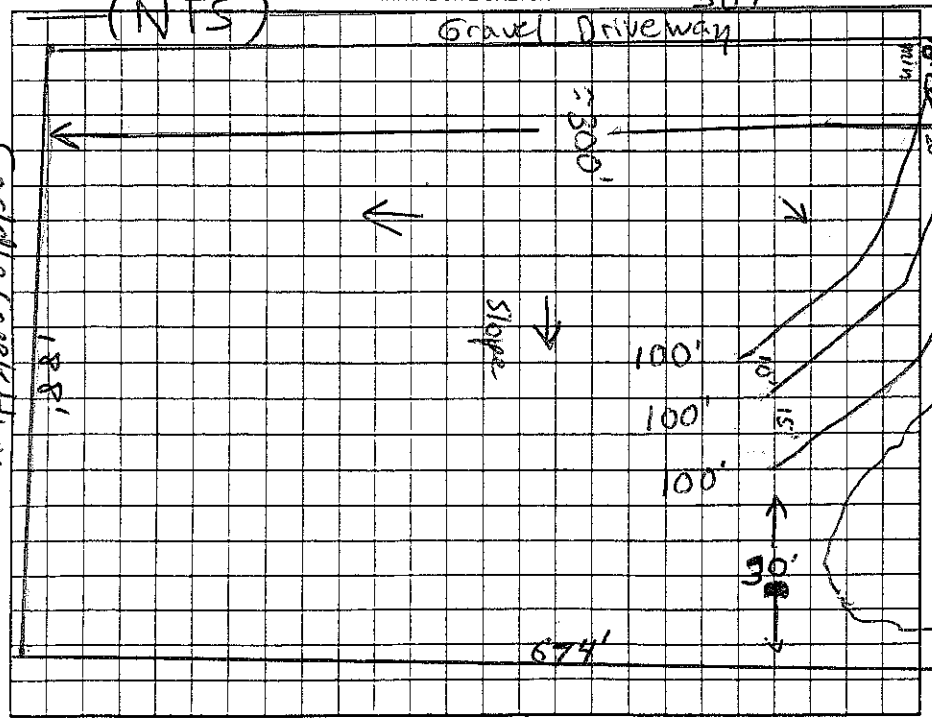

AS BUILT SKETCH

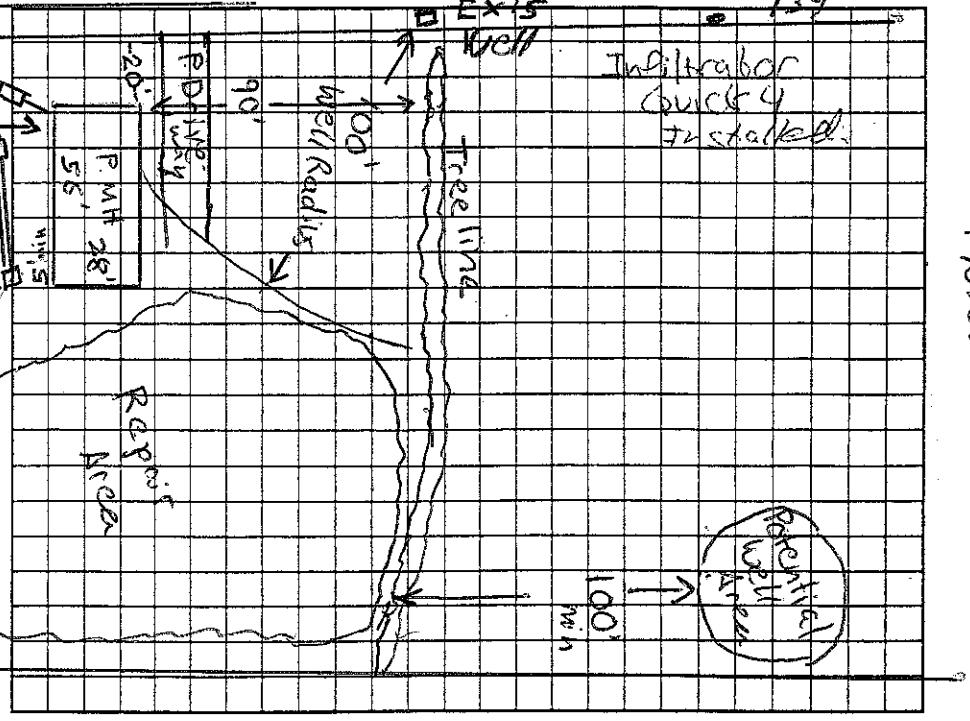

Permit can be suspended or revoked if any false information is supplied toward securing the permit/any unauthorized changes are made to the site/any unauthorized changes are made in the installation of the system. Improvement Permit with plat valid without expiration. ☐ Improvement Permit with site plan valid for sixty months ☑ Authorization to Construct is valid for a period equal to that of Improvement Permit – not to exceed sixty months.

Signed Judith Warlick date 7-3-07
Improvement Permit by: Anthony Cokes Jr. date 7/2/07
Authorization to Construct by: Anthony Cokes Jr. date 7/2/07

Installed by: Abee's Grading
Operation Permit by: Anthony Cokes Jr. date 8/15/07
Existing System Inspection by: _____ date _____

HEALTH DEPT. COPY: WHITE OWNER COPY (FINAL): YELLOW OWNER COPY (INITIAL): PINK