REBELL COUNTY HEALTH DEPARTMENT

STATESVILLE 704-878-5305 MOORESVILLE 704-664-5281

IMPROVEMENT PERMIT / AUTHORIZATION TO CONSTRUCT / OPERATION PERMIT / EXISTING SYSTEM INSPECTION

PERMIT # Repair PIN # 4674445521 DATE 10-1-2012

OWNER or APPLICANT Alan Goodman PHONE: Business 704425-2525 Home: 7046666-0000

OWNER or APPLICANT ADDRESS 13000 Mooresville Rd Davidson NC 28036

LOCATION / DIRECTIONS Hwy 3 South MH on left after Coddle Creek Church before Earnhardt Lake Rd

SUBDIVISION — BLOCK / SECTION — LOT # — LOT AREA Acreage DESIGN FLOW 240gpd L.T.A.R. #3

Septic Tank Existing Gallons: STB 825 Date 11-11-12

Pump Tank — Gallons: P T — Date —

Pump Make — Model — Serial # —

Nitrification Field No Fields 1 No Lines 2 Linear Feet 268FT

Trench Width 36" Max. Trench Bottom Depth 28"-36" Gravel Depth 12"

☐ New System ☒ Repair ☐ Expansion System Type I (II) III IV V VI

System Description: Gravity – Conventional

Repair System Description: Gravity – Conventional

Maintenance Agreement Required ☐ YES ☒ NO

☒ GRAVITY ☐ PRESSURE


☒ Residence No. Bedrooms 2 ☐ Business No. Persons — ☐ Other No. Employees — ☐ Slab ☒ Crawl Space ☐ Basement w/plumbing ☐ Basement w/o plumbing

Water Supply ☐ Private well location ☒ Cross Earnhardt Lk. Rd ☐ Public ☐ Community

Comments / Conditions Note: May use "Bullrun valve" to switch between Drainfields OK to use Existing ST if Structurally sound.

Comments / Conditions ~~Owner~~ Owner wants to use Conventional/ Gravel Drainfield. Installed new lines to feed top line & back up into 2nd line & then over-flow into old existing line

INITIAL SITE SKETCH

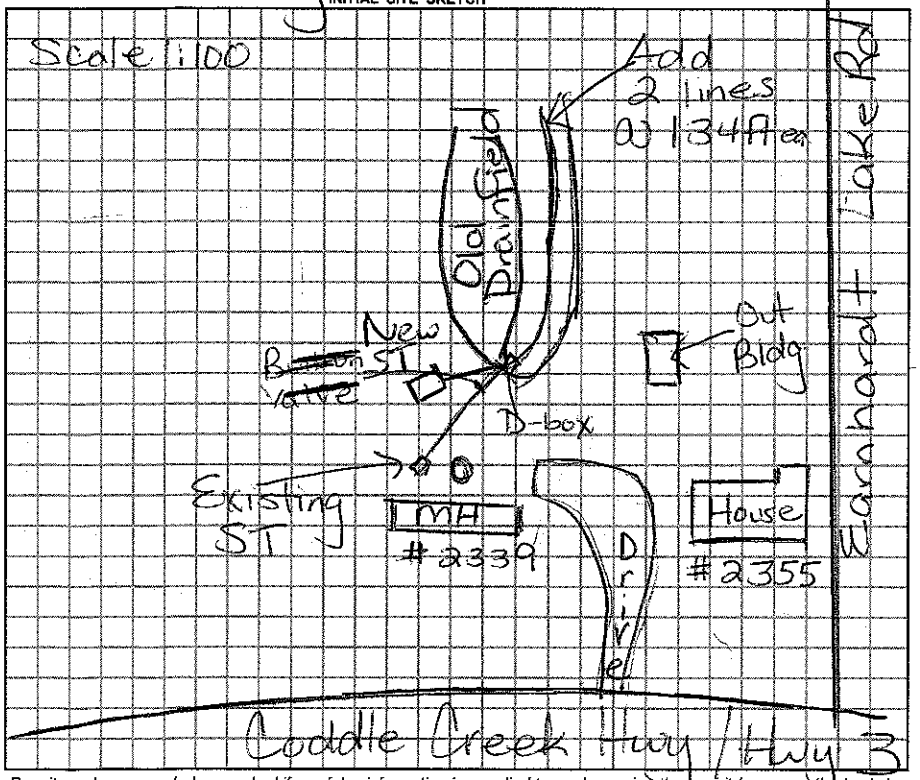

AS BUILT SKETCH

Permit can be suspended or revoked if any false information is supplied toward securing the permit / any unauthorized changes are made to the site / any unauthorized changes are made in the installation of the system.

☐ IMPROVEMENT PERMIT w / plat valid without expiration. ☐ IMPROVEMENT PERMIT w / site plan valid for 60 mos. ☐ AUTHORIZATION TO CONSTRUCT valid for period equal to IMPROVEMENT PERMIT-not to exceed 60 mo.

Owner / Applicant Signature: Alan Goodman Date 10/24/12

Improvement Permit by: Maria H. Colson RS Date 10/1/12

Authorization to Construct by: Maria H. Colson RS Date 10/1/12

Installed by: Piedmont Septic RS

Operation Permit by: Maria H. Colson Date 1/10/13

Existing System Inspected by: — Date: —

YOU SHOULD CONTACT A LOCATOR SERVICE PRIOR TO ANY EXCAVATION.

WHITE COPY Environmental Health YELLOW COPY (Final) Owner / Applicant PINK COPY (Initial) Owner / Applicant