4674-45-1238

IREDELL COUNTY HEALTH DEPARTMENT

STATESVILLE 704-878-5305 MOORESVILLE 704-664-5281

IMPROVEMENT PERMIT / CERTIFICATE OF COMPLETION / OPERATION PERMIT / EXISTING SYSTEM INSPECTION

PROPERTY DESCRIPTION NO. 22155 DATE 9/18/95 TAX MAP NO. 1A-A-24 Watershed: ☒ Yes ☐ No

OWNER OR CONTRACTOR Caddle Creek ARP Presbyterian Church PHONE: Business 784-4599 Home

ADDRESS 2297 Caddle Creek Hwy Mooresville, NC. 28115

LOCATION 1365 on (2) Patterson Farm Rd, (R) into parking lot

SUBDIVISION N/A BLOCK / SECTION LOT LOT AREA 0 SITE CLASS PS DESIGN FLOW 600 L.T.A.R. .3

Septic Tank: 1250 - Gallons; STB Date 1/21/96

Pump Tank: 1250 - Gallons; STB Date 1/24/96

Pump Make: Model Serial No.

Nitrification Field: No Fields 1 Square Feet 2000 Linear Feet 666

No Lines 5 Trench Width 36" Max Trench Bottom Depth 36" Gravel Depth 12"

☒ New System ☐ Repair System Type: I, (II) III, IV, V, VI

System Description: CONV - DIST BOX

Repair System Description: SAME

Maintenance Agreement Required: ☐ Yes ☒ No

☐ House/Mod. Home No. Bedrooms

☐ Mobile Home No. Bathrooms

☐ Business No. Employees

☒ Other 200 PERSON FELLOWSHIP


☐ Slab ☒ Crawl Space ☐ Basement w/plumbing ☐ Basement wo/plumbing

Water Supply: ☒ Individual ☐ Community ☐ Public

Comments:
(1) Location under parking area (2) location better for septic tank


Comments:
(1) Distro-Trap - STB825 - 1/21/96 - 1000 GAL
(2) SIT
3 GAL PER SEAT

INITIAL SITE SKETCH

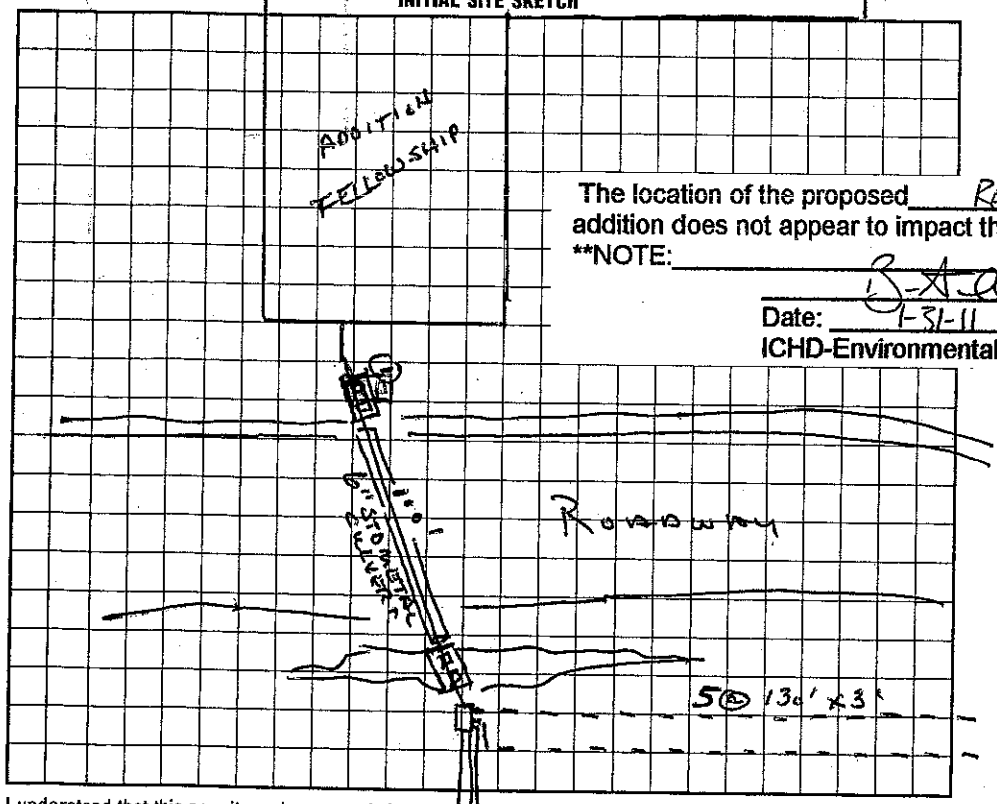

The location of the proposed RENOVATION / NEW BLDG addition does not appear to impact the existing septic system.
**NOTE:
REHS
Date: 1-31-11
ICHD-Environmental Health Division

AS BUILT SKETCH

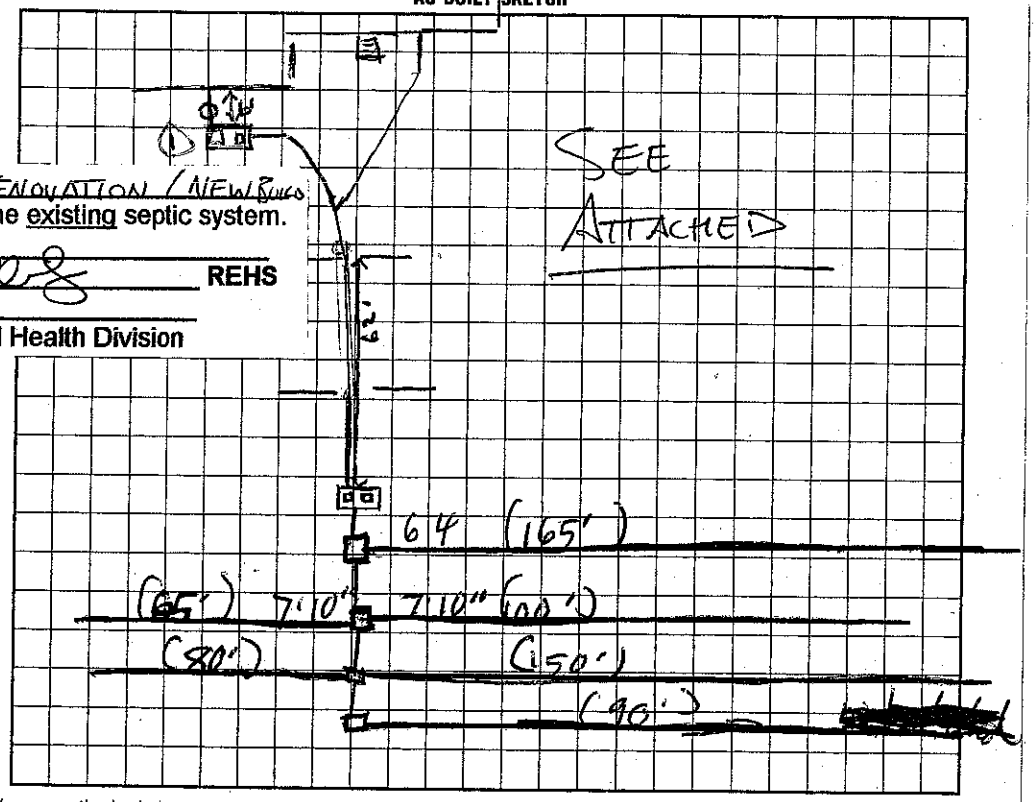

I understand that this permit can be suspended or revoked if any false information is supplied toward securing the permit/any unauthorized changes are made to the site/any unauthorized changes are made in the installation of the system.

Signed: James E. Sherrill Jr

Improvement Permit by: Wesley Sparks R.S. date 9/18/95

Existing System Inspection by: date

Installed by: Piedmont Septic Tank - 857-6420

Certificate of Completion by: date

Operation Permit by: C. Bunty Freeman EHS date 4/8/96

HEALTH DEPT. COPY: WHITE INSPECTION COPY (FINAL): GREEN OWNER COPY (FINAL): YELLOW INSPECTION COPY (INITIAL): PINK OWNER COPY (INITIAL): GOLD