4674-45-1238

IREDELL COUNTY HEALTH DEPARTMENT

STATESVILLE 704-878-5305 MOORESVILLE 704-664-5281

IMPROVEMENT PERMIT / CERTIFICATE OF COMPLETION / OPERATION PERMIT / EXISTING SYSTEM INSPECTION

PROPERTY DESCRIPTION NO. 22155 DATE 9/18/95 TAX MAP NO. 1A-A-24 Watershed: [X] Yes [ ] No

OWNER OR CONTRACTOR Caddle Creek ARP Presbyterian Church PHONE: Business 784-4599 Home

ADDRESS 2297 Caddle Creek Hwy Mooresville, NC. 28115

LOCATION 1365 on (L) Patterson Farm Rd, (R) into parking lot

SUBDIVISION N/A BLOCK / SECTION LOT LOT AREA 0 SITE CLASS. PS DESIGN FLOW 600 L.T.A.R. .3

Septic Tank: 1250 - Gallons; STB Date 1/21/96

Pump Tank: 1250 - Gallons; ~~PT~~ STB Date 1/24/96

Pump Make: Model Serial No.

Nitrification Field: No Fields 1 Square Feet 2000 Linear Feet 666

No Lines 5 Trench Width 36" Max Trench Bottom Depth 36" Gravel Depth 12"

[X] New System [ ] Repair System Type: I, (II) III, IV, V, VI

System Description: CONV - DIST BOX

Repair System Description: SAME

Maintenance Agreement Required: [ ] Yes [X] No

[ ] House/Mod. Home No. Bedrooms

[ ] Mobile Home No. Bathrooms

[ ] Business No. Employees

[X] Other 2 PERSON FELLOWSHIP


[ ] Slab [X] Crawl Space [ ] Basement w/plumbing [ ] Basement wo/plumbing

Water Supply: [X] Individual [ ] Community [ ] Public


Comments:
(1) Location under parking area (2) location better for septic tank.

Comments:
(1) Drop-Trap - STB825 - 1/21/96 - 1000 GAL
(2) SIT - 3 GAL PER SEAT

INITIAL SITE SKETCH

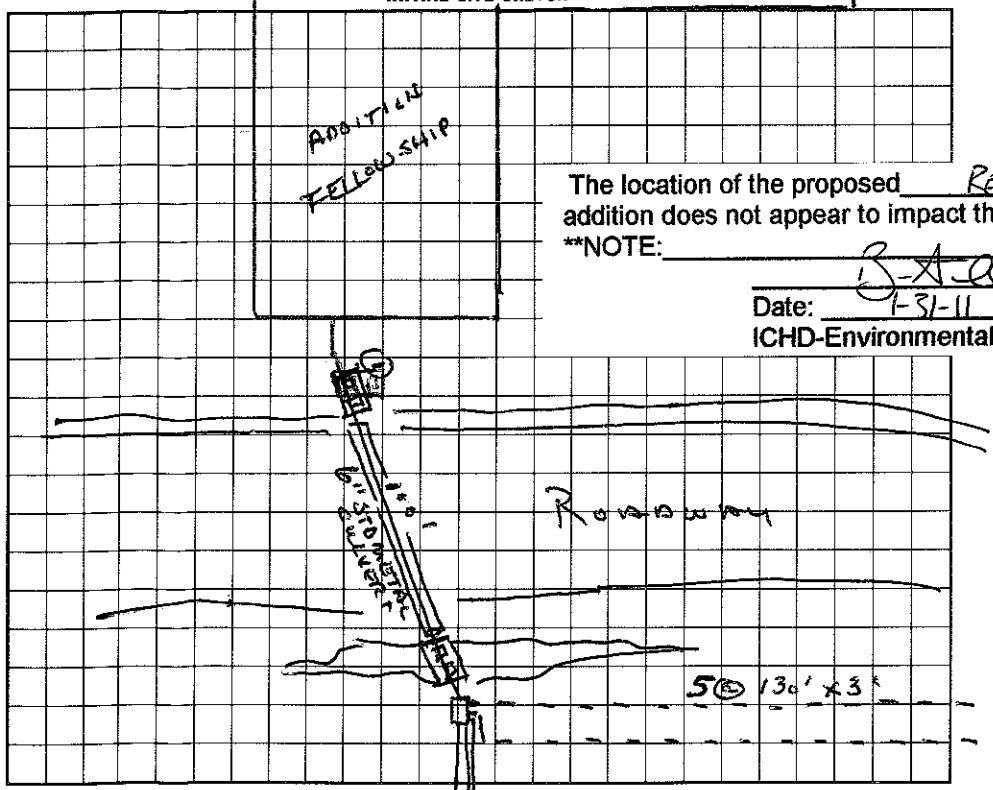

AS BUILT SKETCH

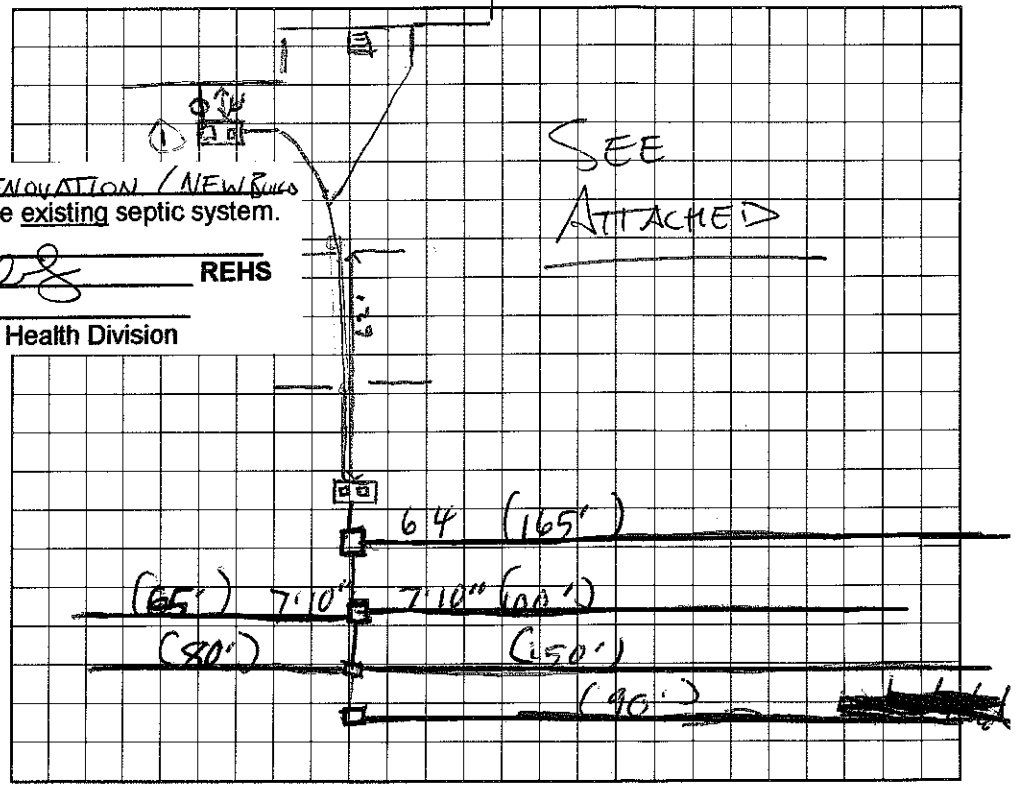

The location of the proposed RENOVATION / NEW BLDG addition does not appear to impact the existing septic system.

**NOTE:

REHS

Date: 1-31-11

ICHD-Environmental Health Division

I understand that this permit can be suspended or revoked if any false information is supplied toward securing the permit/any unauthorized changes are made to the site/any unauthorized changes are made in the installation of the system.

Signed: James E. Sherrill Jr

Improvement Permit by: Wesley Sparks R.S. date 9/18/95

Existing System Inspection by: date

Installed by: Piedmont Septic Tanks - 857-6426

Certificate of Completion by: date

Operation Permit by: C. Brady Thomas EHSP date 4/8/96

HEALTH DEPT. COPY: WHITE INSPECTION COPY (FINAL): GREEN OWNER COPY (FINAL): YELLOW INSPECTION COPY (INITIAL): PINK OWNER COPY (INITIAL): GOLD