IREDELL COUNTY HEALTH DEPARTMENT

STATESVILLE 704-878-5305 130.00 Paid MOORESVILLE 704-664-5281

IMPROVEMENT PERMIT / AUTHORIZATION TO CONSTRUCT / OPERATION PERMIT / EXISTING SYSTEM INSPECTION

PERMIT# 109796 PIN# 4674 64 0785 DATE 11/19/02

OWNER OR CONTRACTOR Mark Craft PHONE: Business Home 704-938-3015

ADDRESS 9340 Wright Rd. Huntersville Station, NC 28080 10790 Archer Rd.

LOCATION 1365 TL Eisenhardt Lake Rd. TL Archer Rd. TL 10800 drive past house to Mod on (L)

SUBDIVISION BLOCK / SECTION LOT LOT AREA 5.3 Ac SITE CLASS PS DESIGN FLOW 360 L.T.A.R. .3

Septic Tank: 1000 Gallons; STB 794 Date 2/28/03
Pump Tank: Gallons; PT Date
Pump Make: Model Serial No.
Nitrification Field: No Fields 1 Square Feet 900* Linear Feet 300*
No Lines 4@75' Trench Width 3' Max Trench Bottom Depth 3'

☒ New System ☐ Repair System Type: I, II, III, IV, V, VI
System Description: 25% Reduced Drainfield
Repair System Description: Same
Maintenance Agreement Required: ☐ Yes ☒ No
Gravel Depth No ☐ Slab ☒ Crawl Space ☐ Basement w/plumbing ☐ Basement wo/plumbing


☒ House/Mod. Home No. Bedrooms 3
☐ Mobile Home No. Bathrooms 3
☐ Business No. Employees
☐ Other

Water Supply: ☒ Individual ☐ Public ☐ Community

Comments:/Conditions:

Comments:/Conditions:

INITIAL SITE SKETCH

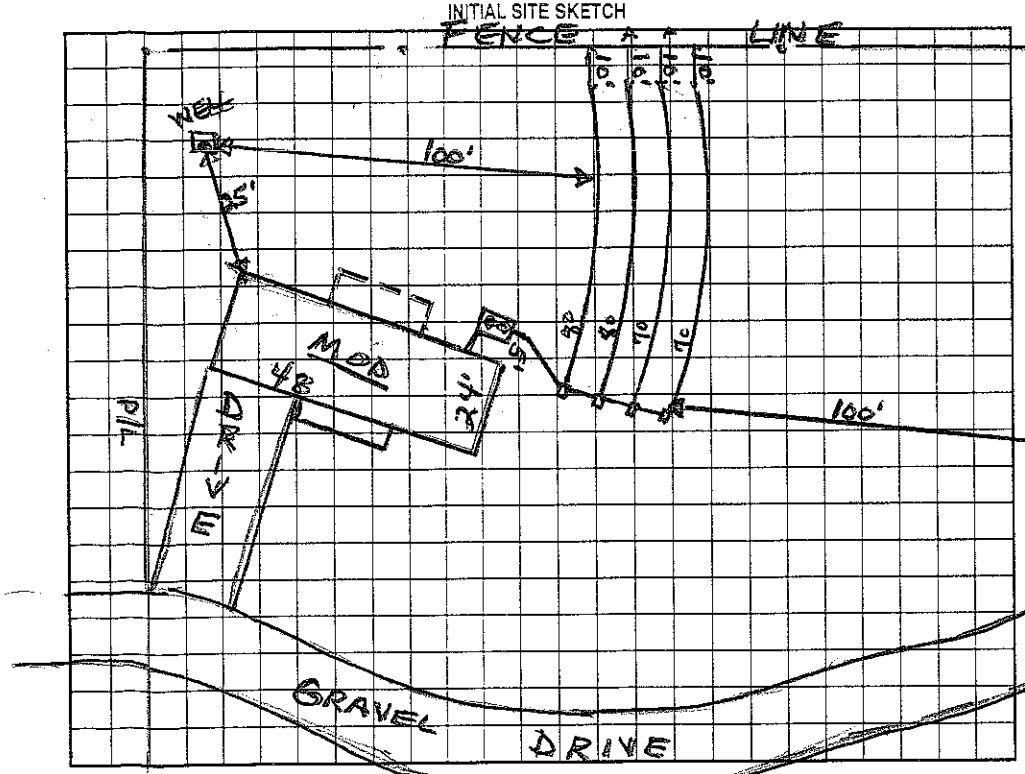

AS BUILT SKETCH

Permit can be suspended or revoked if any false information is supplied toward securing the permit/any unauthorized changes are made to the site/any unauthorized changes are made in the installation of the system. Improvement Permit with plat valid without expiration. Improvement Permit with site plan valid for sixty months. Authorization to Construct is valid for a period equal to that of Improvement Permit – not to exceed sixty months.

Signed: Mark Craft date 11-20-02 Installed by: Larry Tucker

Improvement Permit by: Wesley Sparks RS. date 11/19/02 Operation Permit by: Wesley Sparks RS. date 4/24/03

Authorization to Construct by: Wesley Sparks RS. date 11/19/02 Existing System Inspection by: date

HEALTH DEPT. COPY: WHITE OWNER COPY (FINAL): YELLOW OWNER COPY (INITIAL): PINK